

MIDSHIP SECTION.

S.S. No. 242.

SCALE $\frac{1}{2}'' = 1$ FOOT.

LENGTH B.P. = 420'-0"

BREADTH EXT. = 54'-0"

DEPTH MLD. = 29'-9"

POOP, BRIDGE & FOLE. 7'-6" ABOVE U. DECK.


CLASS: BRITISH CORPORATION B.S. *

S.S. "CRAGPOOL".

EQUIPMENT No. 5580 (APPROX.)

	2	BOWERS	68%	CWTS.	STOCKLESS.
1	"	"	58%	"	"
1	STREAM	19%	"	EX STOCK.	"
270	FMS.	2 1/2"	STUD CHAIN CABLE.	"	"
30	"	4 1/2"	S.W. ROPE, STREAM.	"	"
120	"	5"	S.W. TOWLINE.	"	"
4	@ 90 FMS.	3"	S.W. HAWKERS & WARPS.	"	"
4	" 90 "	7"	MANILLA ROPE.	"	"

STEM 9' x 2 1/2"
STERNPOST 8 1/2' x 8 1/2"
RUDDER POST 8 1/2' x 8 1/2"

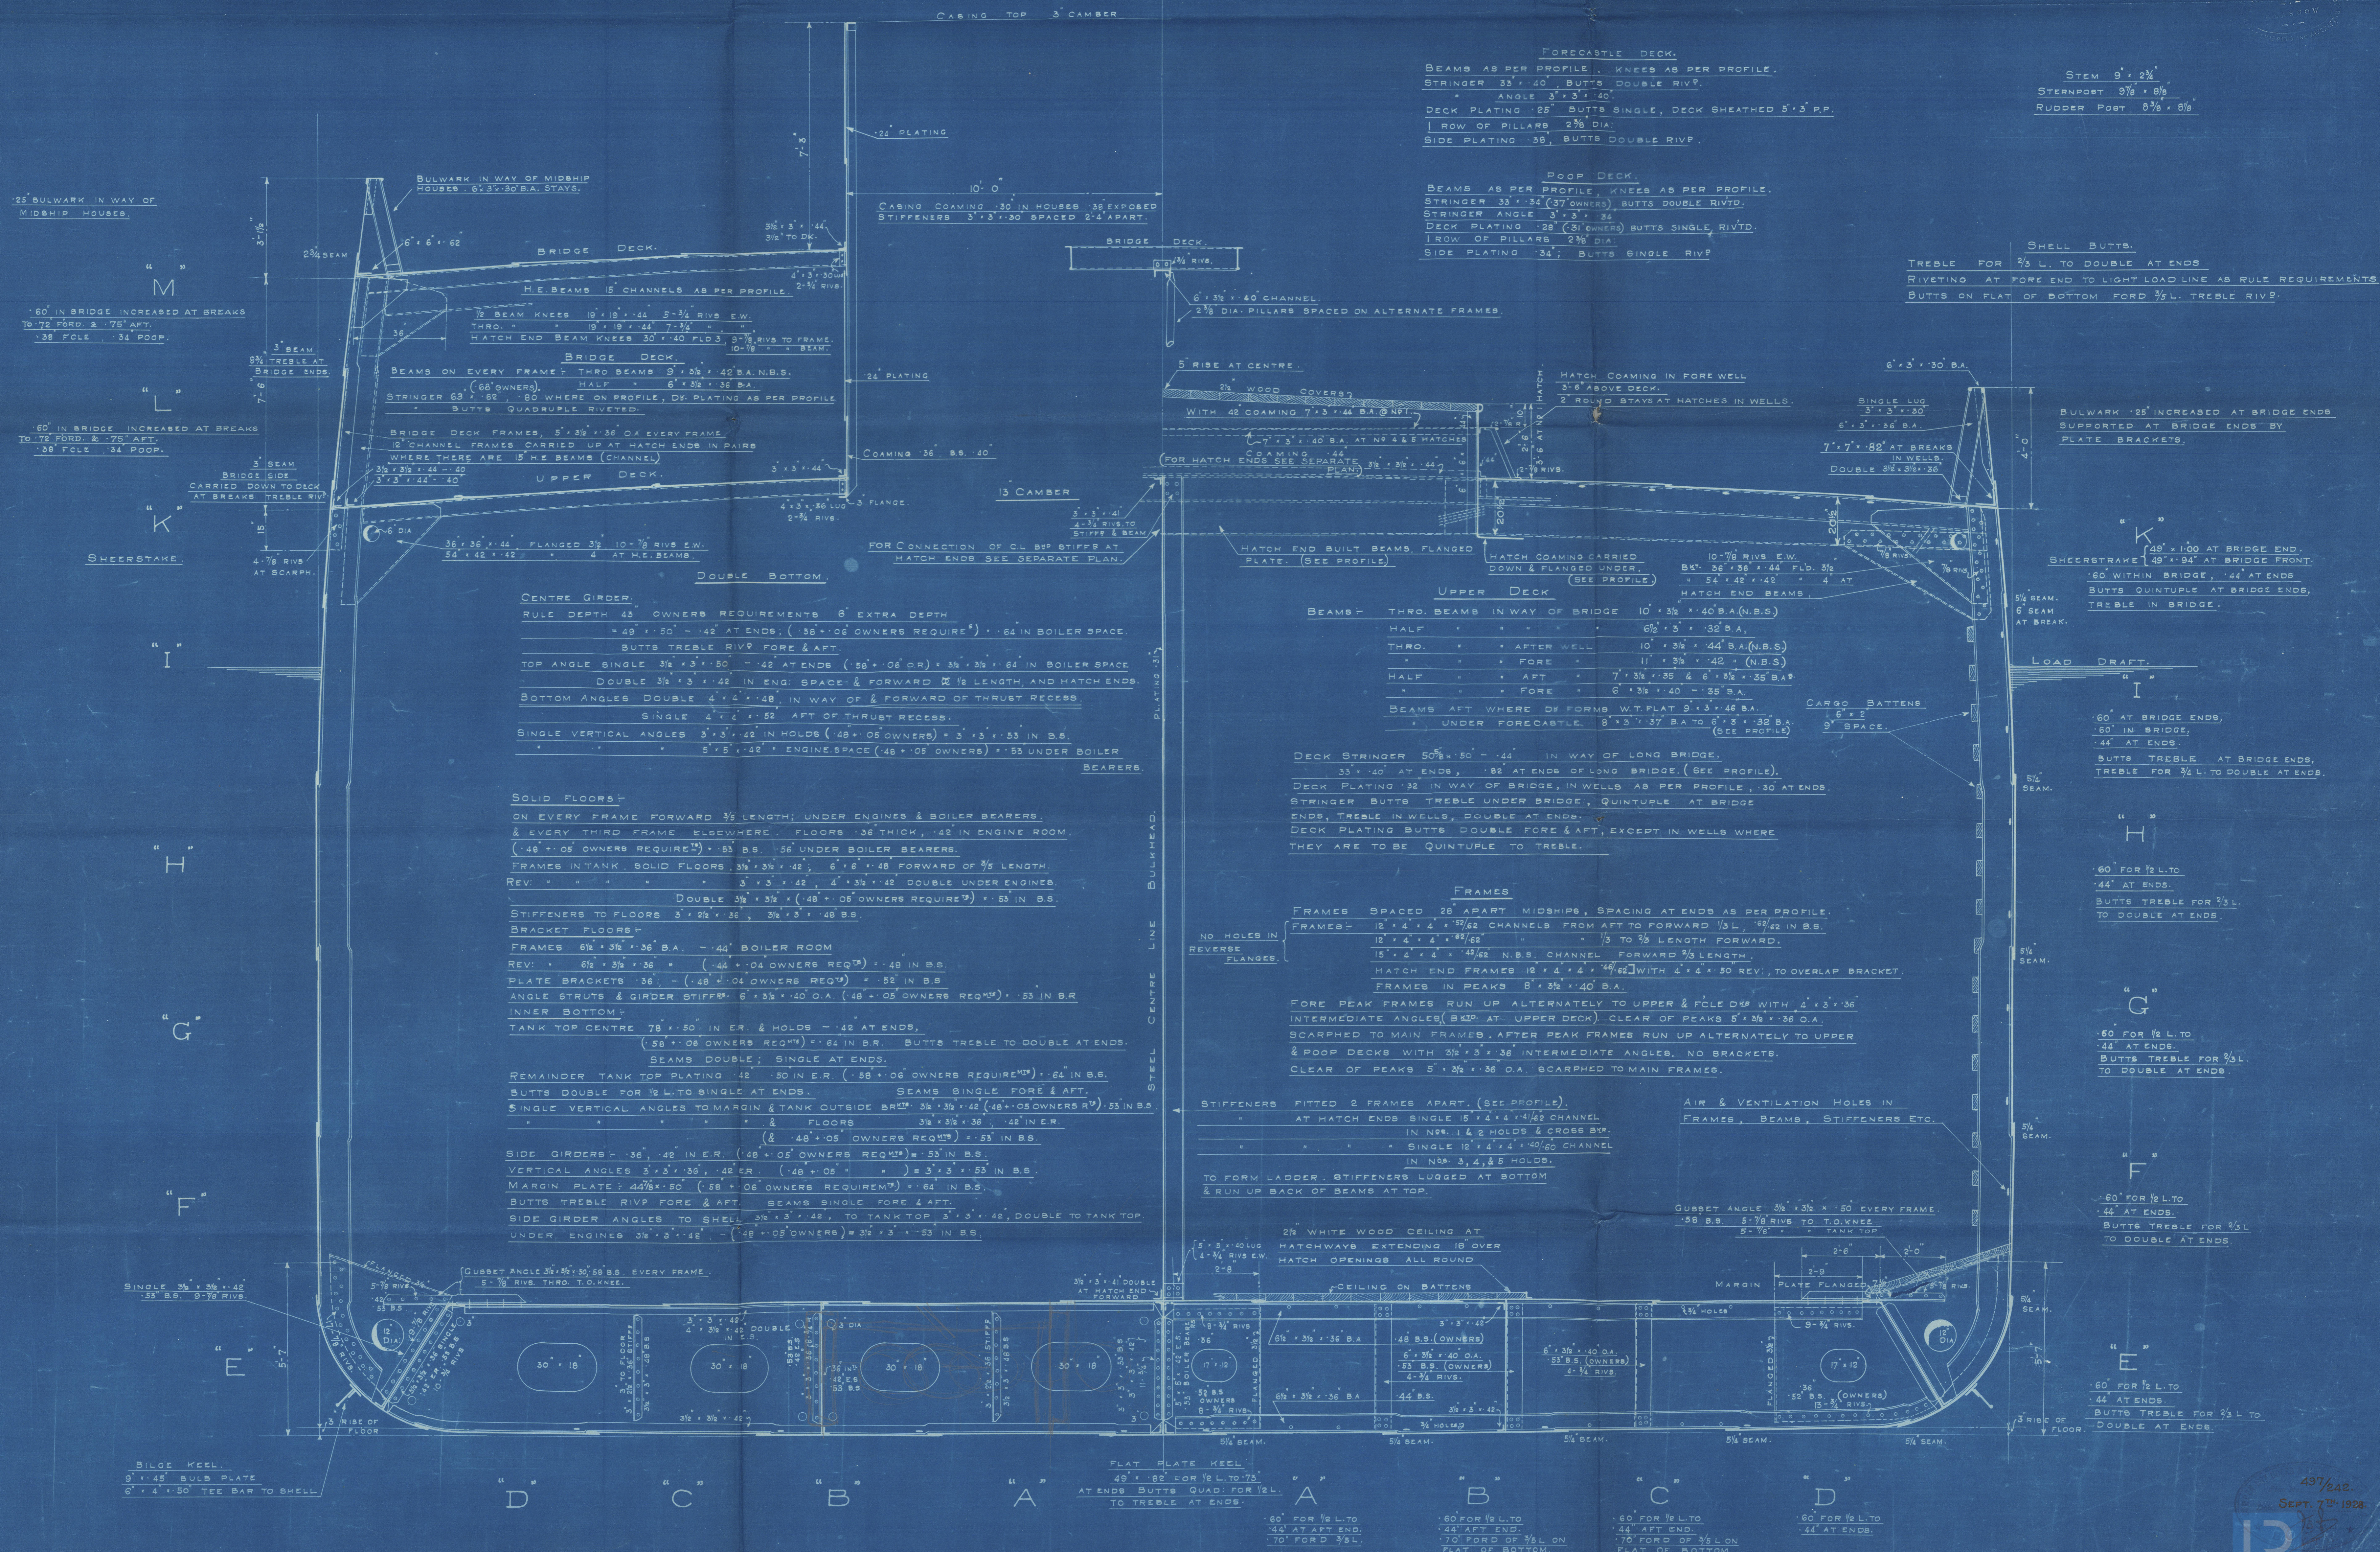

Midship Section
S. S. "Cragpool"



© 2020

Lloyd's Register
Foundation

15

Midship Section [as built.]

Cowpen G. G. No. N° 242.

Reference

S/S Leandros

S/S. ex "Bragpool"



© 2020

Lloyd's Register
Foundation

002401-002409-0139

15