

MIDSHIP SECTION.

S.S. No 243.

SCALE 1/2" = 1 FOOT.

LENGTH B.F. = 420'-0"

BREADTH EXT. = 54'-0"


DEPTH MLD. = 29'-9"

POOP, BRIDGE & FOLE. 7'-6" ABOVE U. DECK.

CLASS: BRITISH CORPORATION B.S. *

S.S. "RUSHPOOL".

EQUIPMENT			No. 5580 (APPROX.)	
2	BOWERS	68 1/2 CWT.	STOCKLESS.	
1	"	58 1/4	"	
1	STREAM	19 1/2	EX STOCK.	
270	FMS.	2 1/16"	STUD CHAIN CABLE.	
90	"	4 1/8"	S.W. ROPE. STREAM.	
120	"	8	S.W. TOWLINE.	
4 @ 90	FMS.	3"	S.W. HAWKERS & WARPS.	
4	"	80	7" MANILLA ROPE.	

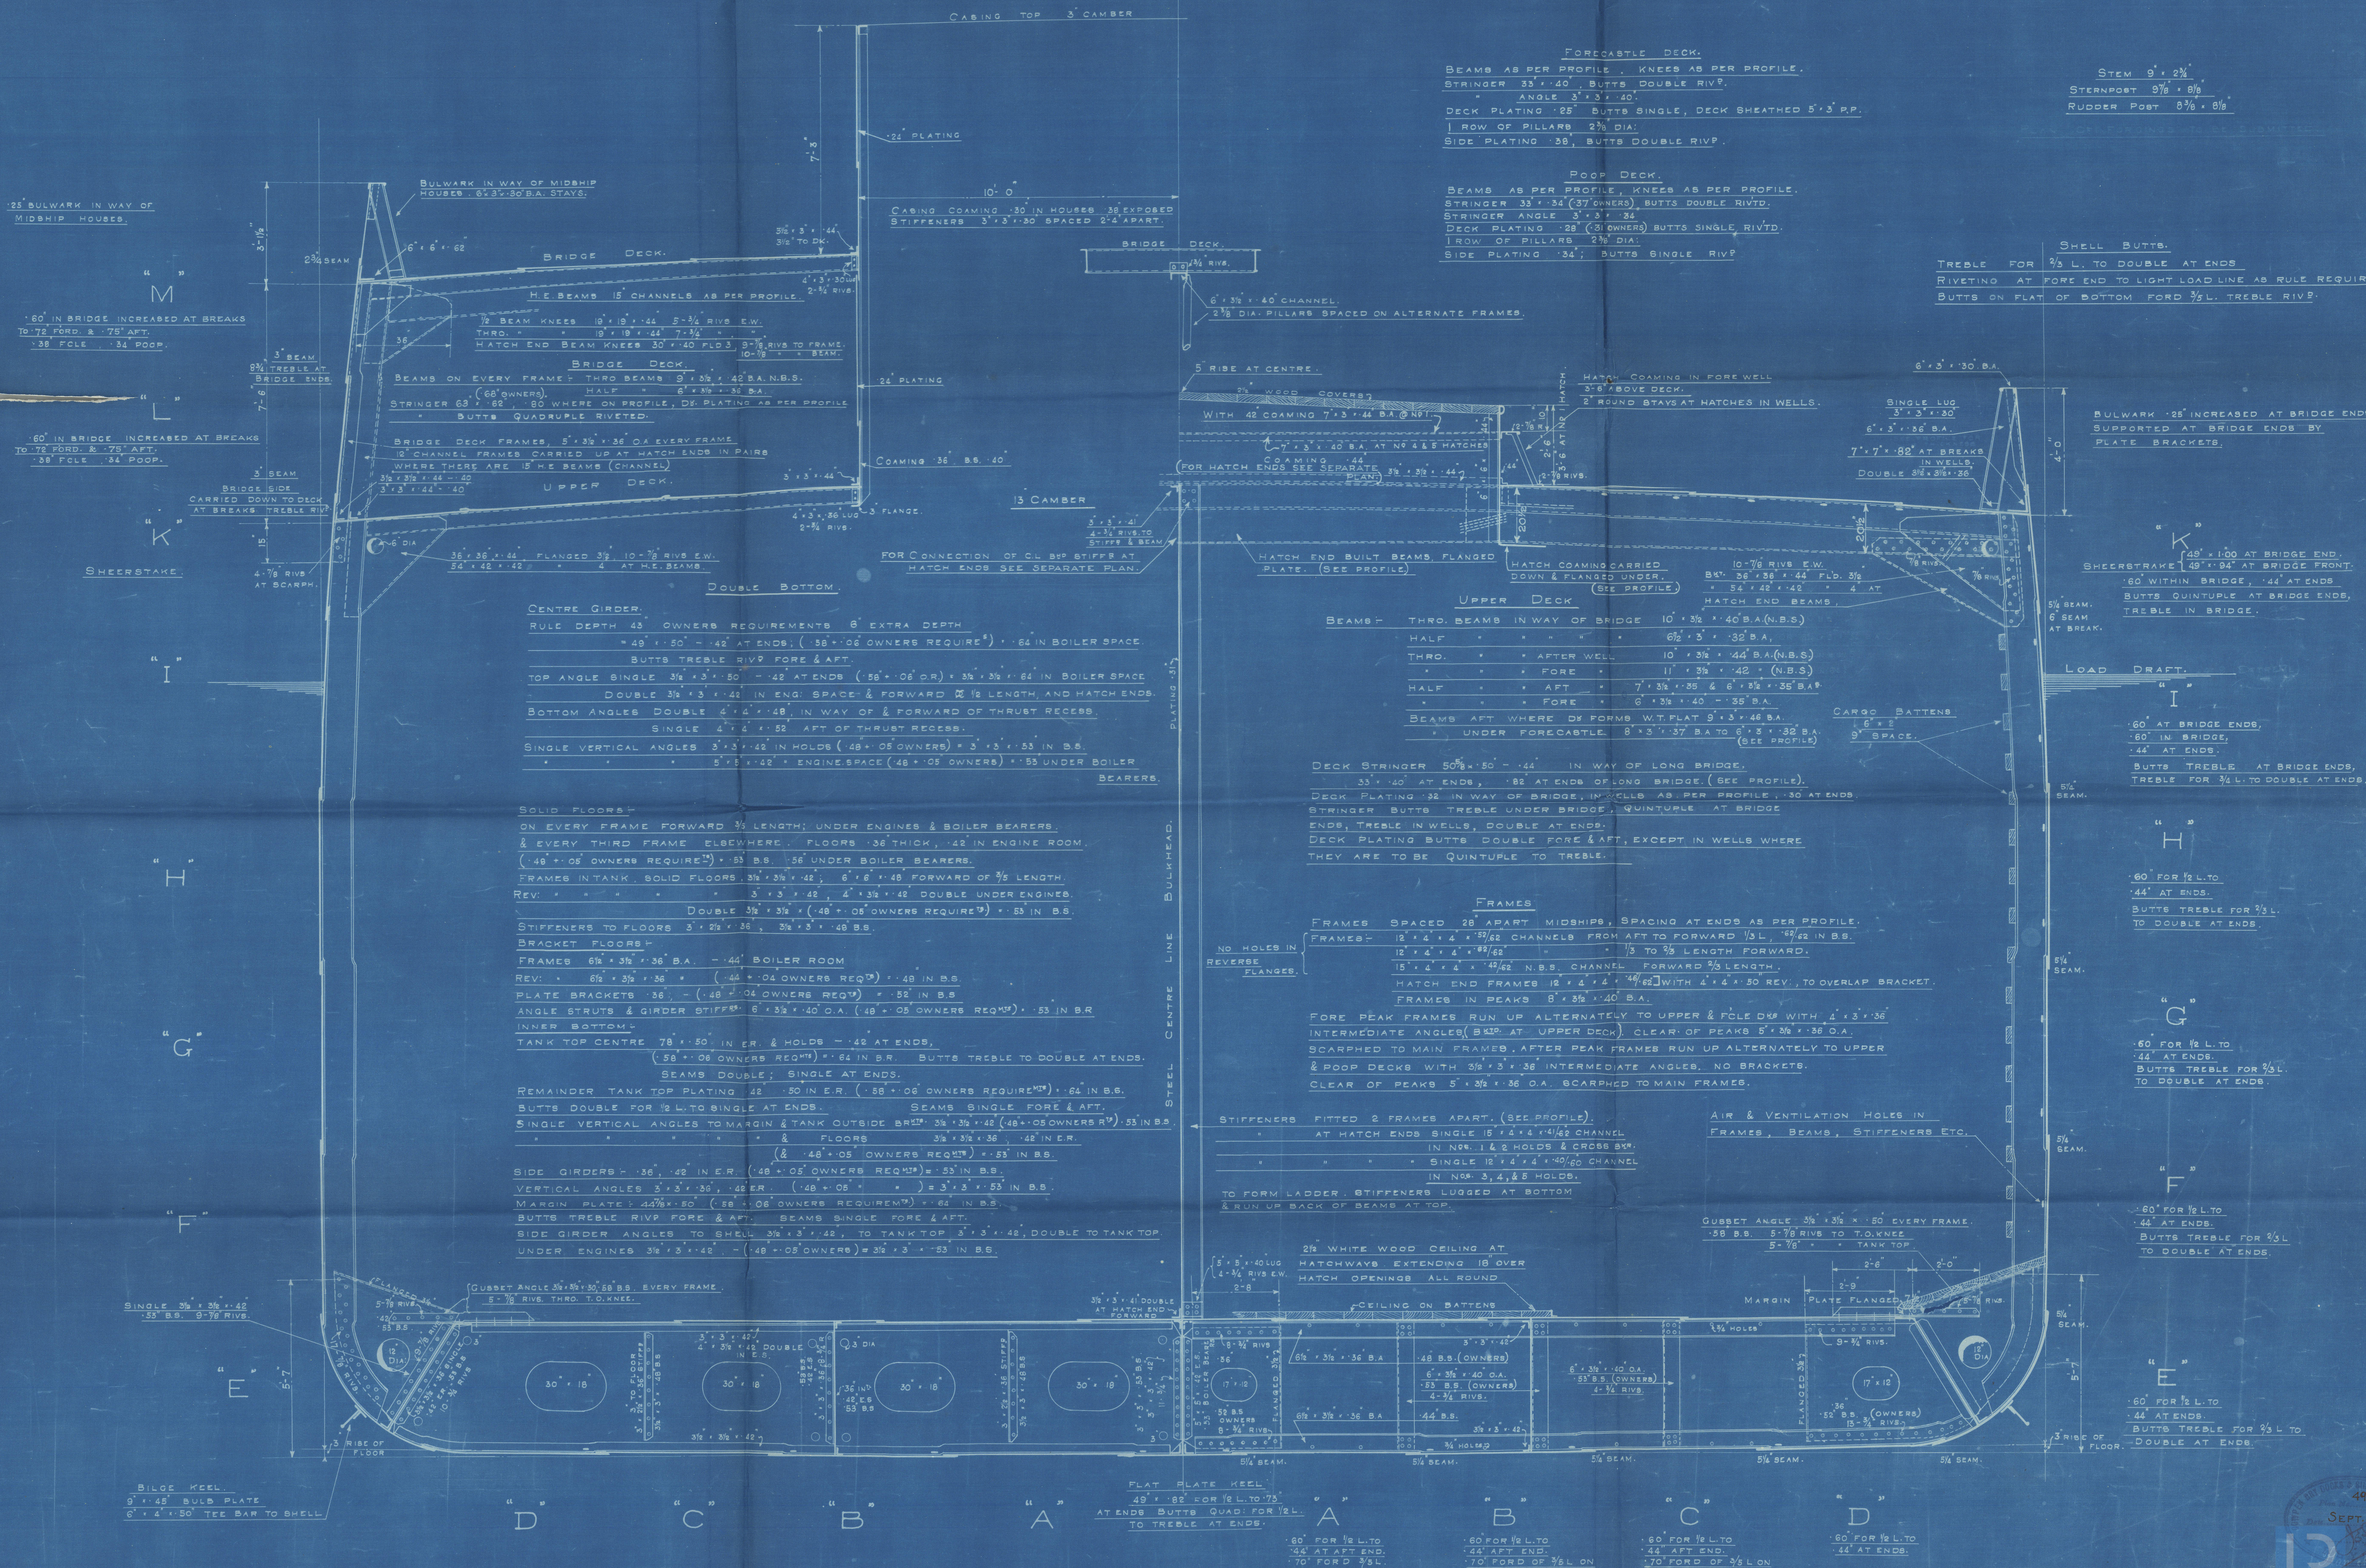

494/243
SEPT. 7th 1928

THE SHIPBUILDERS' REGISTER
FOUNDATION

Midship Section

S. S. Rusk Pool



© 2020

Lloyd's Register
Foundation

Midship Section [as built.]

Cowpen D. D. No. 243.

Reference.

$\frac{5}{5}$. "Rushpool" (Sunk)



© 2020

Lloyd's Register
Foundation

002401-002409-0141