

37039

LLOYD'S REGISTER OF SHIPPING

ALTERATIONS TO CONDITIONS OF ASSIGNMENT OF LOADLINES

Ship's Name "ADELLEN"


Official No. 164860.

Port of Registry MONROVIA.

This ship has been under survey at SOUTH SHIELDS

OR BETWEEN 31ST OCTOBER 1957 & 16TH JUNE 1958 and the following alterations to the conditions of assignment of loadlines have now been effected/~~made~~—

A COMPANIONWAY (STEEL) WAS FITTED IN LIEU OF THE ORIGINAL HATCH LEADING TO THE AUXILIARY PUMP ROOM, ON THE UPPER DECK (P.S. fwd). THE ACTUAL DECK OPENING REMAINING AS ORIGINAL.

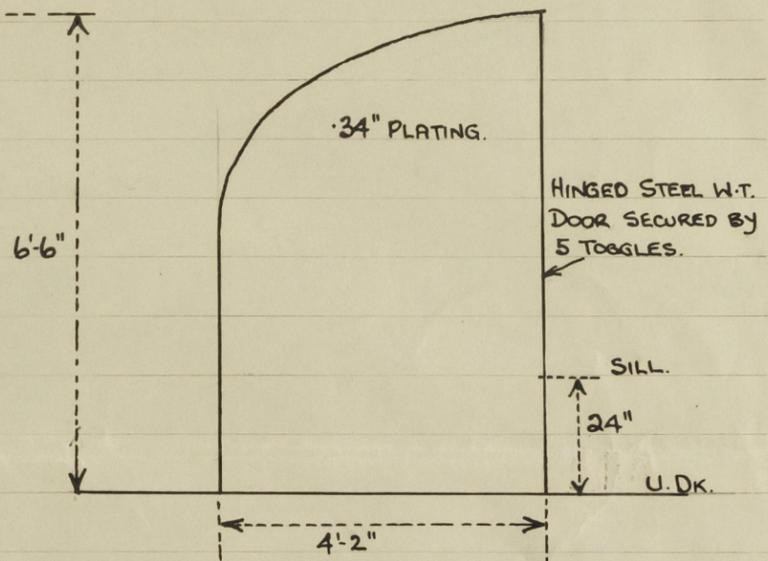

BUTTERWORTH OPENINGS :-

AN EXTRA 11 BUTTERWORTH OPENINGS NOW FITTED IN THE UPPER DECK TO MAIN CARGO TANKS, EACH 12 1/2" DIAMETER. COMPENSATING STEEL RING ELECTRICALLY WELDED TO DECK 20 1/4" OUTSIDE DIAMETER, 3 1/2" WIDE AND 1" THICK. OPENINGS CLOSED BY .75" THICK STEEL COVER PLATES 20 1/4" DIAM. SECURED O.T. BY 12 - 7/8" STEEL STUDS SPACED APPROXIMATELY 4 3/8" APART AND WITH BRASS NUTS.

J. B. Dugdale

Noted
all
29-7-58

N

