

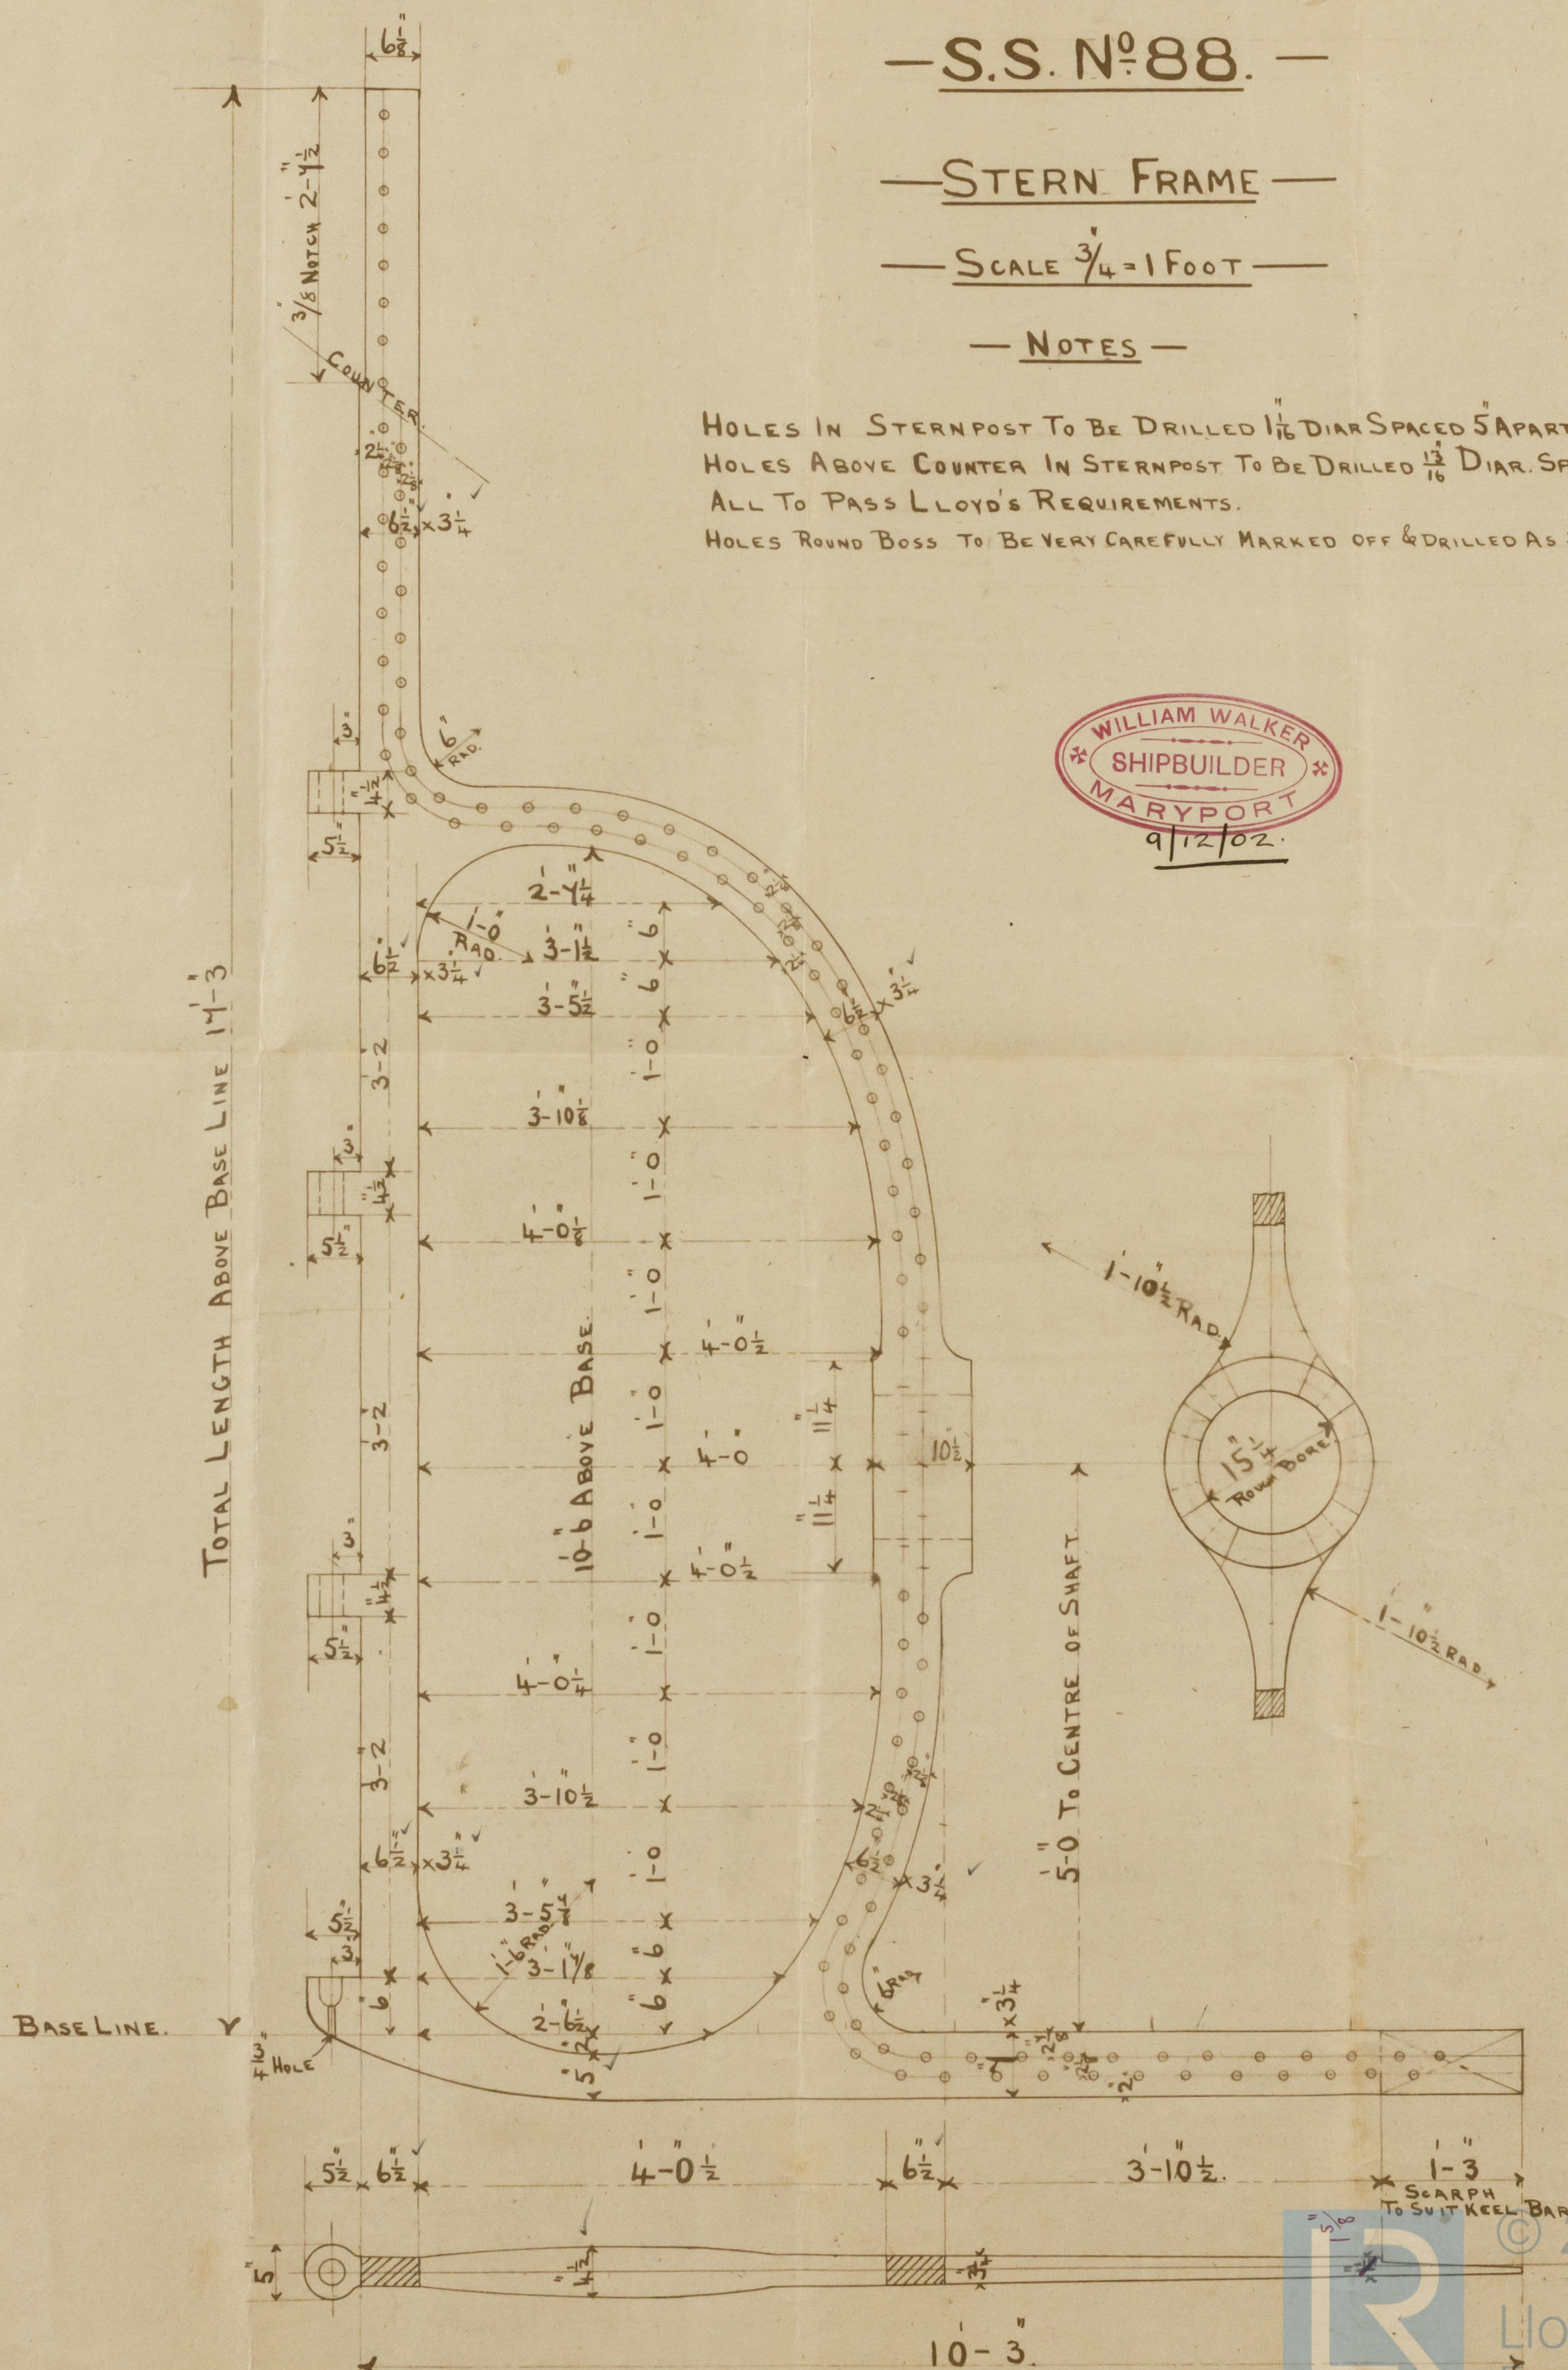


— SCALE $\frac{3}{4}'' = 1 \text{ FOOT}$ —

HOLES IN STERNPOST TO BE DRILLED $1\frac{1}{16}$ " DIAM. SPACED 5" APART C^R TO C^R. ✓
HOLES ABOVE COUNTER IN STERNPOST TO BE DRILLED $1\frac{3}{16}$ " DIAM. SPACED 4" APART C^R TO C^R.
ALL TO PASS LLOYD'S REQUIREMENTS.
HOLES ROUND BOSS TO BE VERY CAREFULLY MARKED OFF & DRILLED AS SHOWN ON ELEVATION.

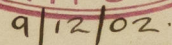

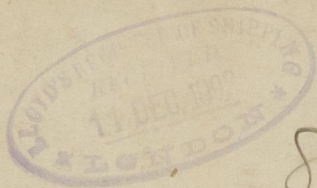


88

Mr. Walker

S.S. No 88. "AFRICA"

Shen Fane

Bow. Rpt 1225.

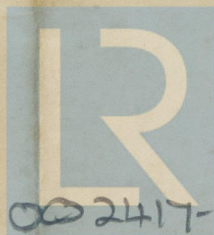

© 2020

Lloyd's Register
Foundation

002410-002417-0027