





88

W. Walker


S.S. No 88 "AFRICA"

Midship Section

Brw. Rept. No 1225

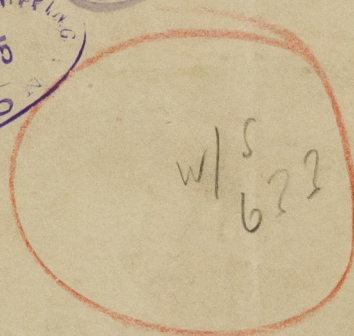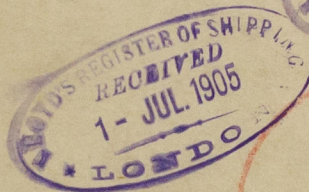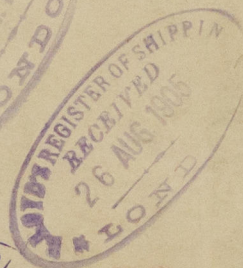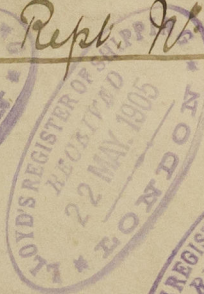

002410-002417-0028

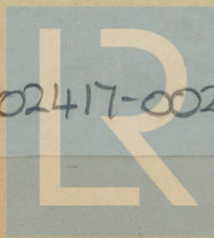

© 2020

Lloyd's Register  
Foundation

17.12  
23.5.0  
1.4.0