


13.10.23.

# S.S. Nos. 550-1.

## DECK PLANS.

270' O.L.B.P. x 37'-9" BTH MLD. x 20'-1" DTH MLD.

SCALE = 1/8" = 1 FOOT.

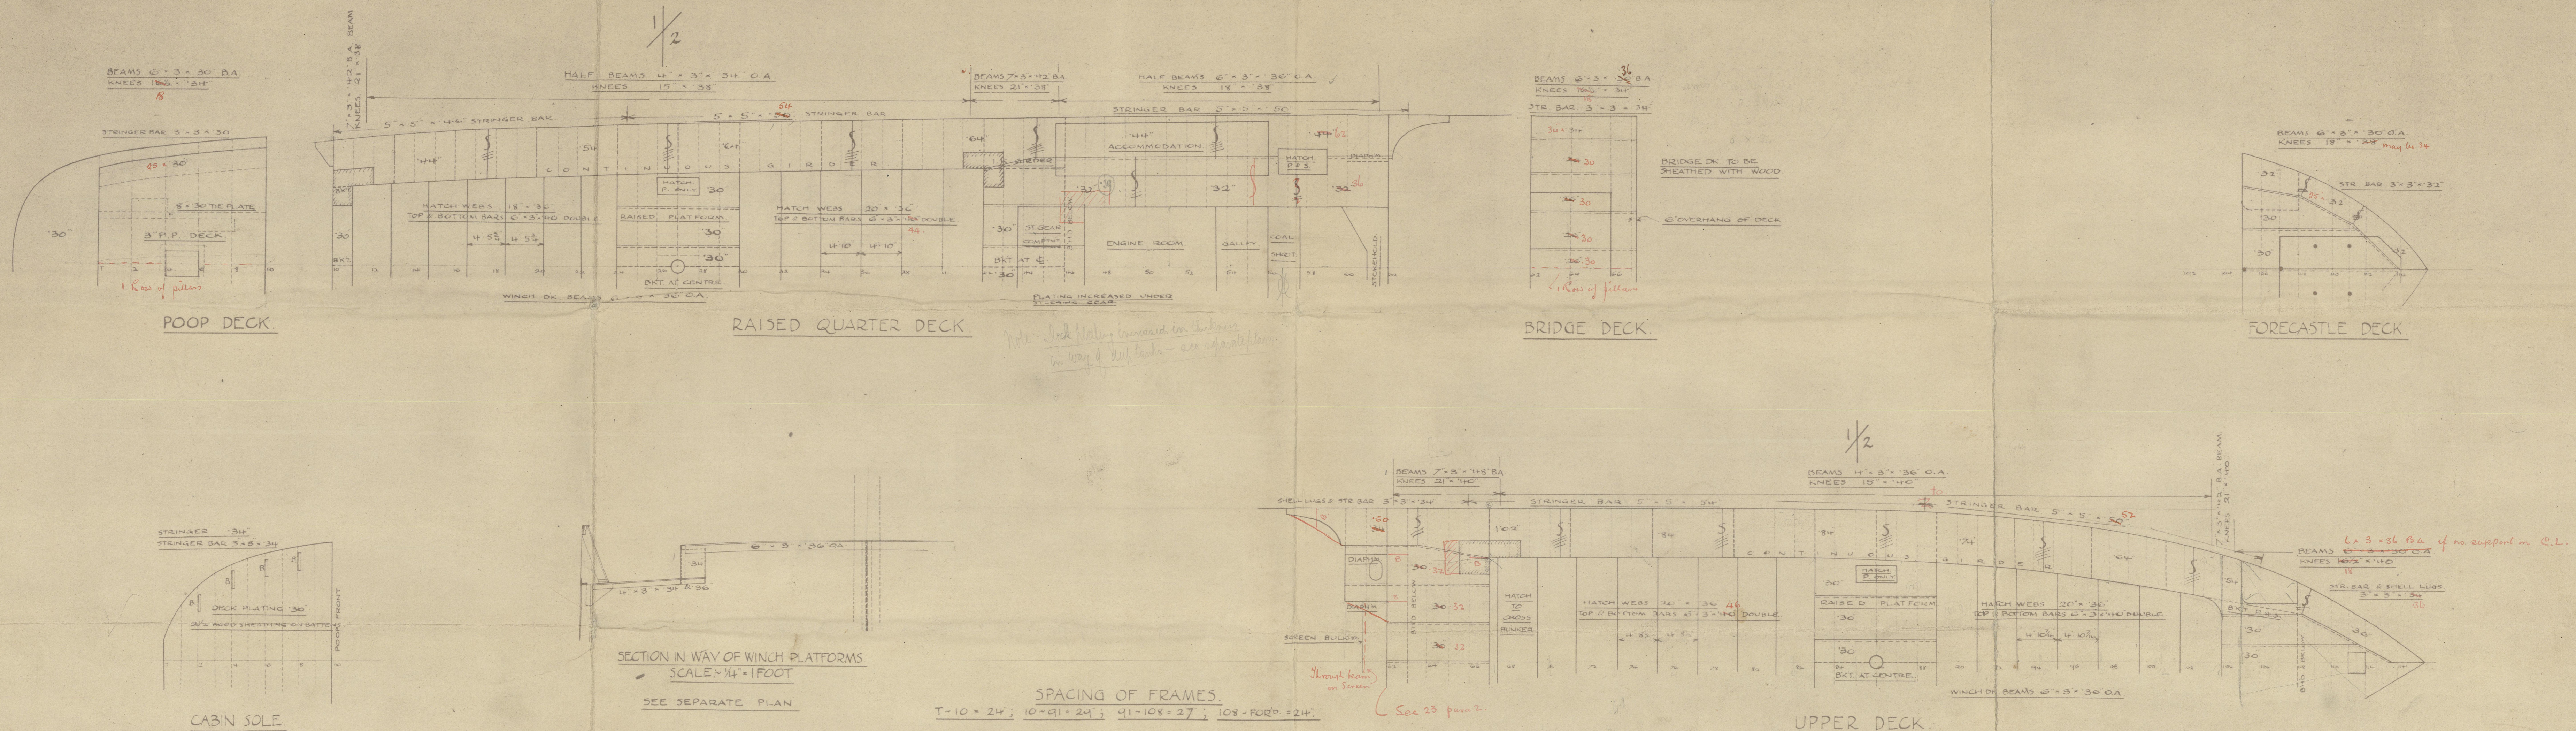

13.10.23.

8851  
550-1 Amended  
10-10-23

SUNDERLAND

(8)

MEISSR) J. L. THOMPSONS & SONS

DECK PLANS

S/S NOS 550 & 551

~~(ALTERNATIVE PROPOSAL)~~  
Bruce M

EX

# BYRNESS N° 550

SUNDERLAND RPT. NO. 29371

# RAMSHOPE N° 551

SUNDERLAND RPT. NO. 29372

NN "INVER"



© 2020

Lloyd's Register  
Foundation

002410-002417-0058