

LLOYD'S REGISTER OF SHIPPING

UNITED WITH THE BRITISH CORPORATION REGISTER

ALTERATIONS TO CONDITIONS OF ASSIGNMENT OF LOADLINES

Ship's Name " AHERN TRADER " Official No. 146138


Port of Registry Belfast

This ship has been under survey at HALIFAX N.S.

on 22nd & 23rd March, 1956 and the following alterations to the conditions of assignment of loadlines have now been effected/found:—

TONNAGE WELL

The normal closing appliances to tonnage hatch on upper deck removed, and a separate oil tank fitted within opening, extending from freeboard deck to above upper deck. The space at upper deck (about 3" all around) between hatch coaming and oil tank fitted with wood covers 2½" thick, suitably supported. No alterations made to tonnage hatch coamings. Fore and aft bulkhead at sides of tonnage well removed p & s.

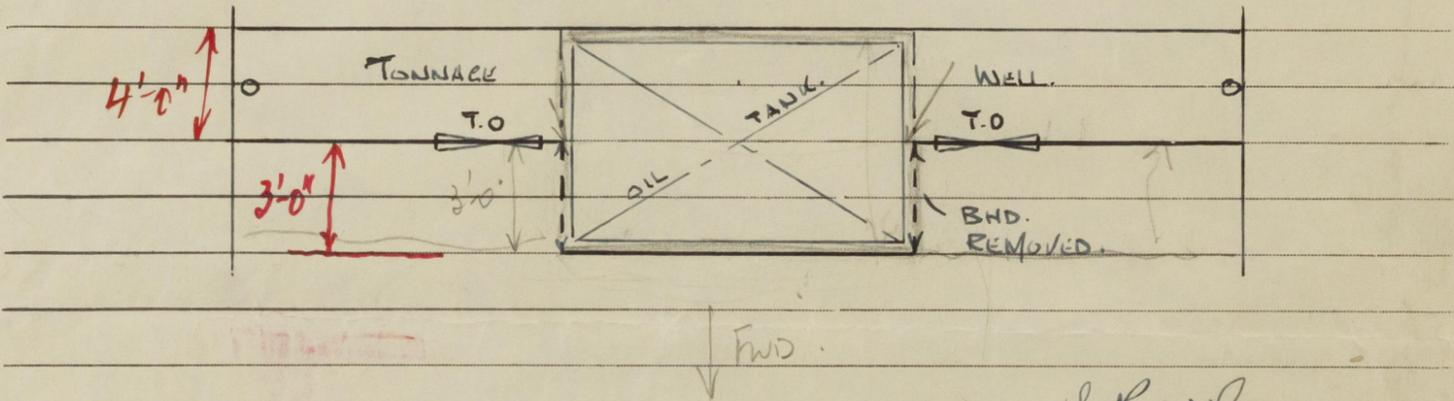

S. R. Wilson
SURVEYOR TO LLOYD'S REGISTER
(S.R. WILSON)

The old coaming hatch in the tonnage well has been removed and the deck put over

*Noted
all
12.4.57*

This should be brought up to date

A copy of this Report has been placed on board.