


PROFILE & DECK PLANS

S. S. MOTOR SHIP N° 1171

400' (B.P.) x 52' x 31' MLD.

SCALE 1/8" = 1 FOOT.  
TO CLASS B.S.

*Approved  
See Section 26-9-24*

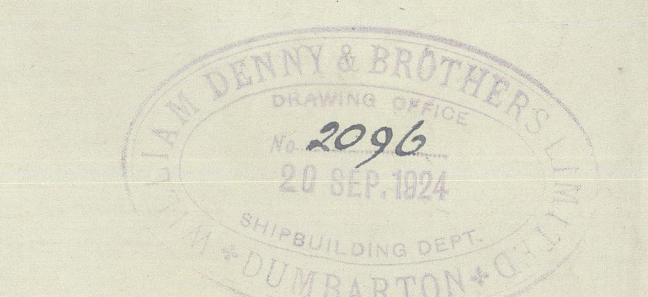



Denny's 1077

Bag

Proper ref

T.C. 19/11/24

DENNY BROS.

1141

Profile & dks

N/N "ANTH"

26-2-24

EX  
Graphic Star

EX  
m/s "Yamah"

2

002418-002426-0003



© 2020

Lloyd's Register  
Foundation



211



© 2020

Lloyd's Register  
Foundation