

EXT Nwc.
6/9/32

JUL 13 1923

Index No. 309419
(For London Office only.)

Lloyd's Register of Shipping.

SURVEYS FOR FREEBOARD.-STEAM SHIPS.

No 42868.

REGULATIONS RELATING TO ALL STEAM SHIPS WHICH ARE FLUSH DECKED OR WITH GALLANT FORECASTLES, SHORT POOPS AND BRIDGE HOUSES DISCONNECTED, OR WITH GALLANT FORECASTLES HAVING LONG POOPS OR RAISED QUARTER DECKS CONNECTED WITH BRIDGE HOUSES, OR OTHERWISE.

Port of Survey Glasgow
Date of Survey 2nd July 1923
Name of Surveyor George Nicol

Ship's Name Barelay Line Coy N° 600
S.S. "INVELLA"
Number in Register Book not stated
Port of Registry and Nationality not stated
Official Number 147914
Gross Tonnage ✓
Date of Build 1923
Particulars of Classification 100. A.1. (Class contemplated)

Registered dimensions from Ship's Register.	LENGTH.	BREADTH.	DEPTH.	UNDER DECK TONNAGE.
	<u>400.1</u>	<u>52.25</u>	<u>28.5</u>	<u>4742.53</u>
Length on LOADLINE.	<u>399.5</u>	Frame Depth <u>11</u> Rule <u>6</u> <u>5.3</u> drop <u>10</u> <u>- .84</u>	Ceiling <u>+ .20</u> Sheer <u>+ 1.11</u> <u>3</u> drop <u>10</u> <u>+ .12</u>	Peak Tanks
CORRECTED DIMENSIONS.	<u>399.5</u>	<u>51.41</u>	<u>29.93</u>	<u>4742.53</u>

Moulded Depth as measured.....31'-0"

NOTE. - If the depth is measured when vessel is afloat, the details of measurement should be reported.

Addition for Keel below base line for draught record.....2 1/2 inches.

CORRECTION FOR LENGTH.

Length of Ship on Loadline...399.5
Length in Table372.0
Difference27.5
Correction for 10ft., Table A.1.6
× Difference divided by 104.4
If 1/10 the length covered divide by 2 + 4.4

Table C. .80
(if required.) 2.2
+ 2 1/4

CORRECTION FOR IRON DECK.

Proportion covered, if less than 1/10 the length covered506
Thickness of usual wood deck, less stringer3 1/2

- 1 3/4

CORRECTION FOR ROUND OF BEAM.

Breadth at Gunwale amidships.....52
Round of Beam13
Normal round.....13
Difference✓ ÷ 2 =✓
Proportion of Deck uncovered (Para. 19)

NOTE. - The round of beam should be reported on the full breadth of vessel at the gunwale.

Co-efficient of fineness.....
Any modification necessary {
[Para. 4 (a) to (e)]*
Co-efficient as corrected

4742.55
399.5 × 51.41 × 29.93
C.D.B.
.75

Sheer { Stem.....120
at { Sternpost...60 } 180 ÷ 2 = 90 Mean 36 / 40.05
1.11

Sheer at 1/2 of the length from { Stem 66
Sternpost 33 } 99 ÷ 2 = 49.5 Mean 4.55 = 90.0

Gradual mean Sheer90
Standard mean Sheer [Table, Para. 18]49.95 Correction
Difference.....40.05 ÷ 4 = - 10

§ If limited as Para. 18 (f)

Rise in Sheer { At front of bridge house.....
from amidships { At after end of forecastle

¶ Fall in Sheer {
Para. 18 (d) { ÷ 2 =
Length uncovered Correction

ALLOWANCE FOR DECK ERECTIONS :-

Freeboard, Table C.....4'-9"
Correction for Length, if required (Para. 12, 18, and 14).....+ 2 1/4

Freeboard by Table A. corrected for sheer, and for length, if required (Para. 12, 18, and 14).....4'-11 1/4"
Difference2'-5 3/4"

Percentage as below.....32.53 %

Correction for R. Q. Dk. if engine and boiler openings not covered by bridge house (Para. 11)
Allowance for Deck Erections

	Length.	Length allowed.	Height.
Forecastle.....	<u>45'-3 1/2"</u>	<u>45.29</u>	<u>7'-11 1/2"</u>
Bridge House	<u>120'-7"</u>	<u>120.36</u>	<u>"</u>
✓ Raised Q. Dk.....	<u>36'-9"</u>	<u>36.75</u>	<u>"</u>
Poop.....	<u>36'-9"</u>	<u>36.75</u>	<u>"</u>
Total		<u>202.40</u>	<u>= 506 1/2</u>
Length of Ship		<u>399.5</u>	

Corresponding percentage {
(Para. 11, 12, 18, or 14) 32.53

FREEBOARD recommended amidships from centre of Disc to top of Statutory Deck Line, Wood (Iron) Deck :-
Fresh Water Line above centre of Disc
Indian Summer Line " " "
Winter Line below " "
Winter North Atlantic Line " " "

4 JUL 1923

¶ If the frames, skin planking, or ceiling are of unusual thickness the breadth of vessel to inside of ceiling should be reported if possible.
† In vessels obtaining an allowance for deck erections under Para. 11 where the sheer drops abaft amidships the height of the R.Q.D. is to be taken from the level of the top of the amidship beam.
§ In flush-decked vessels the total standard mean sheer means the sheer measured at the stem and sternpost. In vessels having poops and forecastles, it means the sheer measured at points distant one-eighth of the vessel's length from stem and sternpost.

Correction necessary because clearside amidships, measured in accordance with the Statute is not taken at the intersection of the wood or iron deck with side.

Winter Freeboard6'-5 1/2"
Summer Freeboard6'-0"
Indian Summer Freeboard5'-8 1/2"
N. A. Winter Freeboard

Winter Freeboard from deck line6'-7 1/4"
Summer " " "6'-1 3/4"
Indian Summer " " "5'-8 1/4"
N. A. Winter " " "6'-12"

† State dimensions of freeing port area on back of this form.
‡ The Surveyor should state whether the fall in sheer as reported is measured relatively to the straight line of keel or to the water line. If measured relatively to water line the vessel's draft at time of survey, and also the usual load draft forward and aft should be reported.

Lloyd's Register
MARKING FORM
23 JUN 1924
RECEIVED

Do all the Frames extend to the top height in the Poop? *yes* Raised Quarter Deck? *yes* Bridge House? *yes* Forecastle? *yes*
 To what height do the Reverse Frames extend? *across floors in double bottom*
 Has the Poop or Raised Quarter Deck an efficient Iron Bulkhead at the fore end? *yes*
 Give particulars of the means for closing the openings in Bulkhead *Shifting boards full height in truss*
 Is the Poop or Raised Quarter Deck connected with the Bridge House? *no* Has the Bridge House an efficient Bulkhead at the fore end? *yes*
 Give particulars of the means for closing the openings in Bulkhead *no openings*
 What is the thickness of the Bridge Front plating? *40* and Coaming plate? *44*
 Give scantlings and spacing of the Stiffeners *8 x 3 1/2 x 64 Bulk angle, 30" apart*
 Are bracket plates fitted at each end of the Stiffeners? *yes* Are hor'l. brackets fitted connecting Bridge Bulk'd. with Bulwarks? *yes*
 Has the Bridge House an efficient Iron Bulkhead at the after end? *yes*
 How are the openings closed? *Shifting boards full height in trussed channels*
 Is the Forecastle at least as high as the main or top-gallant rail? *yes* Has the Forecastle an efficient Iron or Wood Bulk'd. at after end? *yes*
 Are the Engine and Boiler openings covered by a Bridge, Poop, Raised Quarter Deck, or enclosed by a Strong Iron or Steel Deckhouse? *covered by bridge deck*
 If the openings are not so protected are the exposed parts of the Casings efficiently constructed? *yes*
 Give thickness of plating; scantlings and spacing of Stiffeners *yes*
 What is the height of the exposed Casings? *yes* Are suitable means provided for closing all openings in them in bad weather? *yes*
 Are the Weather Deck Hatchways efficiently constructed and at least equal to the requirements of Section 28 of the Rules for 1904-5? Give particulars below: *yes*

Position and Size.		N. 1, 36'-3" x 18'		N. 2, 33'-0" x 18'		N. 3, 12'-0" x 18'		N. 4, 33'-0" x 18'		N. 5, 30'-0" x 18'	
Item.		Ship.	Rule.	Ship.	Rule.	Ship.	Rule.	Ship.	Rule.	Ship.	Rule.
COAMING.	Height above top of DECK	30"		30"		30					
	Sides	44		44		44		Same as N. 1		N. 1	
	Ends	44		44		44					
SHIFTING BEAMS OR WEB PLATES.	Number	5		5		5		5		5	
	Section and Scantlings	1 1/2 x 8 x 34		1 1/2 x 8 x 34		1 1/2 x 8 x 34		Same as N. 2		1 1/2 x 8 x 34	
	Material	4 A. 4 x 3 x 44 Steel		4 A. 4 x 3 x 44 Steel		4 A. 4 x 3 x 44 Steel		N. 2		4 A. 4 x 3 x 44 Steel	
* FORE AND AFTERS.	Number										
	Section and Scantlings										
	Material										
HATCHES Thickness		3 Pm									
Remarks											

* The depth of Fore and Afters should be stated from the underside of the hatches in all cases.

(If the sill of the lowest side scuttle will be less than 6 inches above the Indian Summer Load Line if assigned under the tables, state vertical distance from top of deck at side amidships to lower edge of lowest side scuttle.)

The following information is to be given in all Cases of vessels dealt with under Paras. 11, 12 (under 15 feet Moulded depth) and under Shelter Deck Rules.

What is the thickness of the Bridge Sheerstrake?

Strake between Main and Bridge Sheerstrakes?

Delete the words { The Crew are, are not, berthed in the bridge house.

that do not apply { The arrangements to enable them to get backwards and forwards from their quarters are, are not satisfactory.

Length of Bulwarks in well

Area of Freeing Ports required by Para. 11 (e) each side of vessel =

Sq. ft.

Ft. Tenths. Ft. Tenths. No.

x x


Freeing Ports (each side of vessel) =

Sq. ft.

x x

Total deficiency or excess =

Sq. ft.

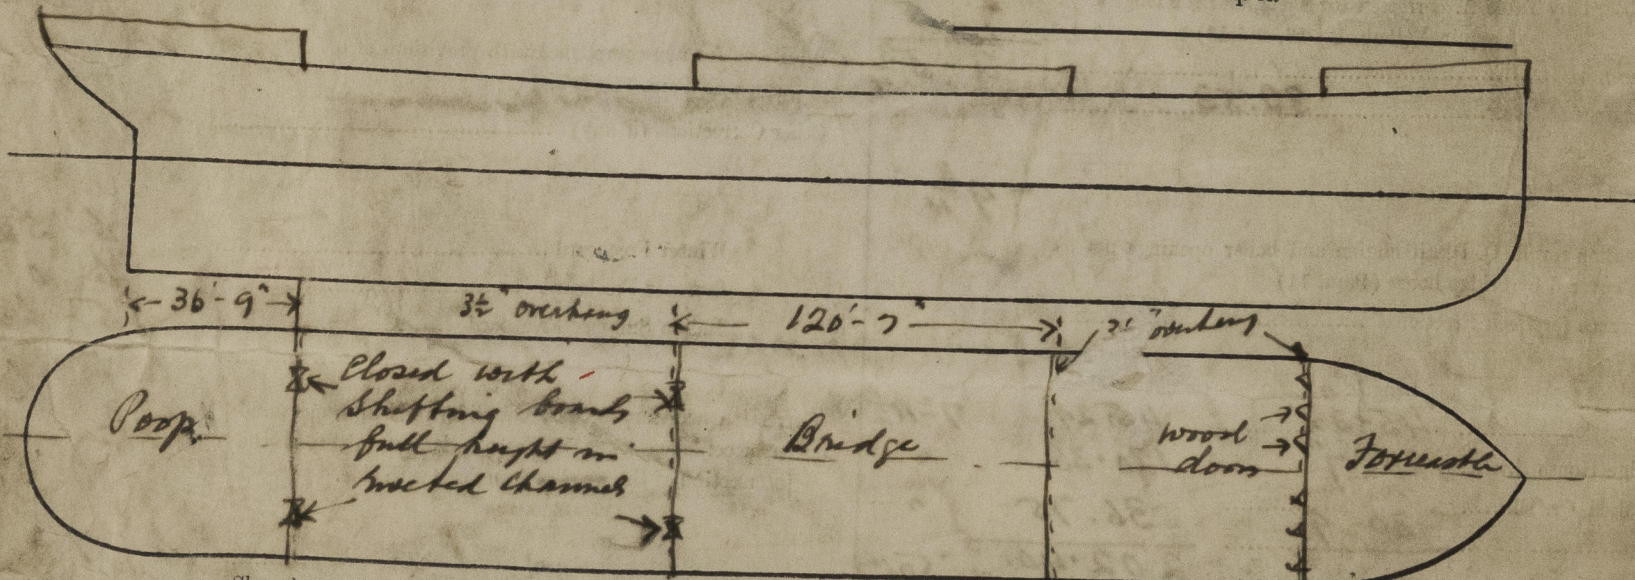

Show hereon line of Floors or Tank Top with position of any Breaks in same; also height of Peak Tank tops, &c., &c.

State any special features in the construction of the Vessel

Request form N. 9 enclosed herewith

Also approved sketches of midship section and profile

Vessel is a duplicate of the S.S. Olympia (Lib. Regt. N. 40042) and S.S. Macdonald (Glasgow Regt. N. 40668) Owners not stated

Address

100 11 0 0

Received by me Lee J. E. Report



Lloyd's Register Foundation