
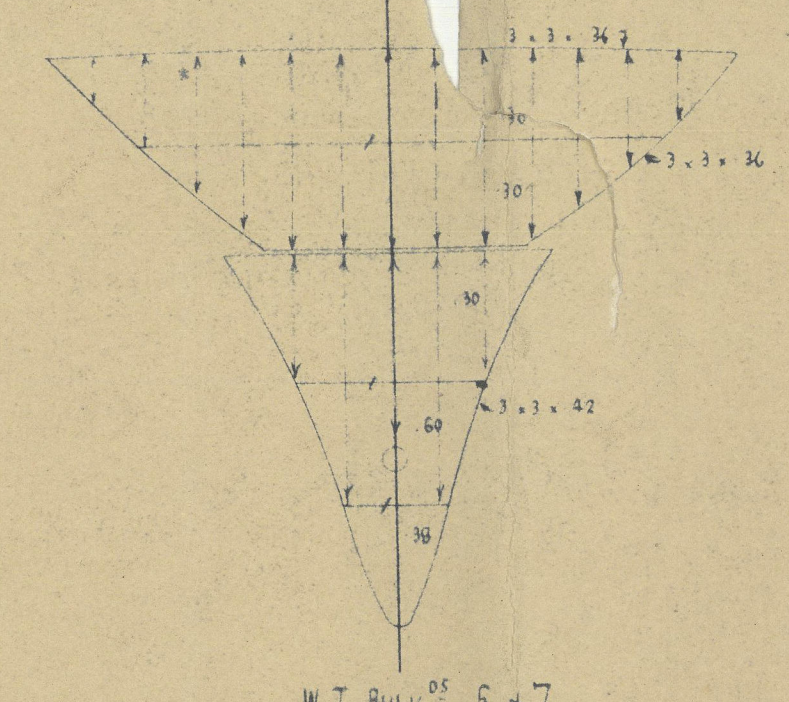


8-8-29


SHIP NO 569. PROFILE & DECK PLANS. TO CLASS 100 A. I. AT LLOYDS.

SCALE $\frac{1}{8}'' = 1'-0''$

DIMS 241'-0" G.P. x 38'-0" B.M.D. x 21'-0" D.M.D.

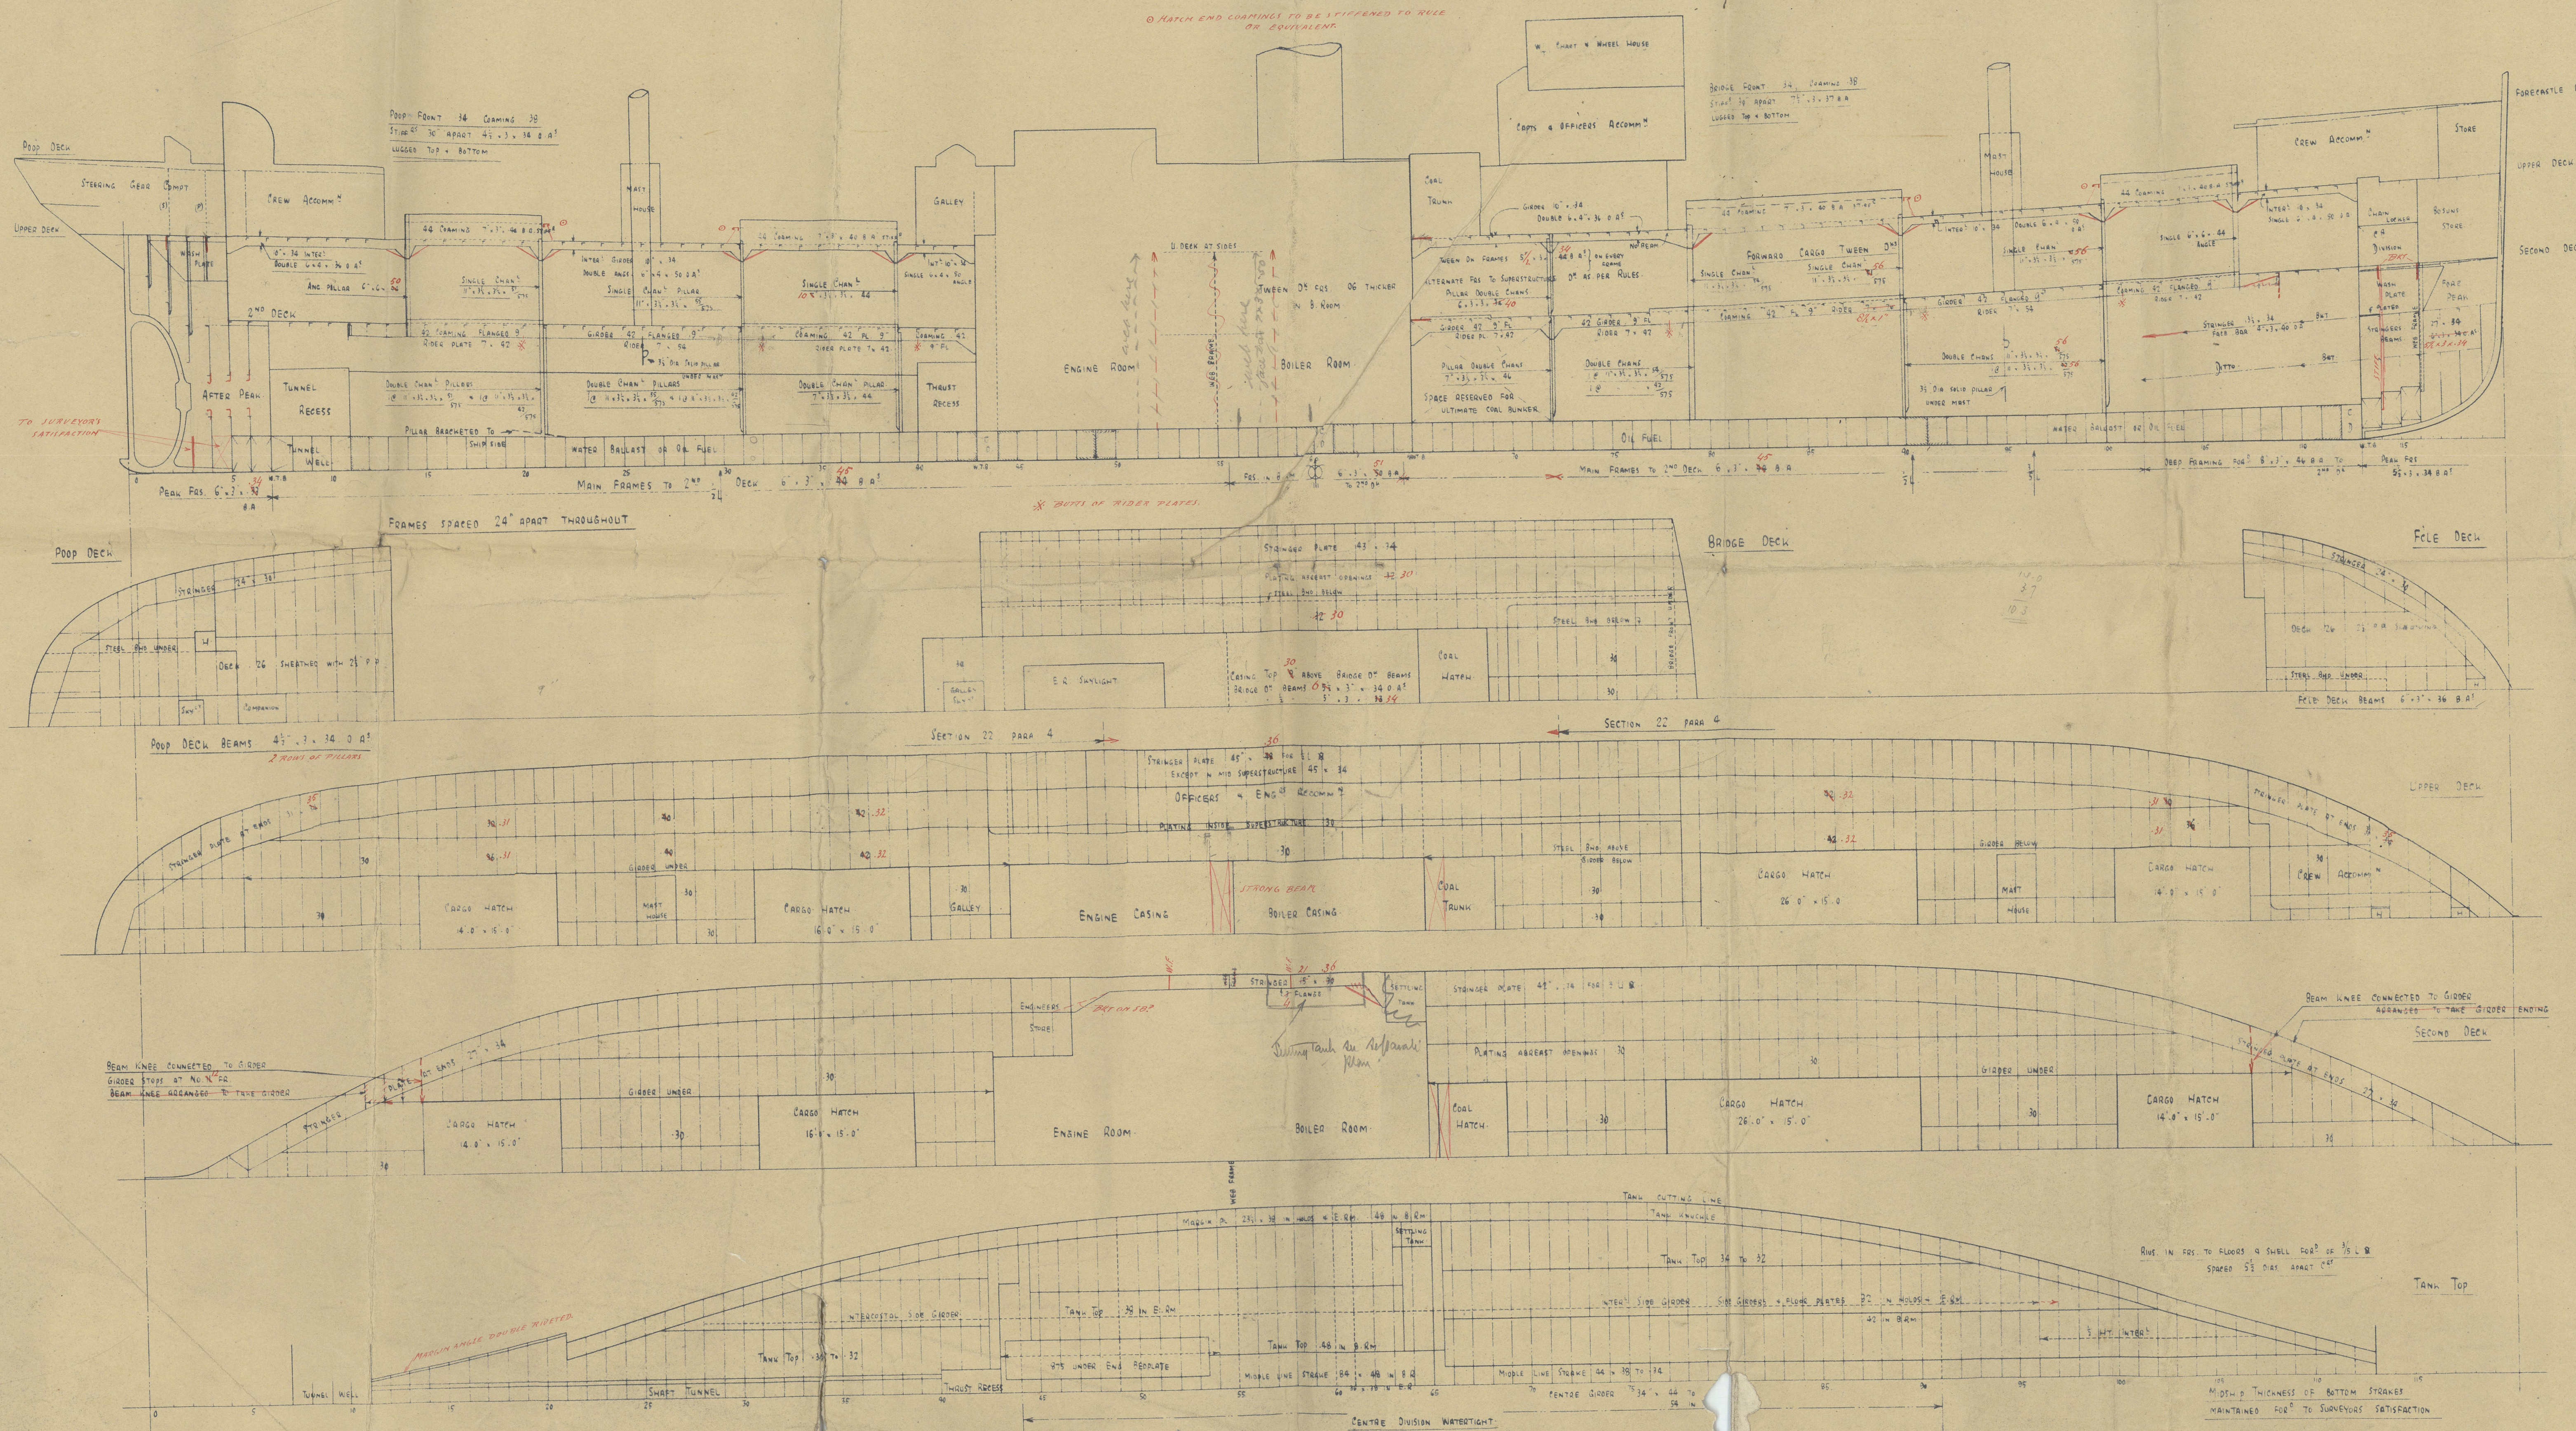


W.T. BULL. 5 x 7
STIFF 2' 0" APART BELOW 2ND DECK 6' 3" x 36' 8" A.
ABOVE 2ND DECK 6' 3" x 36' 8" A.

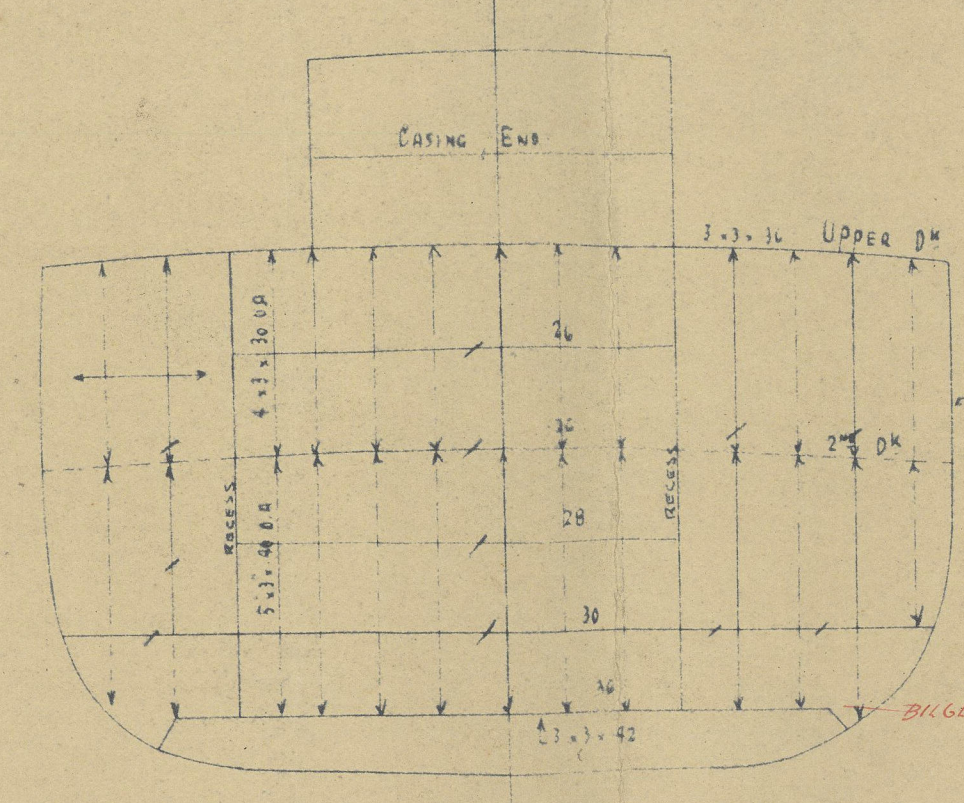


No 43 W.T. BULLHEAD (RECEIVER)


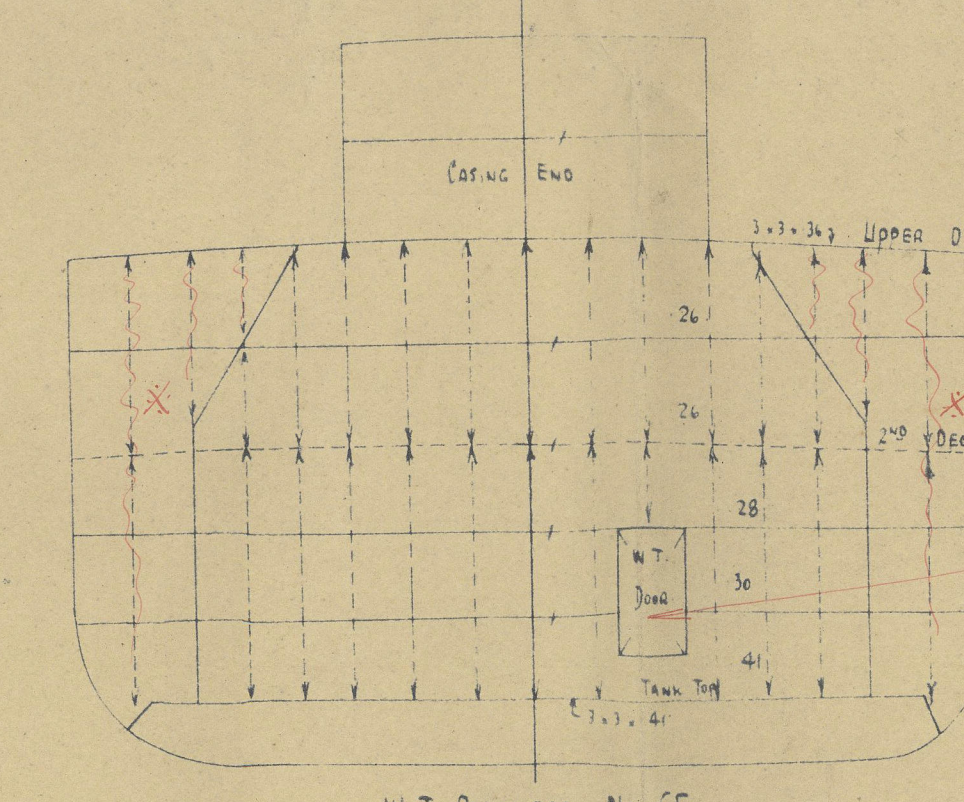

W.T. BULLHEAD No 65

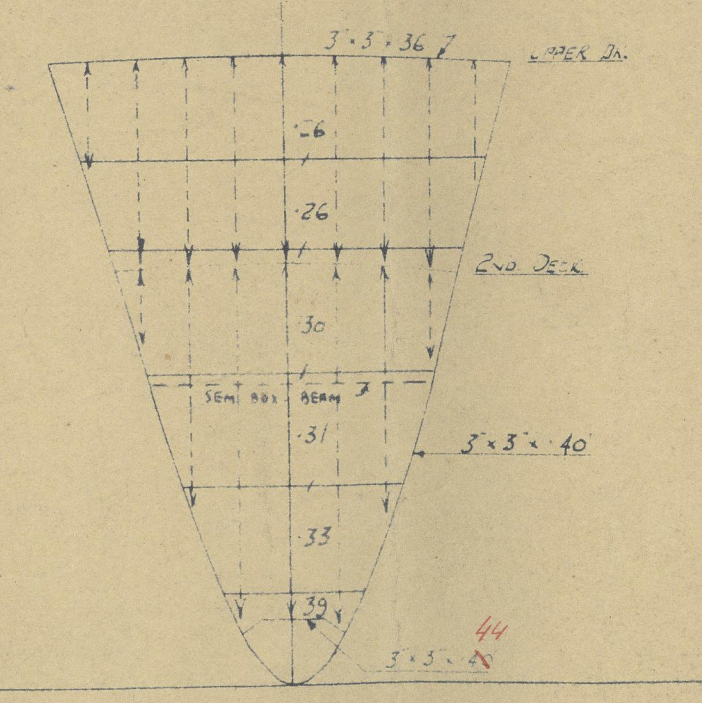



8 AUG 1929
LLOYD'S REGISTER

2 Hawthorn Leslies

569

Profile & Deck Plans

S.S. "WAINUI"

NEWCASTLE ON TYNE

Report No. 85338

10.11

2.9

5.8

11



© 2020

Lloyd's Register
Foundation

002418-002426-0210

R 8/5

(22)

551
208


51
59

39
88



© 2020

Lloyd's Register
Foundation

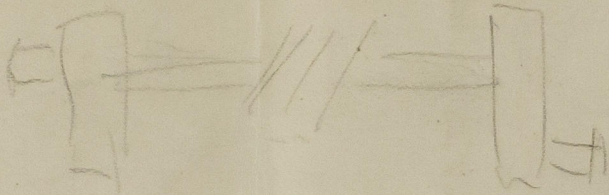

© 2020

Lloyd's Register
Foundation