

No. 569. MIDSHIP SECTION.

TO CLASS 100 A.1. AT LLOYDS.

DIMENSIONS - 241'-0" B.P. x 38'-0" B.M. x 21'-0" D.M.

SCALE $\frac{1}{2}'' = 1'-0''$

NUMERALS.


1 st LONGITUDINAL NUMBER	L x D = 241 x 21 = 5061
2 nd " "	L (B + D) = 241 (38 + 21) = 14219
L to UPPER DECK =	$\frac{241}{21} = 11.48$
D = BRIDGE DECK =	$\frac{241}{28.25} = 8.53$
d IN WAY OF 2 nd DECK	$\frac{12.6 \times 2.10}{21} = 9.8$
d " " UPPER	$\frac{21.5 \times 2.10}{21} = 16.2$

EQUIPMENT NUMBER

L (B + D)	14219
POOP	7.25 x 7.5
BRIDGE	7.0 x 7.25 x 7.5
FORECASTLE	26.25 x 7.25 x 7.5
HOUSE ON BRIDGE DECK	18.0 x 7.25 x 5.0
EQUIPMENT No.	14950.3


EQUIPMENT

3 BOWER ANCHORS	29 CWTs EACH STOCKLESS.
1 STREAM ANCHOR	7 1/2" EX STOCK
240 FATHOMS OF	1 1/8" STUD CHAIN CABLE.
75 "	3/4" STEEL WIRE ROPE (STREAM)
90 "	3/4" (TONLINE)
2 HAWSEDS	90 FMS. EACH 2 1/2" S.W.
2 WARPS	90 " 1 1/2"

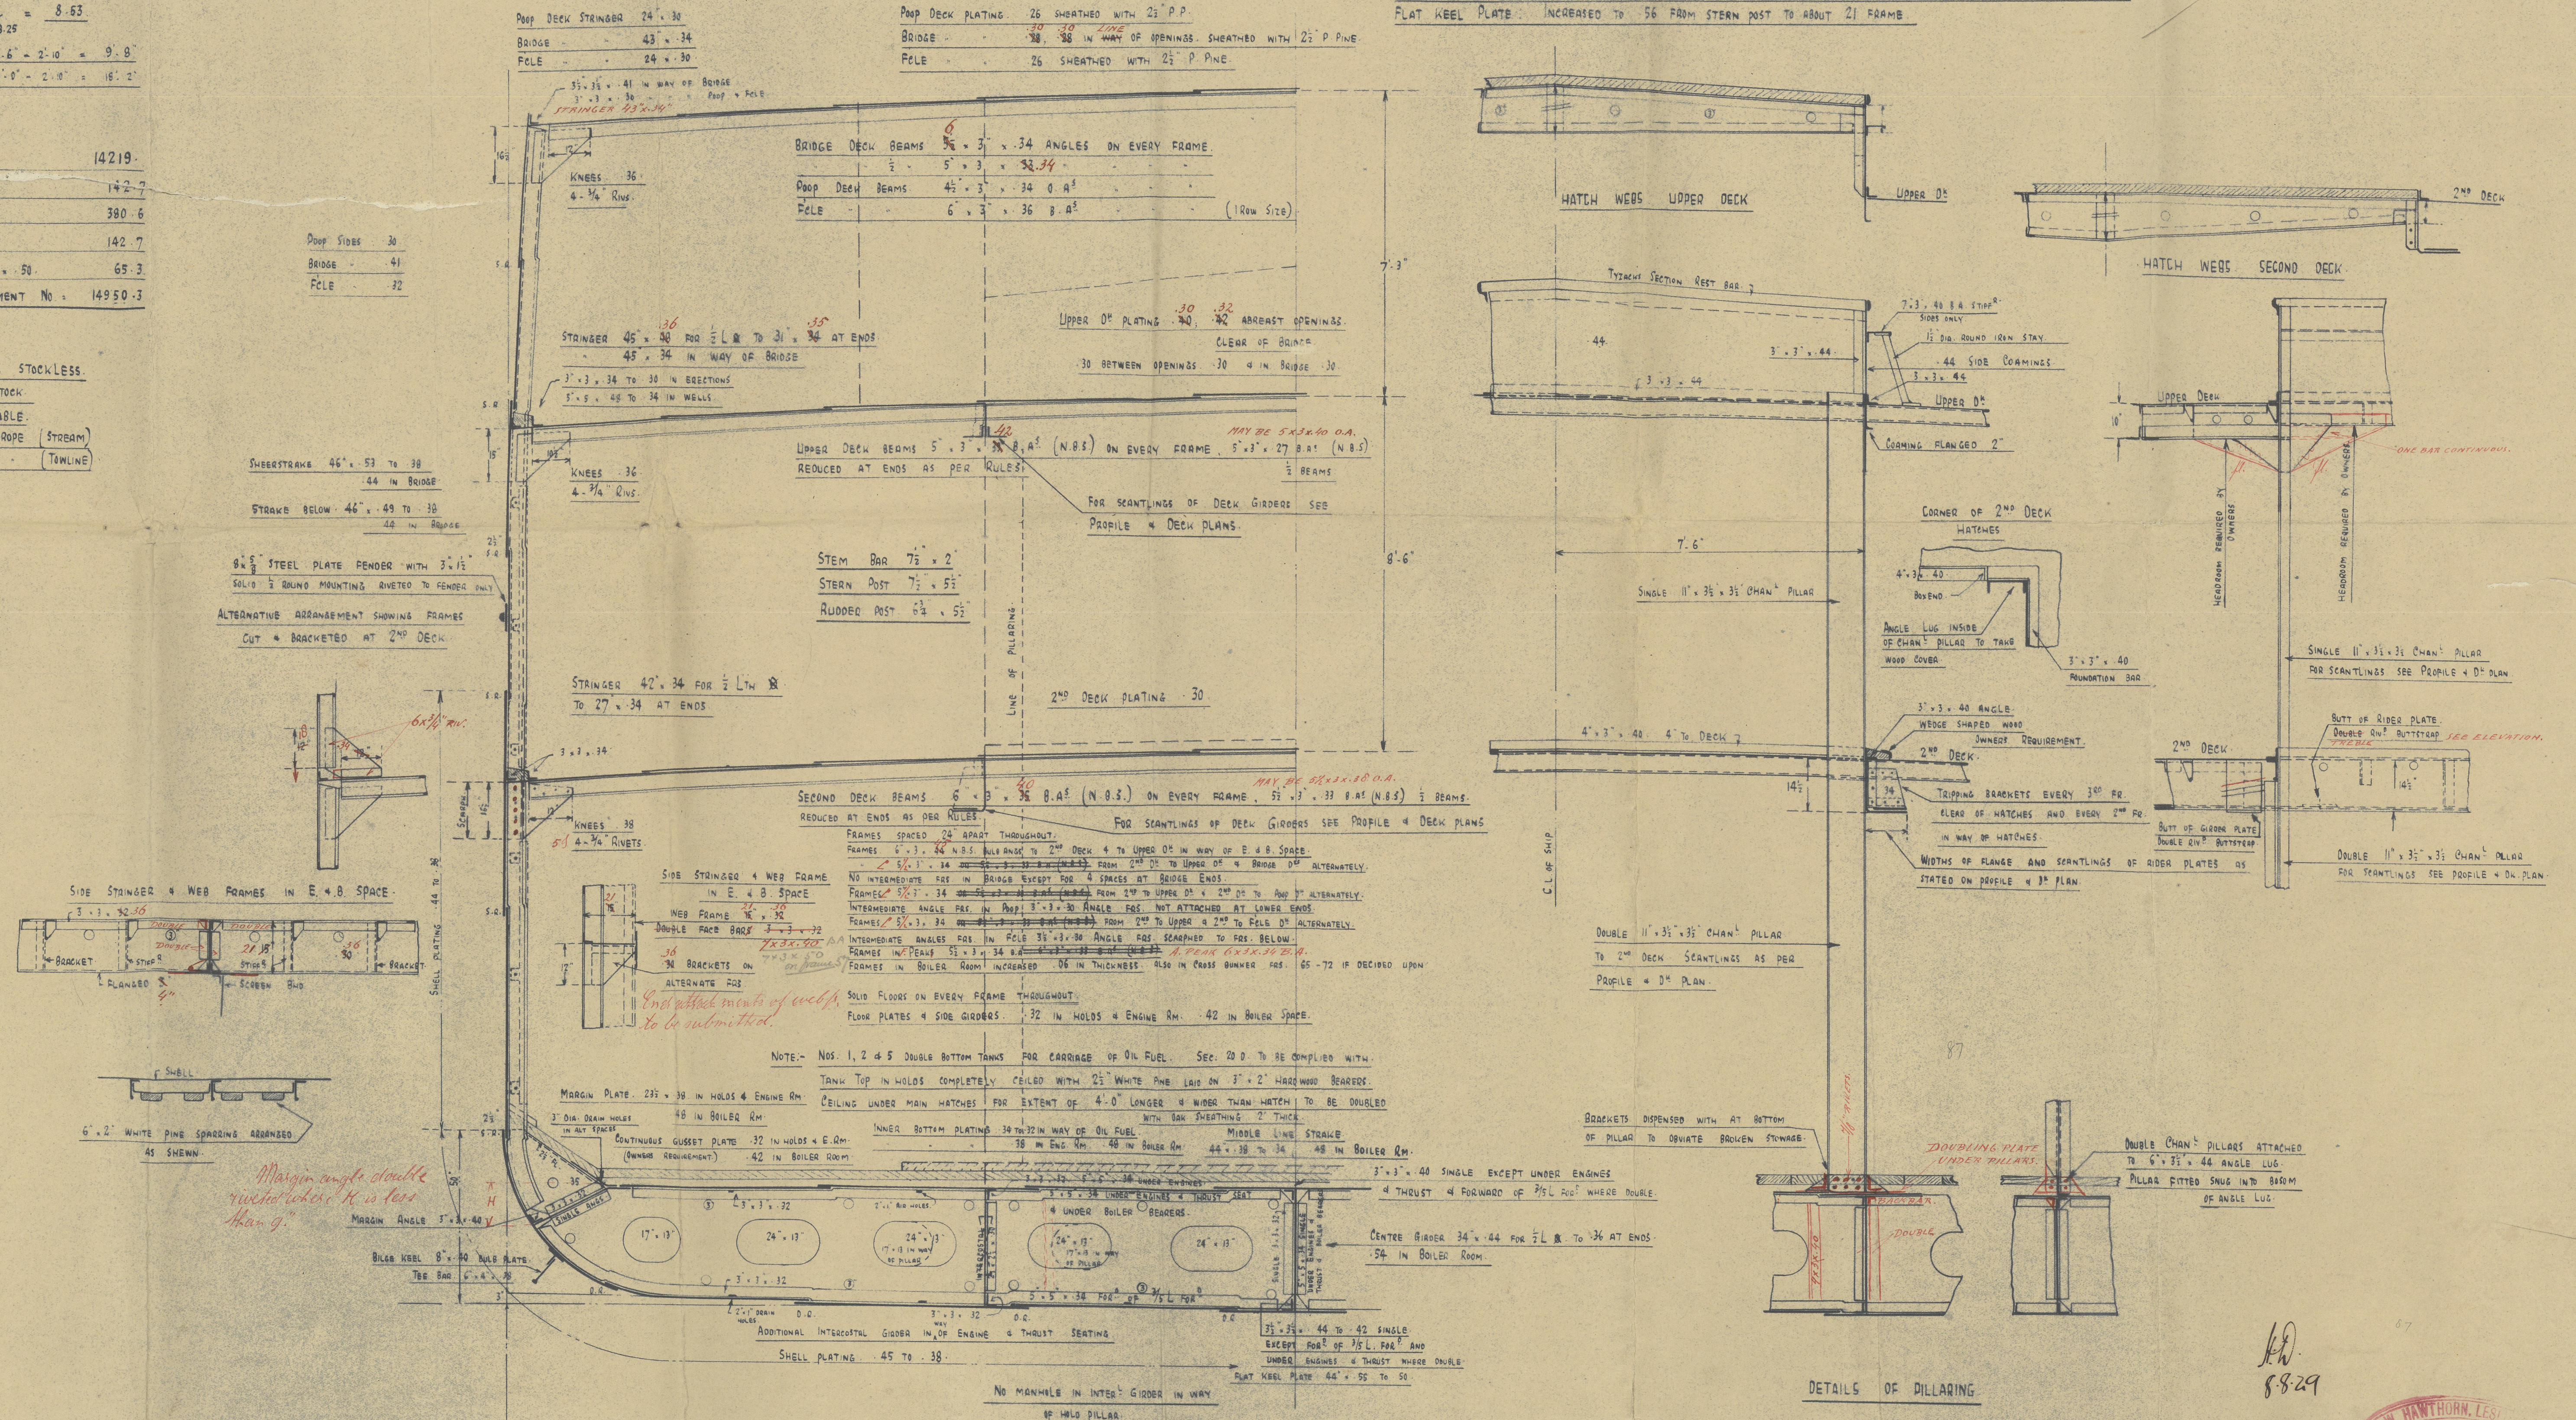

OWNERS EXTRAS ABOVE CLASSIFICATION REQUIREMENTS

CENTRE GIRDER	INCREASED .04 UNDER ENGINE & BOILER SPACES INCLUDING MOUNTINGS
DOUBLE BOTTOM	IN MACHINERY SPACE & SPACE FOR CROSS BUNKER THE MARGIN PLATE AND MOUNTINGS TO BE INCREASED .04 IN THICKNESS
DOUBLE BOTTOM FLOORS	IN WAY OF COAL BUNKER SPACE & MACHINERY SPACE THE FLOOR PLATES INCLUDING BOTTOM FRAMES, REVERSE FRAMES & FLOOR MOUNTINGS TO BE INCREASED .04 IN THICKNESS
DOUBLE BOTTOM INTERCOSTALS	INTERCOSTALS INCLUDING THEIR MOUNTINGS INCREASED .04 IN THICKNESS IN WAY OF MACHINERY SPACE & COAL BUNKER SPACE
TANK TOP	INCREASED .04 IN THICKNESS IN WAY OF BUNKER SPACE & MACHINERY SPACE INCLUDING ALL MOUNTINGS
UPPER DECK	INCREASED .08 IN THICKNESS WHERE EXPOSED IN WELLS AND INCREASED .08 IN WAY OF GALLEY
FLAT KEEL PLATE	INCREASED TO .56 FROM STERN POST TO ABOUT 21' FRAME

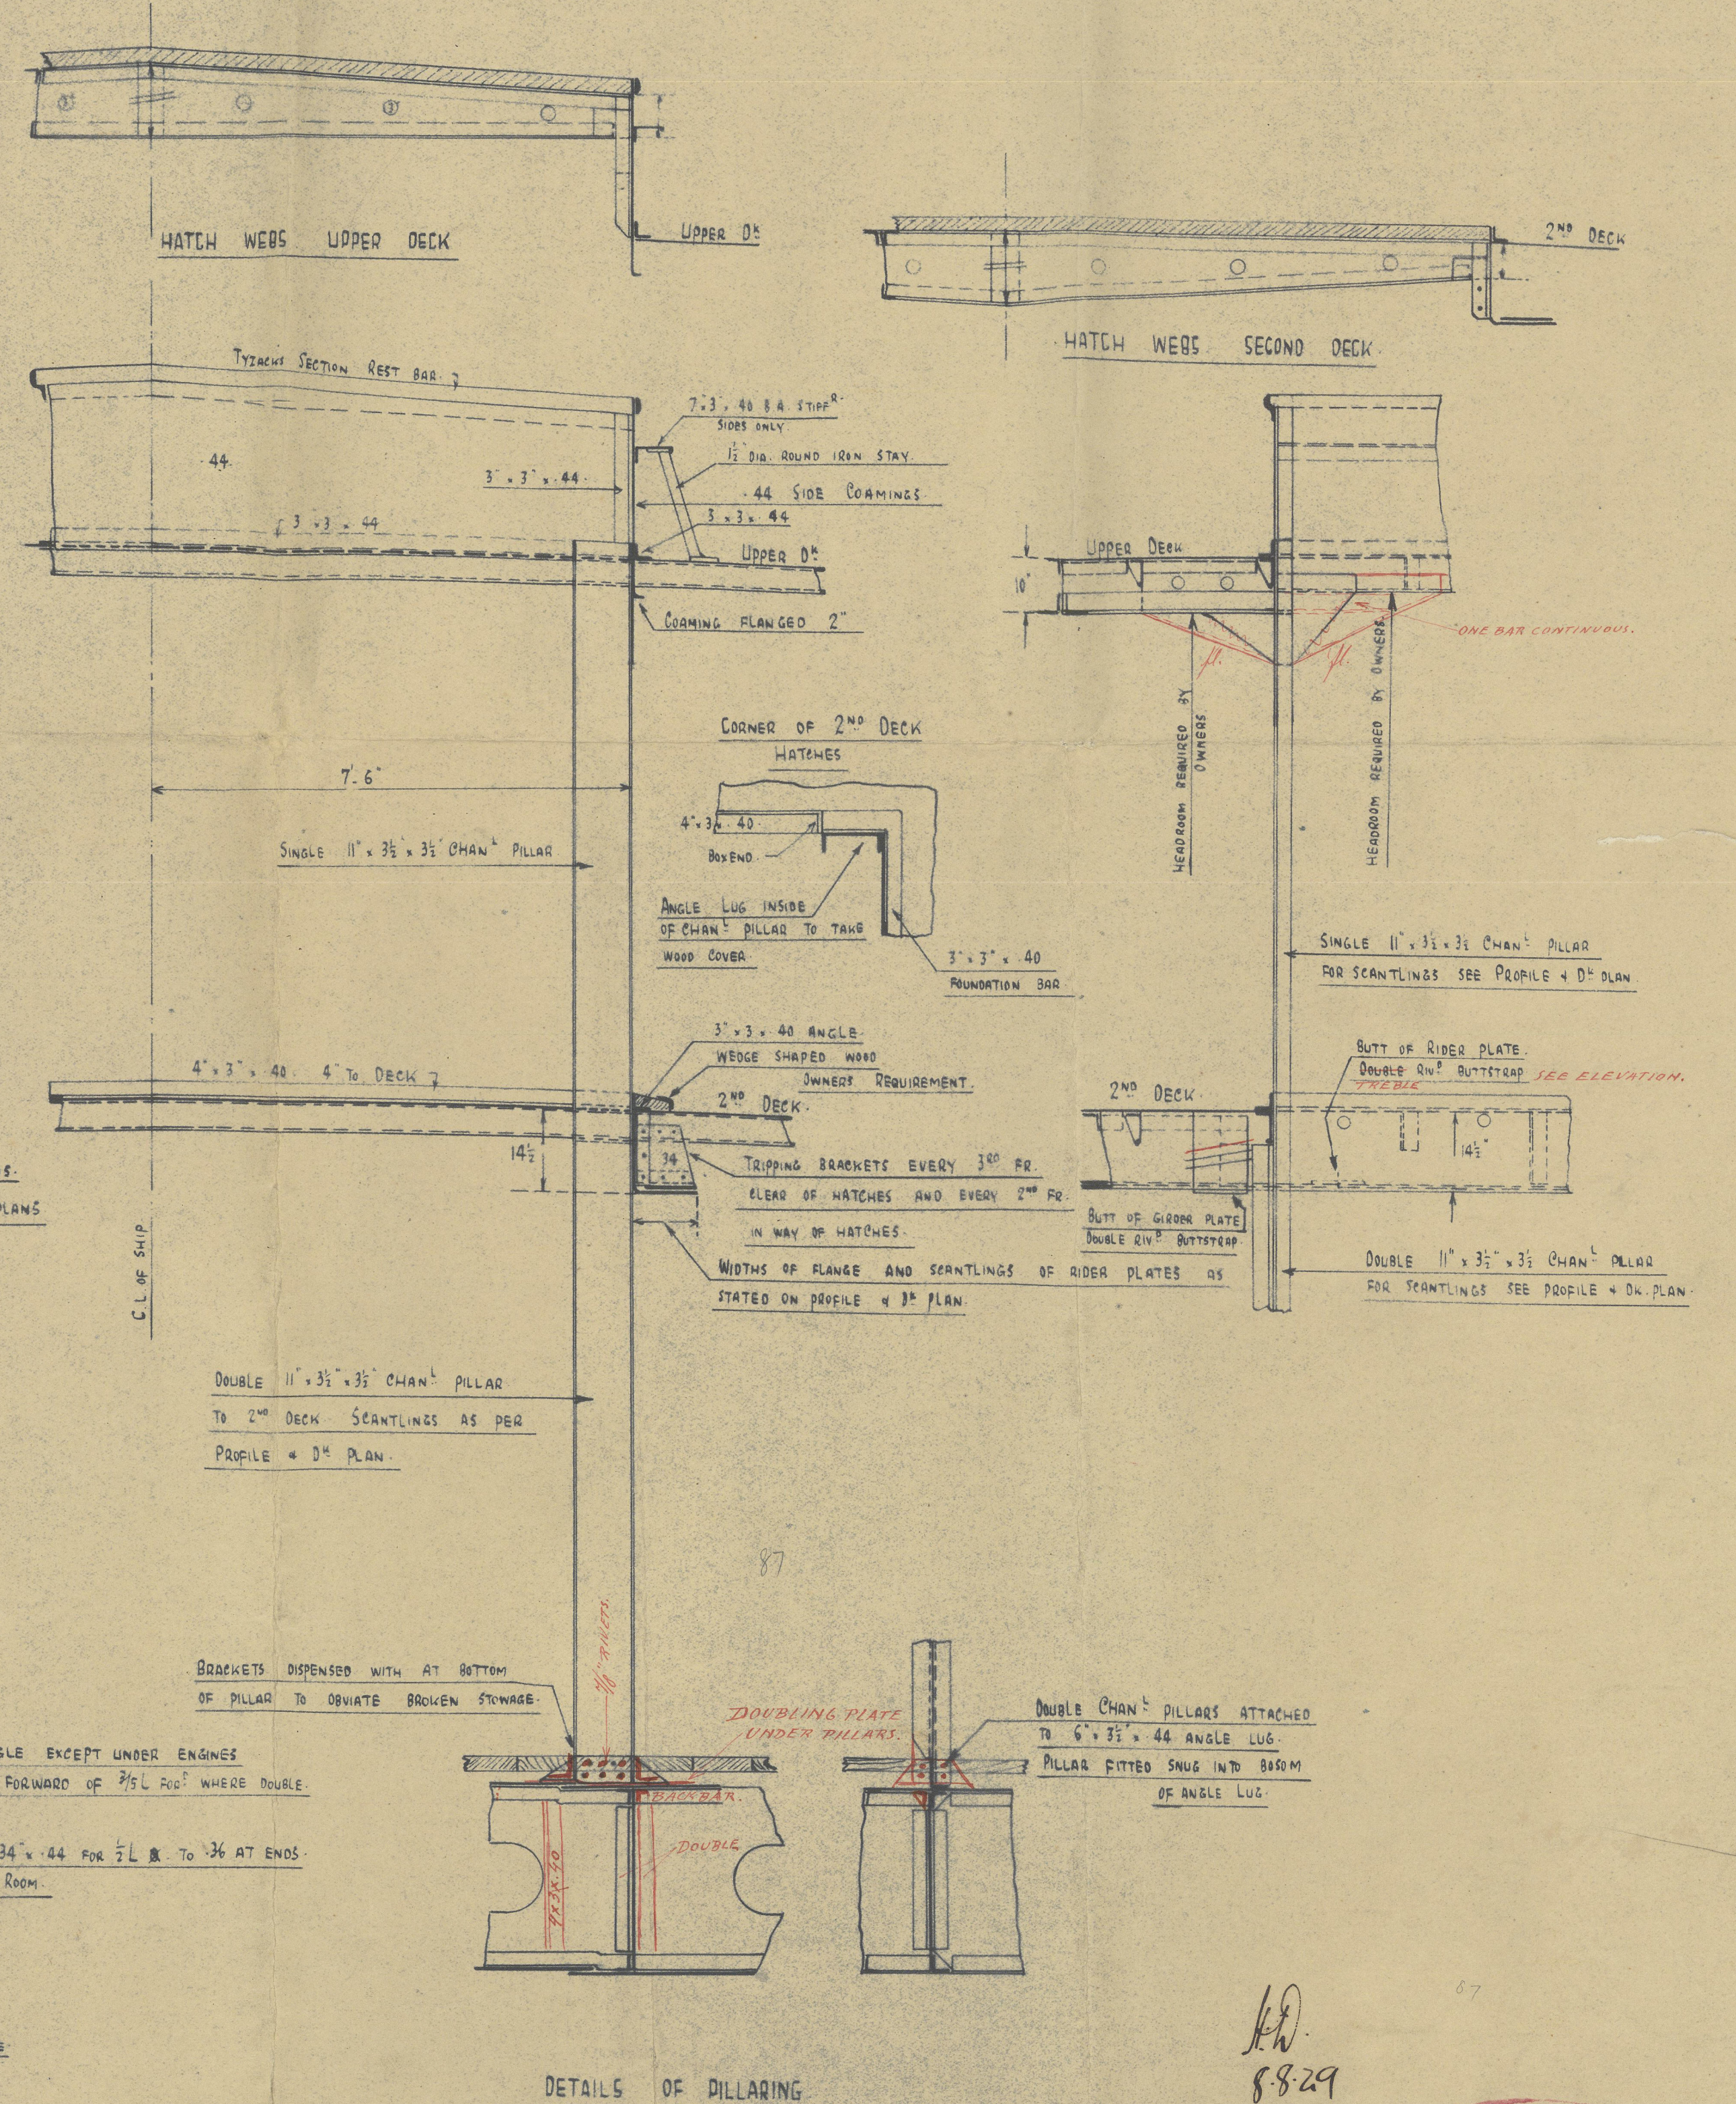

R. Mc

1/
Hawthorn 567 Hawthorn Leslies

569

Madship Section

S.S. "WAINUI"

NEWCASTLE ON TYNE.

REG. NO. 85 338.



© 2020

Lloyd's Register
Foundation

002418-002426-0211