


# S.S."WAINUI

Scale:-  $1/8" = 1 FT$

## ALTERATIONS FORE CASTLE ACCOMMODATION


LLOYD'S REGISTER OF SHIPPING  
DUNEDIN. G.W.M.

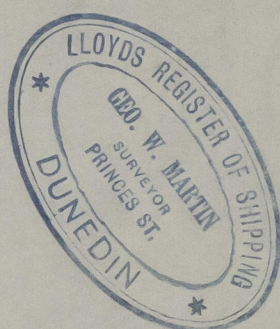

© 2020

Lloyd's Register  
Foundation

002418-002426-0242

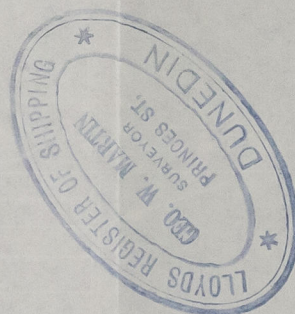

© 2020

Lloyd's Register  
Foundation