

# Lloyd's Register of Shipping.

Ship's Name **"WAINUI"**

Official No. 151518

Memorandum of alterations reported since ship was surveyed for assignment of Load Lines

in PORT of DUNEDIN, N.Z. 12th February 1949.

### ALTERATIONS & ADDITIONS:-

**Crew's Quarters Forecastle.** Crew's Messroom previously fitted forward end of 2nd. Deck in between frames 108/113, in February 1946, now converted into a special cargo locker.

Two side scuttles on Port side and two on Starbd. Side in main sheerstrake removed, opening closed, plated over.

On bulkhead, 2nd Deck, between frames 108/109, on centre line, opening 5'-0" wide cut and fitted with wood sliding door.

On Upper Deck, opening for companionway on Port side of passage recess closed, plated over. Hatch to chain locker at fwd. end of passage recess, closed, plated over flush. New access opening 17" X 20" to chain locker cut in bulkhead, frame No.116, sill of same 2'-5" below upper deck.

Accommodation for seamen fitted as per adjacent sketch. Sills of doors in passageway = 9".

New 9" ventilator fitted on F'cle. deck, Port side, between frames 113/114, height of coaming = 22 1/2" X 1/4" t.

**Crew's Messroom:-** New messroom fitted on 2nd Deck, Port Side, extending between frames 27/44. Bulkhead casing 1/4" steel, stiffeners 2 1/2" X 2 1/2" X 3/8", spacing = 2'-0", brackets top & bottom, all secured by E.W.

On upper deck, opening 2'-3 1/2" X 5'-8" cut in way of After end bridge, Port side, between frames 41/44 for companionway to messroom below.

Casing of companionway = 1/4" steel, E.W. For access opening to same, new hinged steel door fitted to After end bridge, 1/4" t, sill = 19". New 6" mushroom vent. fitted over same on bridge deck. One 21" Hold vent. between frames 42/43, Port side removed, opening closed, plated over. Similar vent. on Starbd. side to 'Tween deck, extended to Hold.

On upper deck, new 14" vent. fitted over messroom, Port side, between frames, 28/29, height of coaming 2'-11" X 1/4" t.


In way of new messroom, five new Side Scuttles (7 3/8" dia. clear glass) fitted, G.M. complete with deadlights, between frames 27/41. Sill of same 21 3/8" below level of 1 1/2" composition on top of steel upper deck. Scupper from messroom sink led to No.3 Hold bilge.

**Poop Space:-** Refitted for Crew's accommodation as per adjacent sketch. New steel hinged door fitted in Poop bulkhead, 3/8" t, Sill = 18 1/2".

One 6" vent replaced by one 9", height of coaming = 17 1/4" X 1/4" t.

Wooden plugs & canvas covers fitted to all new ventilators.

**Accommodation Amidships:-** On Starbd. Side of Upper Deck, in Starbd. alleyway, one opening for wood door closed, plated over, new opening cut 17" fwd. of same and door refitted. One side scuttle removed and opening closed, and scuttle refitted in cabin aft of same in way of Steward and Bosun's cabins.

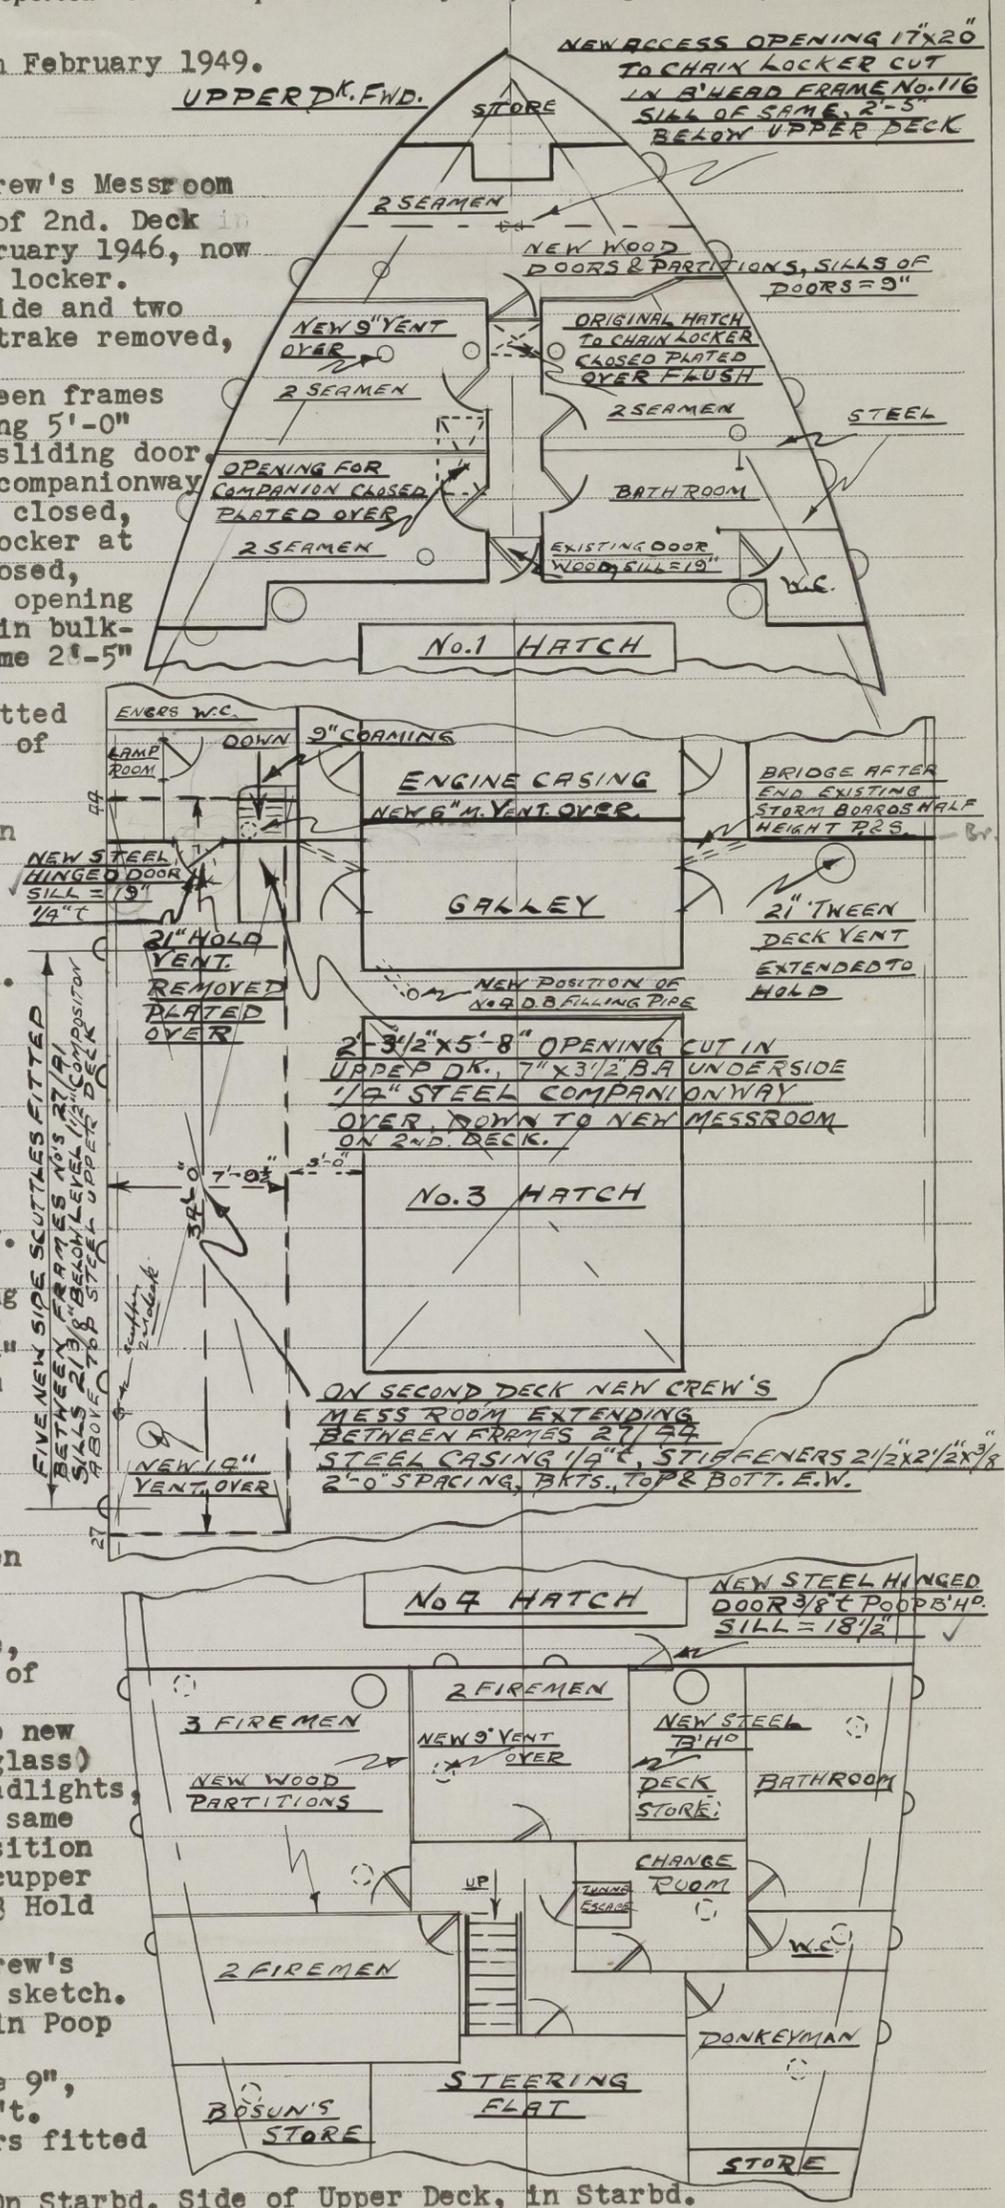

SURVEYOR TO LLOYD'S REGISTER, DUNEDIN, N.Z.

Lloyd's Register Foundation