

17.2.03

EQUIPMENT

1 BOWER ANCHOR	7 1/2 Cwts STOCKLESS
1 STREAM	1 1/2 " EX STOCK
1 KEDGE	3/4 " "
165 FATHOMS	1 1/2 " STUD LINK CABLE
45 "	1 1/2 " STREAM CHAIN
75 "	6 1/2 " MANILLA TOWLINE
90 "	4 " HAWSER

QUARTER DECK NUMERALS

1/2 GIRTH	23.07
1/2 BREADTH	11.12
DEPTH	14.21
1 ST NUMERAL	48.40
	X 130.75
2 ND NUMERAL	6243.60

MIDSHIP SECTION

S.S. No 119.

TO CLASS 100 A.I. AT LLOYDS * STEEL

SCALE 1/2 INCH = 1 FOOT.

DIMENSIONS:- 130'-0" B.P. x 22'-3" M.D. x 10'-0" DEPTH.

L = 12'-2 3/8" B = 5'-7 3/8"



ERECTIIONS

149 QUARTER DECK	43.75
116 BRIDGE	10.50
223 FORECASTLE	22.25
	76.50

NUMERALS

1/2 GIRTH	19.32
1/2 BREADTH	11.12
DEPTH	10.46
1 ST NUMERAL	40.90
	X 129
2 ND NUMERAL	5276.10
	X 129
EQUIP. NUMERAL	5655.24

5.84 Bdrths
12.5 Drths

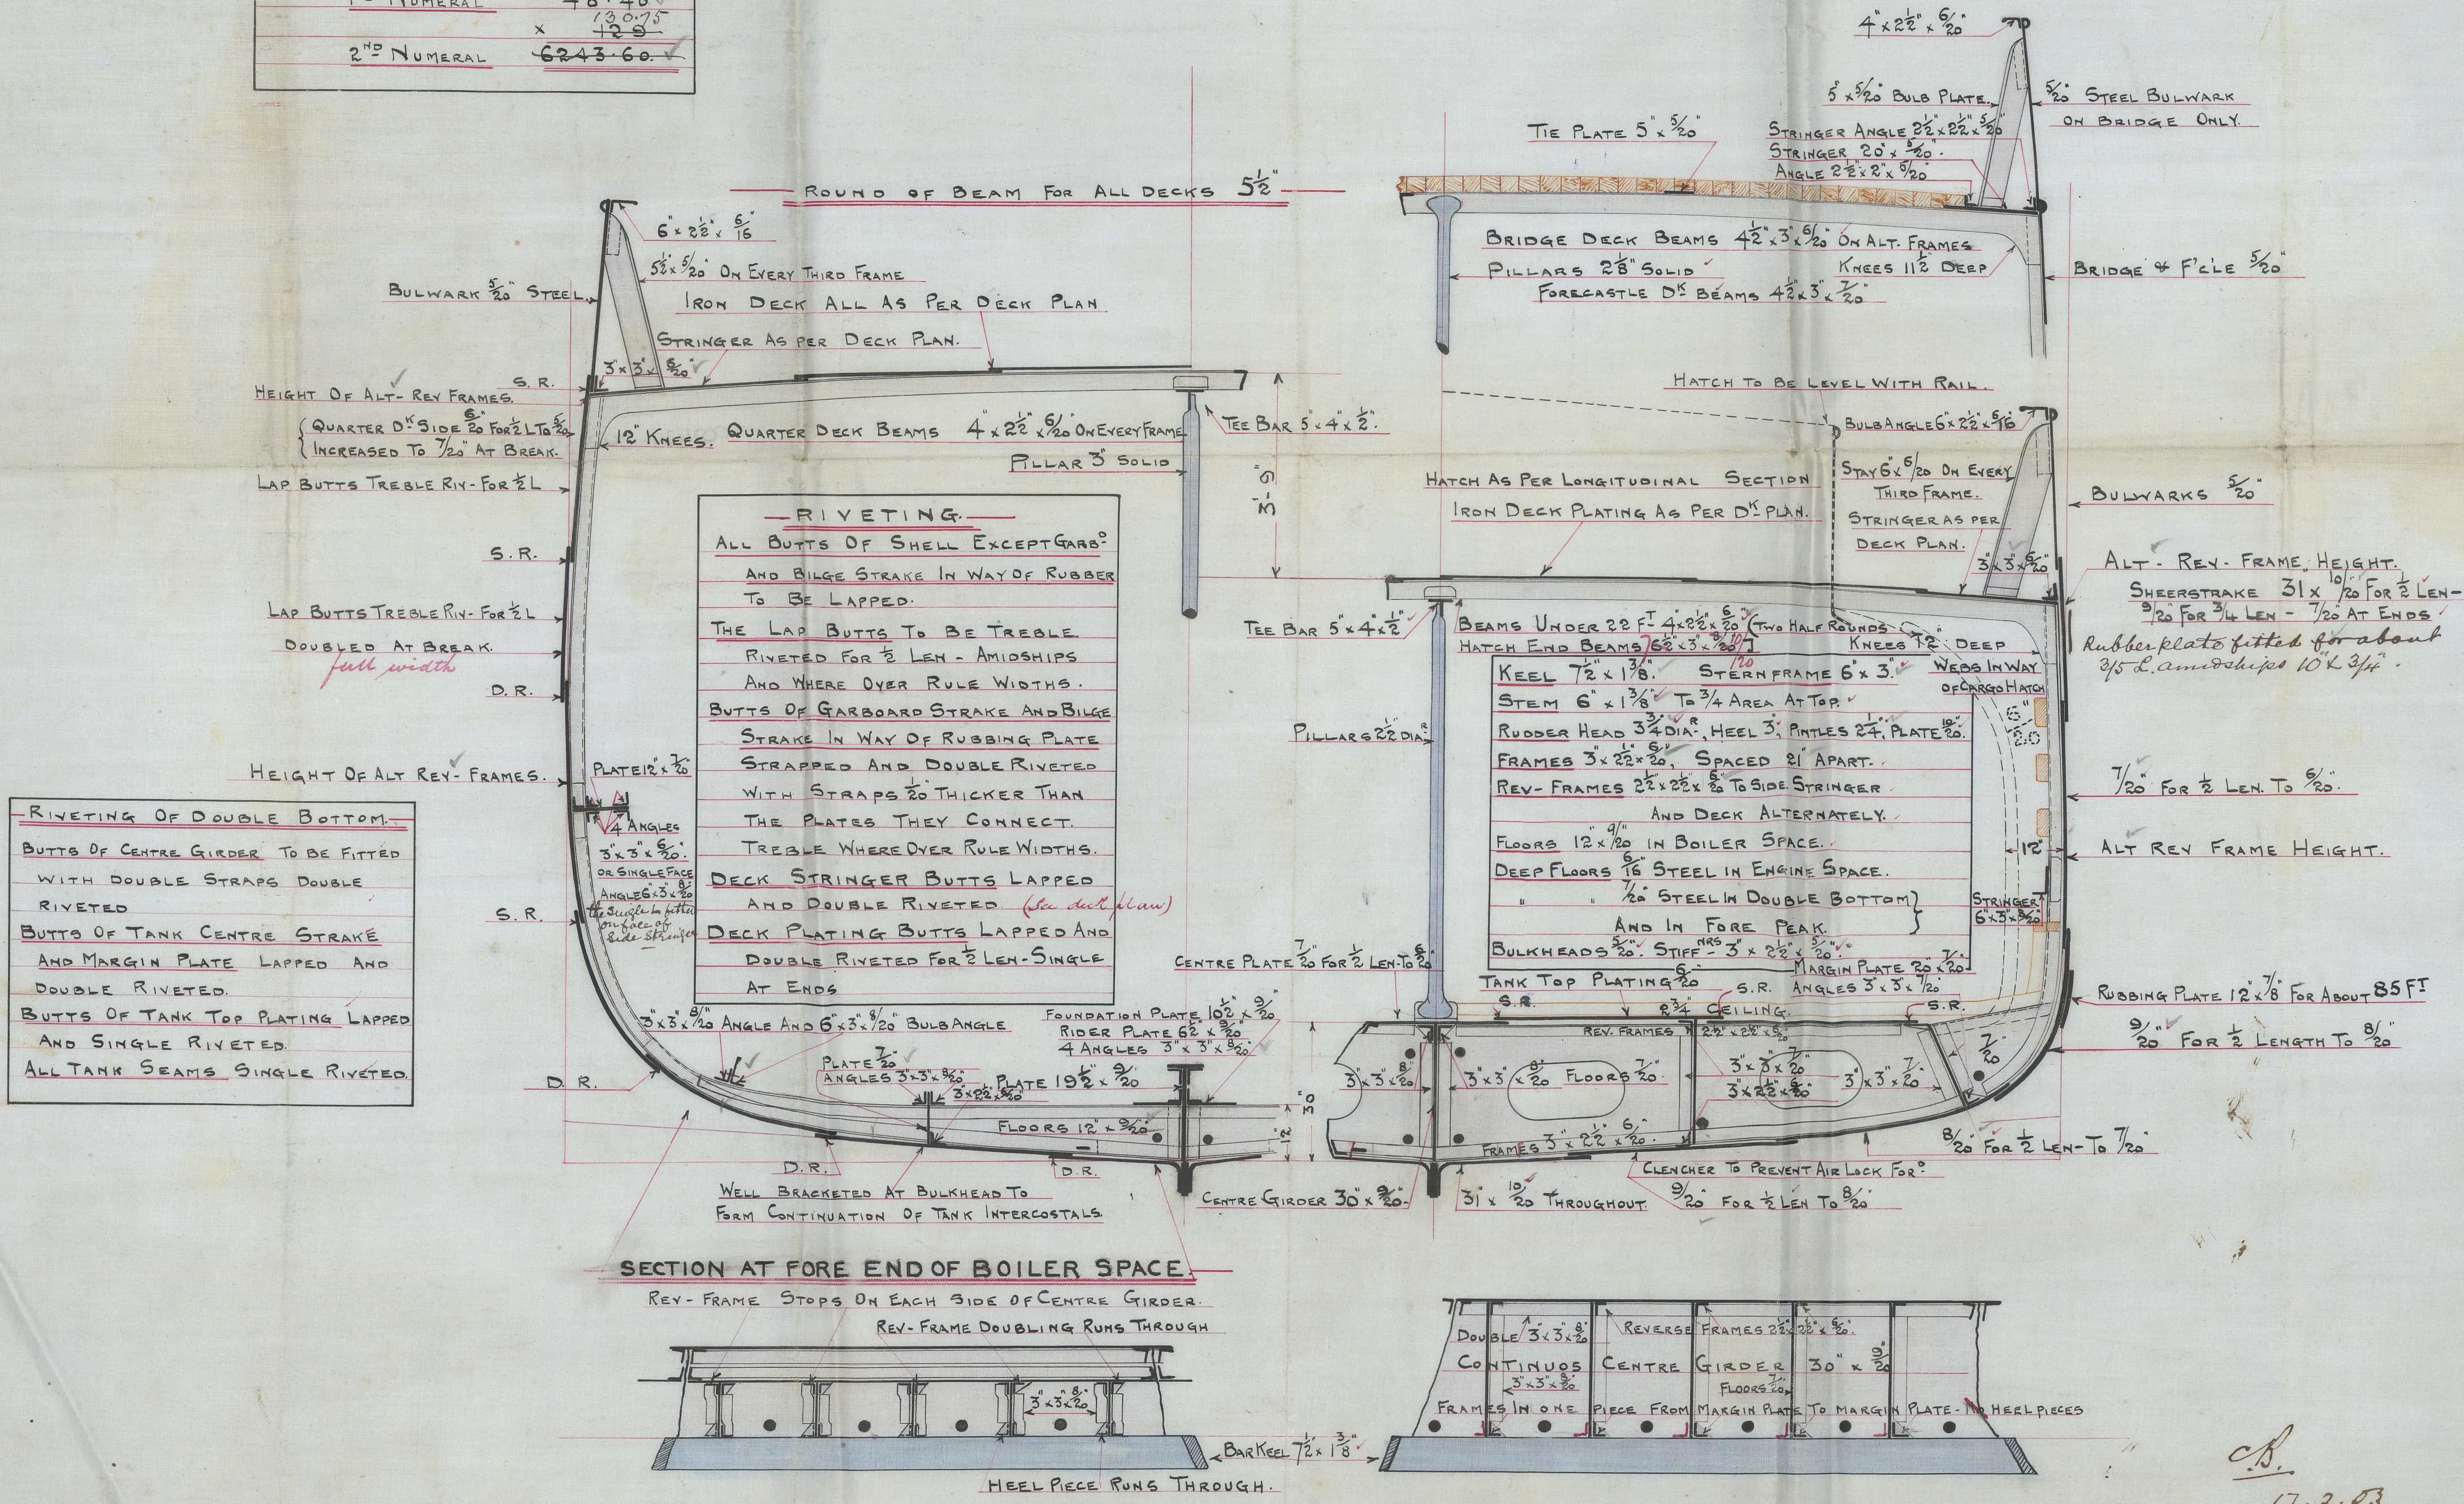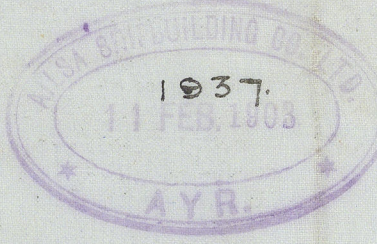

RIVETING OF DOUBLE BOTTOM.

BUTTS OF CENTRE GIRDER TO BE FITTED WITH DOUBLE STRAPS DOUBLE RIVETED

BUTTS OF TANK CENTRE STRAKE AND MARGIN PLATE LAPPED AND DOUBLE RIVETED.

BUTTS OF TANK TOP PLATING LAPPED AND SINGLE RIVETED.

ALL TANK SEAMS SINGLE RIVETED.

SECTION AT FORE END OF BOILER SPACE

REV. FRAME STOPS ON EACH SIDE OF CENTRE GIRDER

REV. FRAME DOUBLING RUNS THROUGH

LONG. SECTION IN WAY OF DOUBLE BOTTOM.

17.2.03.


Friendship Section
 Ailsa Fraser

"Enid"

off apt No 21000

20	4	HAUSER
75	1/2	MANILLA TOWLINE
42	10/16	STEAM CHAIN
162	1 1/2	STUD LINK CABLE
	3/4	KEGGE
	1 1/2	EX STEER
	7	BOWER ANCHOR 7 1/2 CWT'S STOCKLESS

2nd NUMERAL	6543-60 V
1st NUMERAL	48-40 V
DEPTH	14.51
BREADTH	11.15
GIRTH	23.07
QUARTER DECK NUMERALS	—

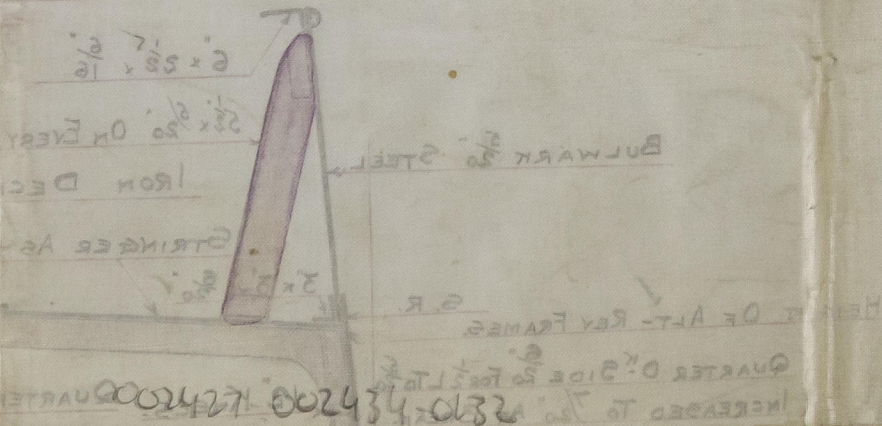

© 2020

Lloyd's Register
 Foundation