

S.S. No 385 and 386.

Longitudinal Section Deck Plans and Hatches.

Scale 1/8" = 1'-0"

Max Dimensions 24'-2" B.P. x 34'-0" M.L. x 17'-0" O.M.L.


To Class B.S.* British Corporation.

Load Draft 15'-6" M.L.


22 JAN 1923

TR.
M.

Approved
22 Jan 1923

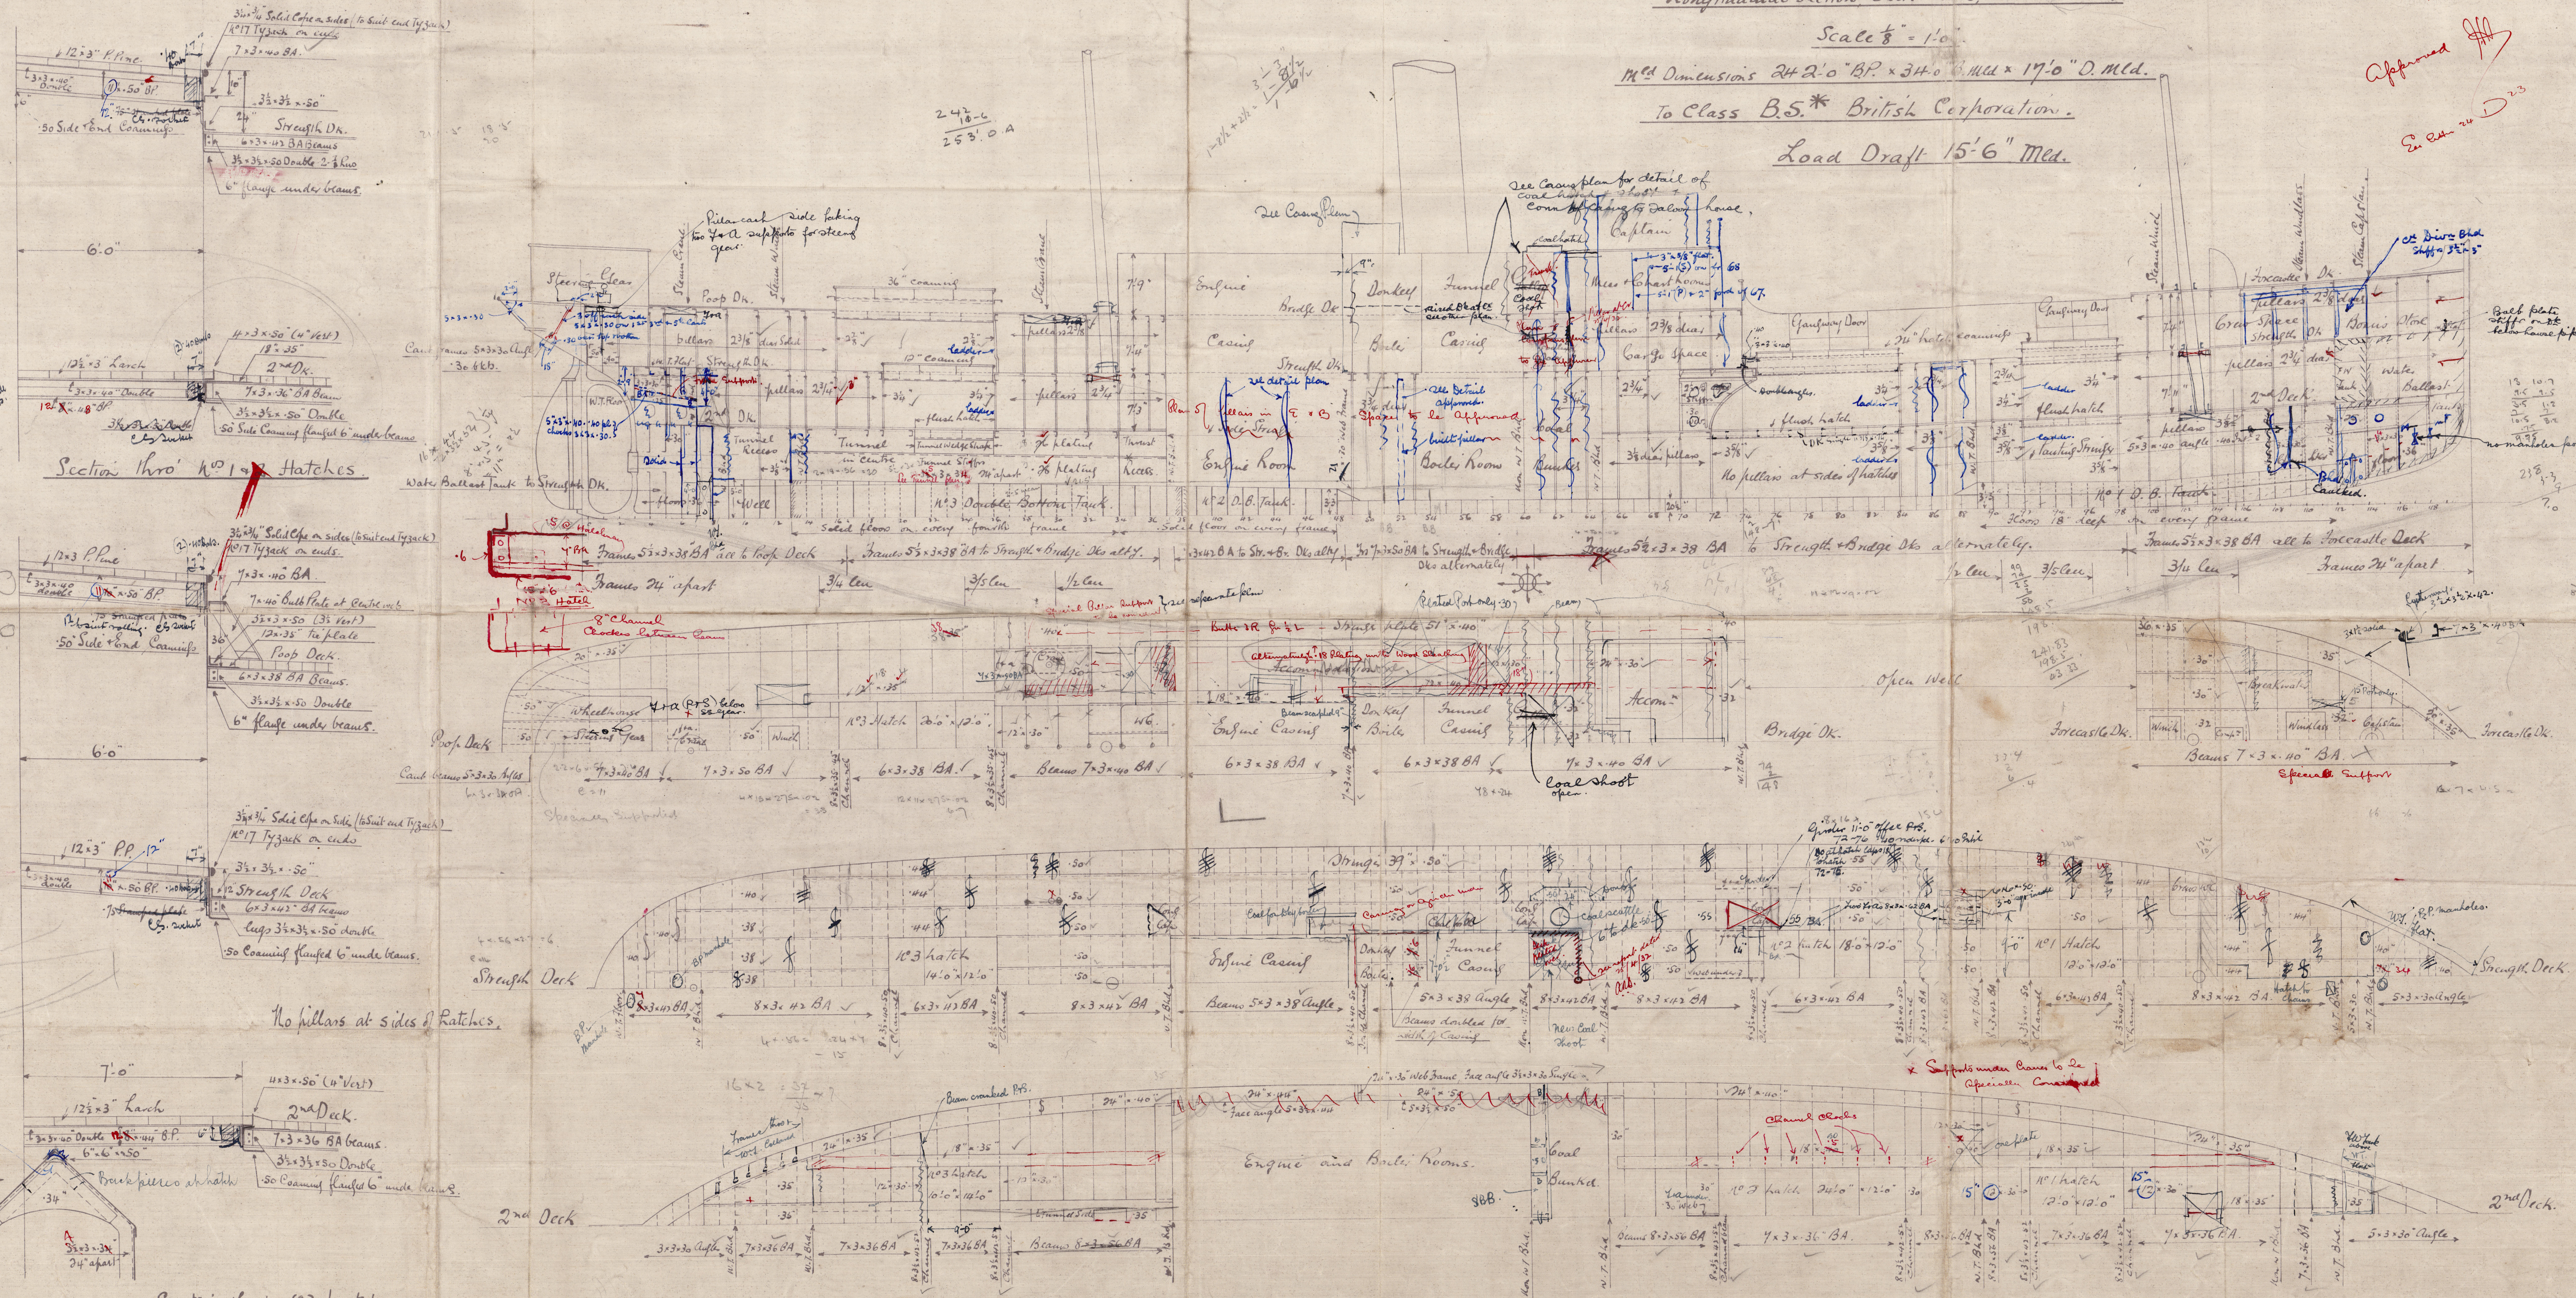

Section Thru No 3 Hatch
Scale 1/8" = 1'-0"

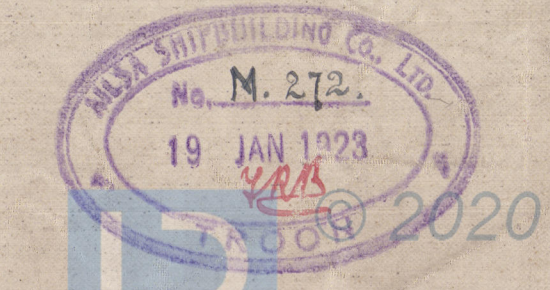

Absa's
385/6
Profile + decks
Sag

Tc 21. 2 23

Absa Shipbuilding Co. Ld
Nos 385. 386

profile + decks
24'2" x 34' x 17'0"

24. 1 23

* "Prora" + "Beauty"

2

002435-002441-0092



© 2020

Lloyd's Register
Foundation

2

Profile & Decks.

Aulsa S.B. Co. Nos 385-6.

S.B. 21-23.

24-1-23.

385 "Hura" 386 "Beaulx"



© 2020

Lloyd's Register
Foundation

002435-002441-0092