

# TWIN SCREW HOPPER BARGES N° 377 & 8

## To CLASS A.I STEEL HOPPER BARGE

# "FROME" & "AVON"

25.29 = 1/2 GIRTH  
13.75 = 1/2 BREADTH  
13.58 = DEPTH  
52.62 = 1/2 NUMERAL  
10.5  
20.510  
31.572  
20.2  
8682.30 = 2ND NUMERAL


SCALE 1/2" = ONE FOOT

**DIMENSIONS**  
LENGTH AS PER RULE..... 165.0'  
BREADTH MOULDED..... 27.5  
DEPTH..... D..... 13.0  
DEPTH AS PER RULE..... 13.58

D to L = 12.15  
B to L = 6.00


### EQUIPMENT N° 8682

1 BOWER ANCHOR	12 1/2 CWT.	STOCKLESS
1 " "	10 3/4	"
1 " "	4 3/4	"
75 "	8	HEMP
90 "	6	HAWSER

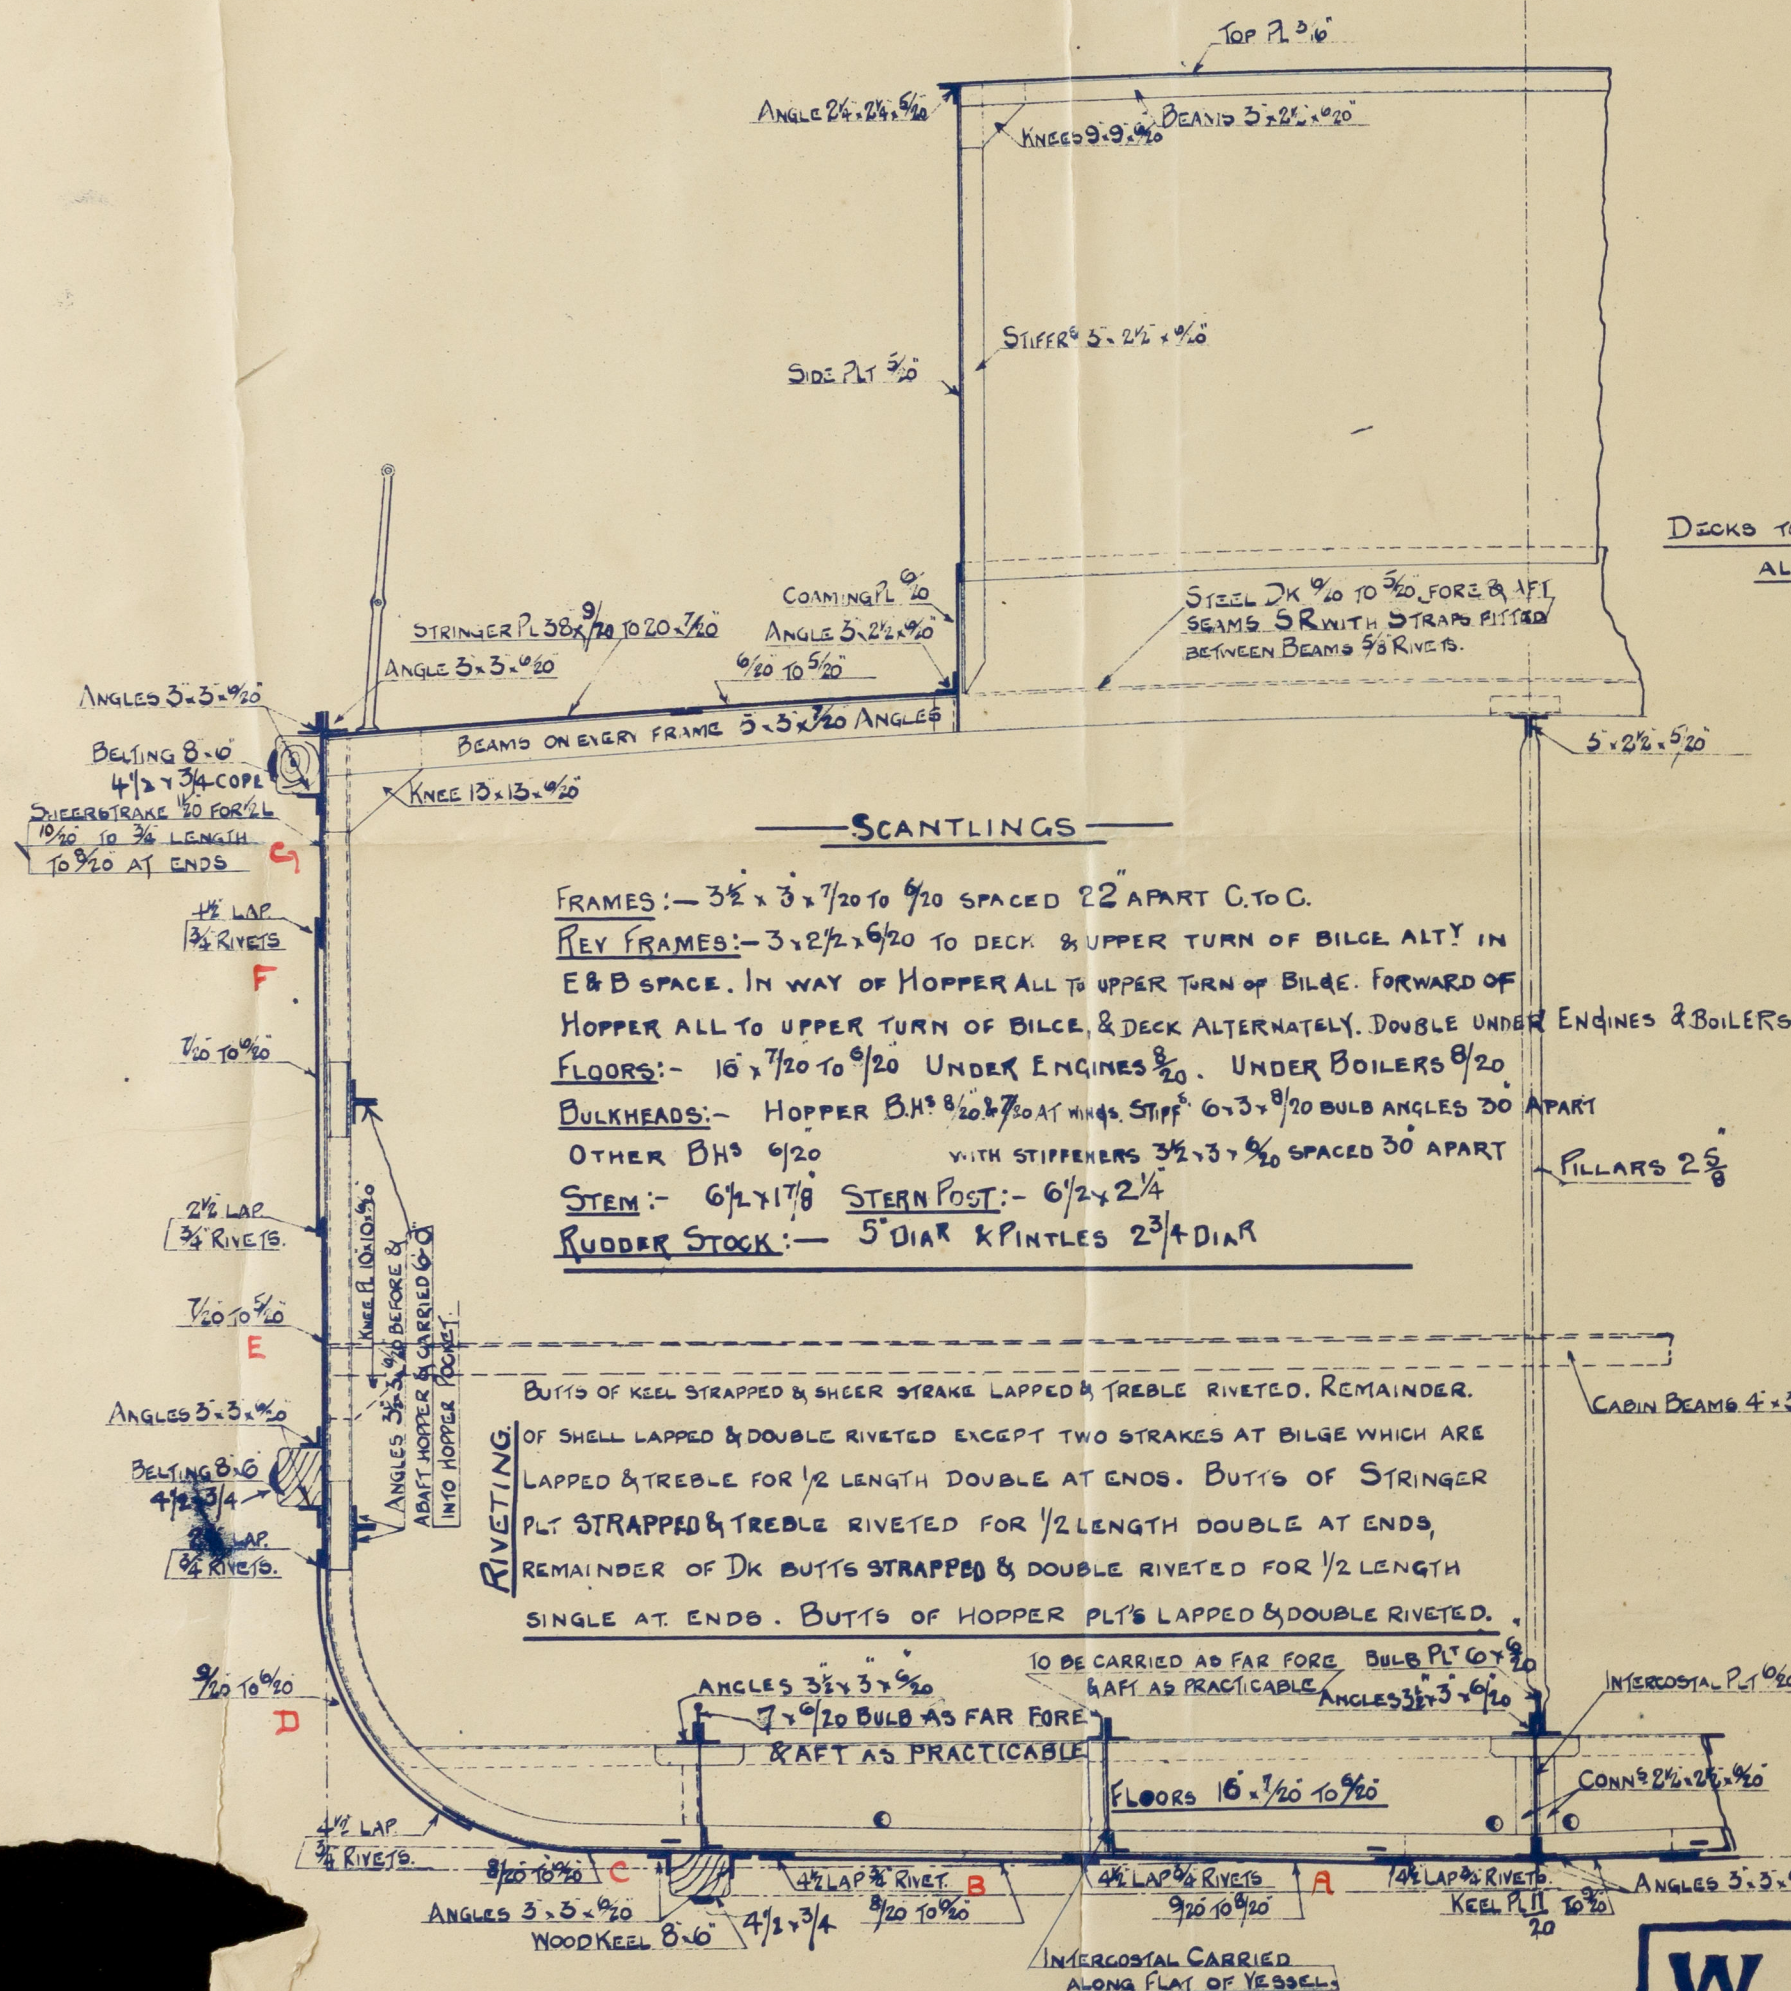

SECTION AT ENGINE SPACE

**W. SIMONS & CO., LTD**  
LONDON WORKS,  
RENFREW.

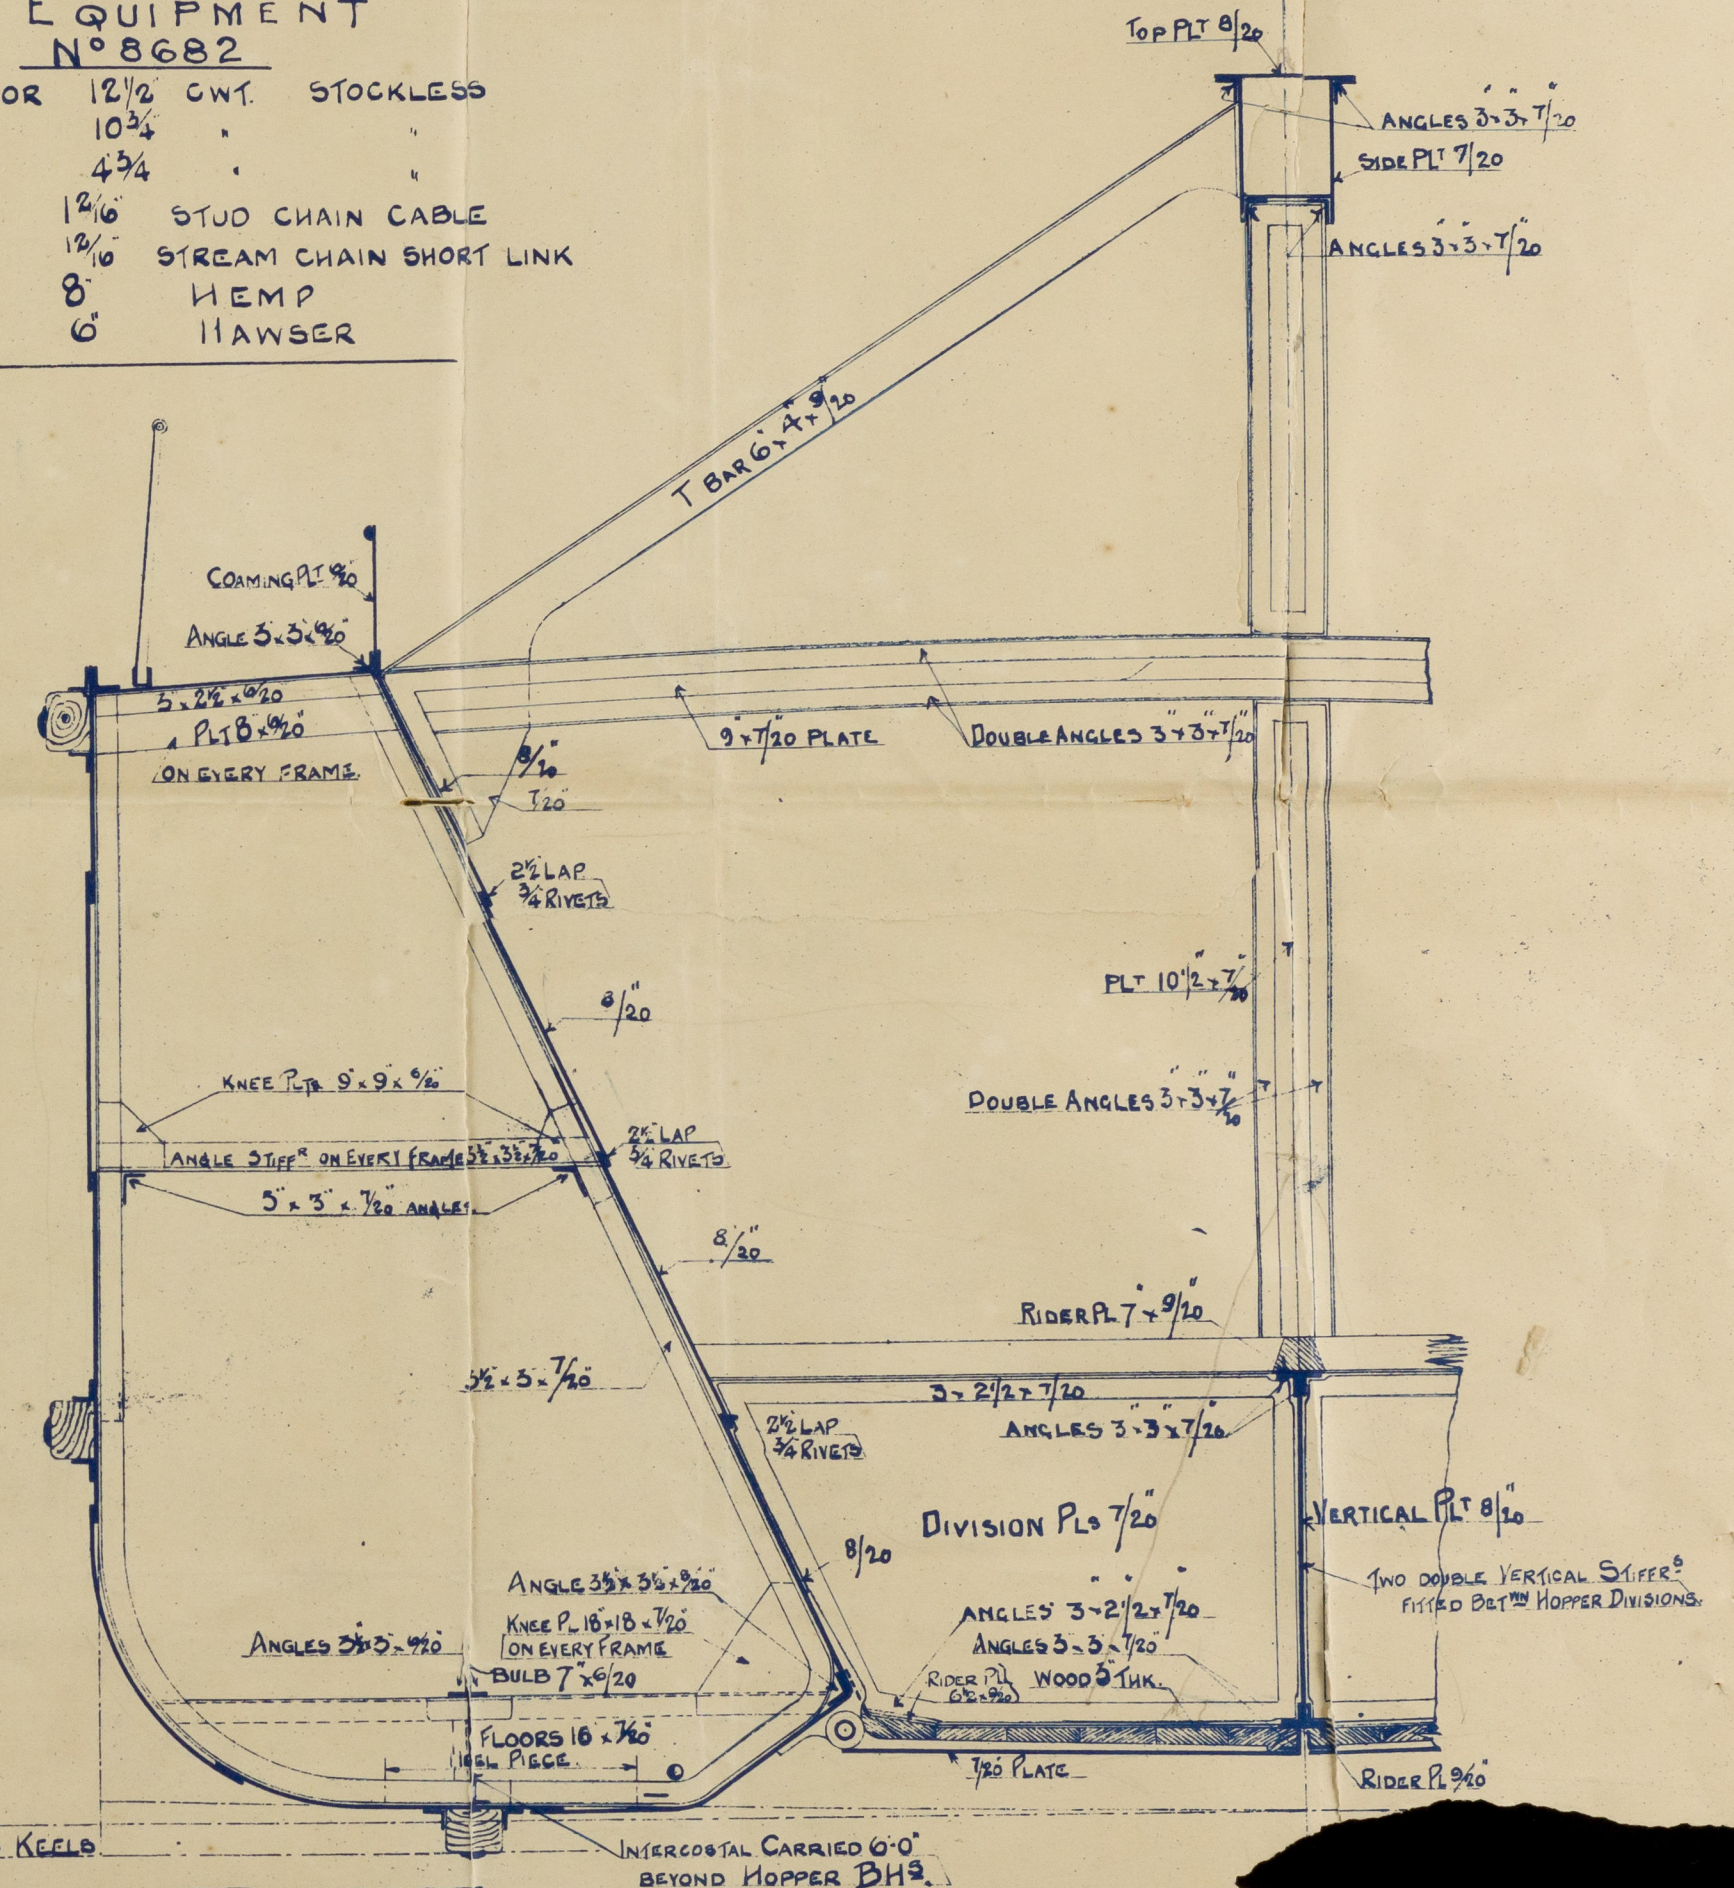

002435-002441-0170



W. Simons & Co

N<sup>o</sup> 344. + 348.

Amended

Midship Section.

N<sup>o</sup> 344. FROME

Glo rpt N<sup>o</sup> 18418

N<sup>o</sup> 348 AVON

Glo rpt N<sup>o</sup> 18423.

Blt 1900

002435-002441-0170



© 2020

Lloyd's Register  
Foundation