

Länge	520' - 0"	153,492 m
Breite	70' - 0"	21,306 "
Höhe	38' - 9"	11,710 "
Tiefgang (WdL)	28' - 2 1/2"	8,750 "
Geschwindigkeit	12 1/2 Kn.	
Ruder/Hörsch 1966	205 RFT	192 m ²
o. Abstand, hinter d. Hörsch	22 1/2'	664 m
Größter Ruderswinkel	35°	

Eingeg. 27. JAN. 1931

DEUTSCHE WER
27. I. 31.
HAMBURG

148/49. SK. 1. R.A. 4818

Hintersteven und © 20
Simplex-Balance-Ruder

© 2021
Lloyd's Register
Foundation

002442-002448-0002

SIR JOSEPH W. ISHERWOOD & CO. LTD.
4, LLOYDS AVENUE,
LONDON, E.C.3.
FOR ENCLOSURE TO
DATE 2-2-34

Is. no 1666-7
Plan no 9276
2-2-21.


Zinkenstern & Limpl. Balance Rudder
Deutsche Werft Nos 148/149

002442-002448-0002



© 2021

Lloyd's Register
Foundation

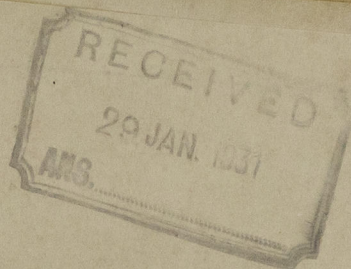

002442- 002448- 0002



© 2021

Lloyd's Register
Foundation

Stern frame & Padder.

No. 148/149.

'D.L.HARPER'

No. 6.

Hamburg Report Nr. 20926.

'FRANZ KLASSEN' ★

MAGGY

002442-002448-0002



© 2021

Lloyd's Register
Foundation