
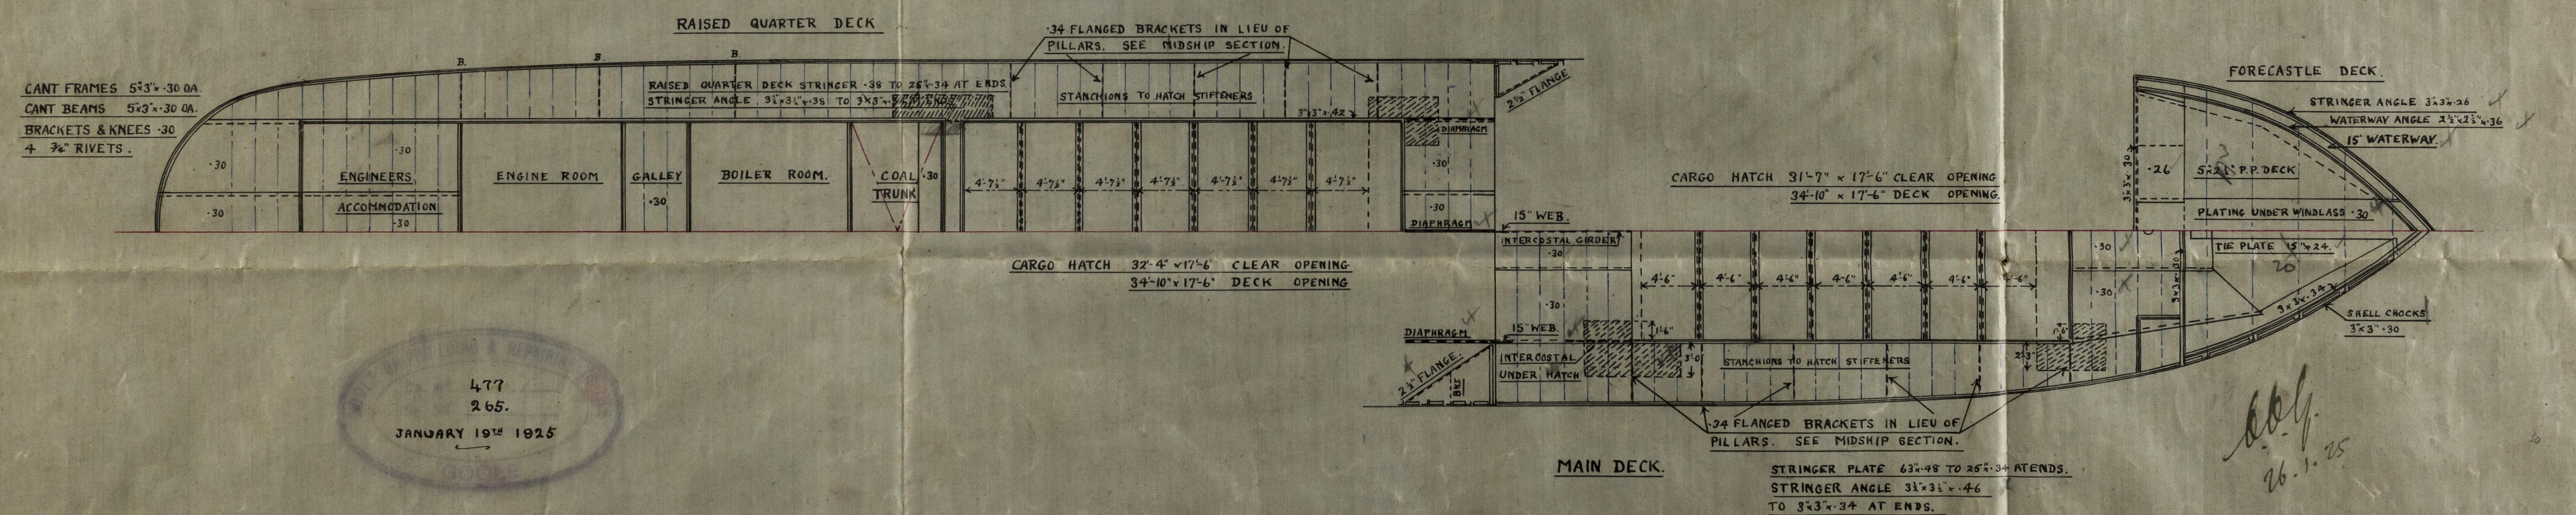


26.1.25

N^o 265. PROFILE & DECKS. DIMS 176'-0" B_P × 28'-6" E_{XT} × 13'-6" M_{LD}. SCALE 1/8" = 1 FOOT.

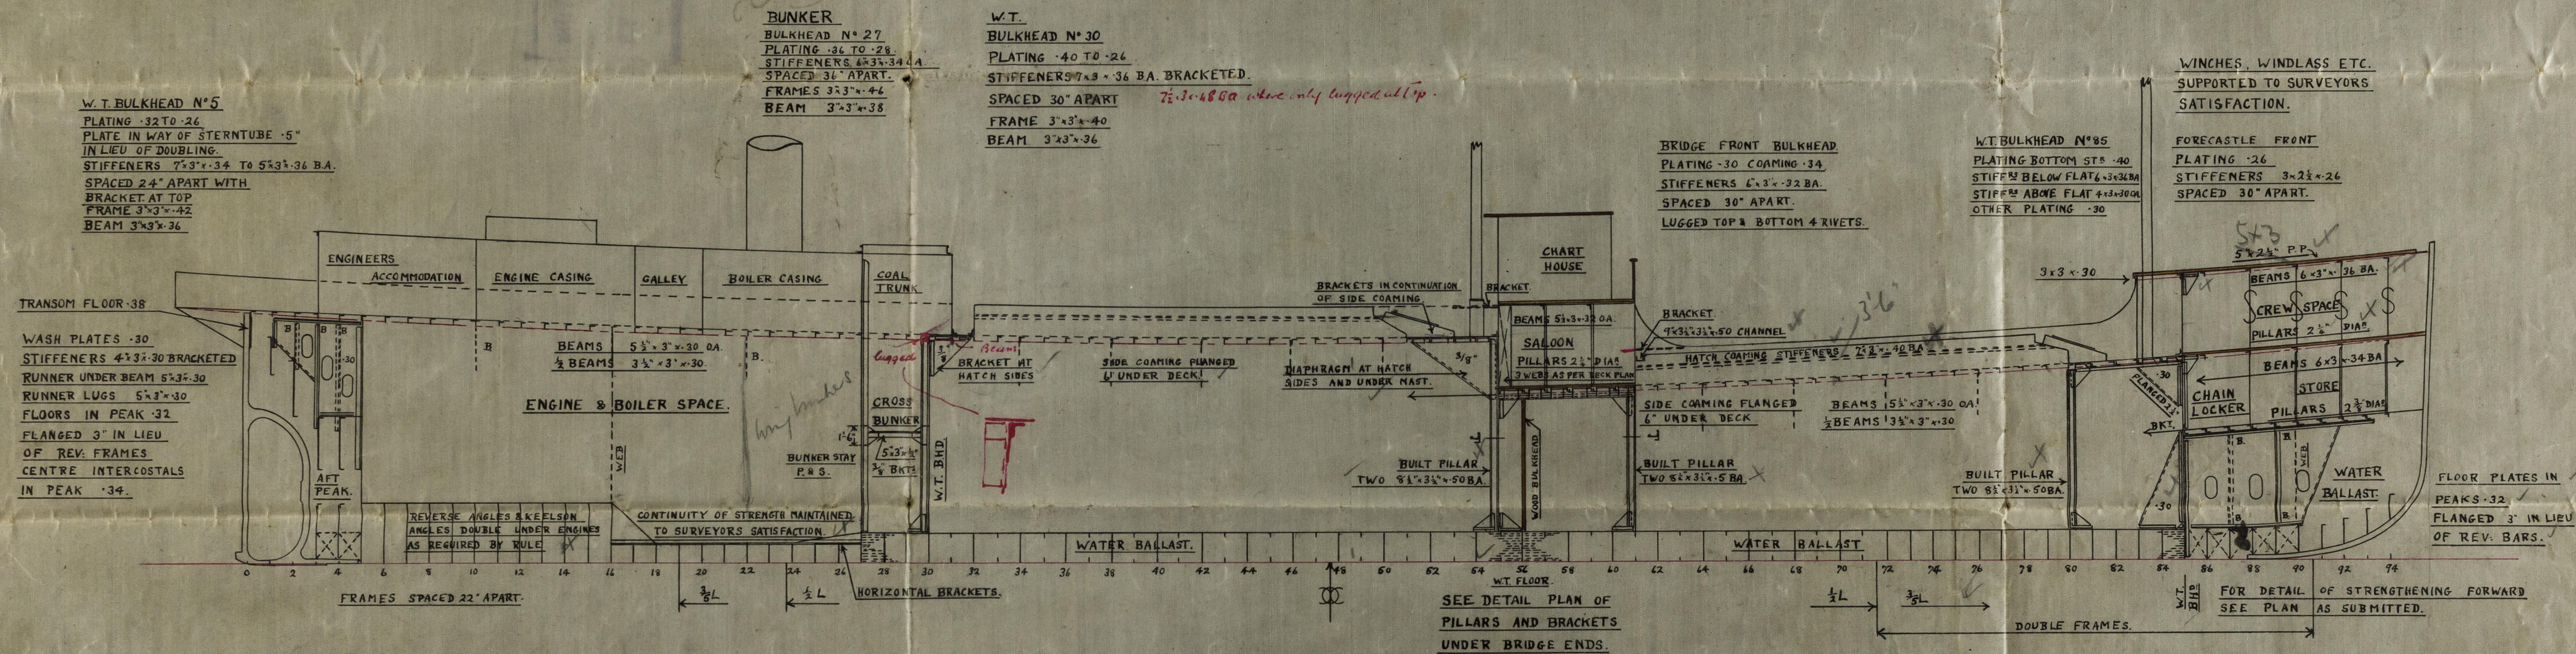

477
 265.
 JANUARY 19th 1925
 GOOLE

26.1.25

GOOLE SHIPBUILDING & REPAIRING CO. LTD.
 GOOLE.

002442-002448-016

No 265

Profile & Decks

Goole S.B. Co.

"Portavon"

140621

BARRA HEAD



© 2021

Lloyd's Register
Foundation

002442-002448-0176

STANDARD
BY THE
BANKHEAD N. 33

No 265
Profile & Decks
Goole S.B. Co.

"Portaon"

BARRA HEAD

002442-002448-0176



© 2021

Lloyd's Register
Foundation