


SS N° 738.

PROPOSED
PROFILE & DECKS

SCALE $\frac{1}{8}'' = 1 \text{ FT.}$

LENGTH 847.5'-0" BREADTH MLD. 68'-0" DEPTH MLD. 36'-0"

31 OCT 1940

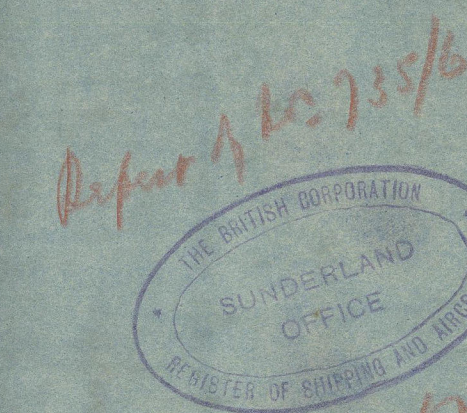

Approved 8/17/40

Chief Engineer

Chief Engineer

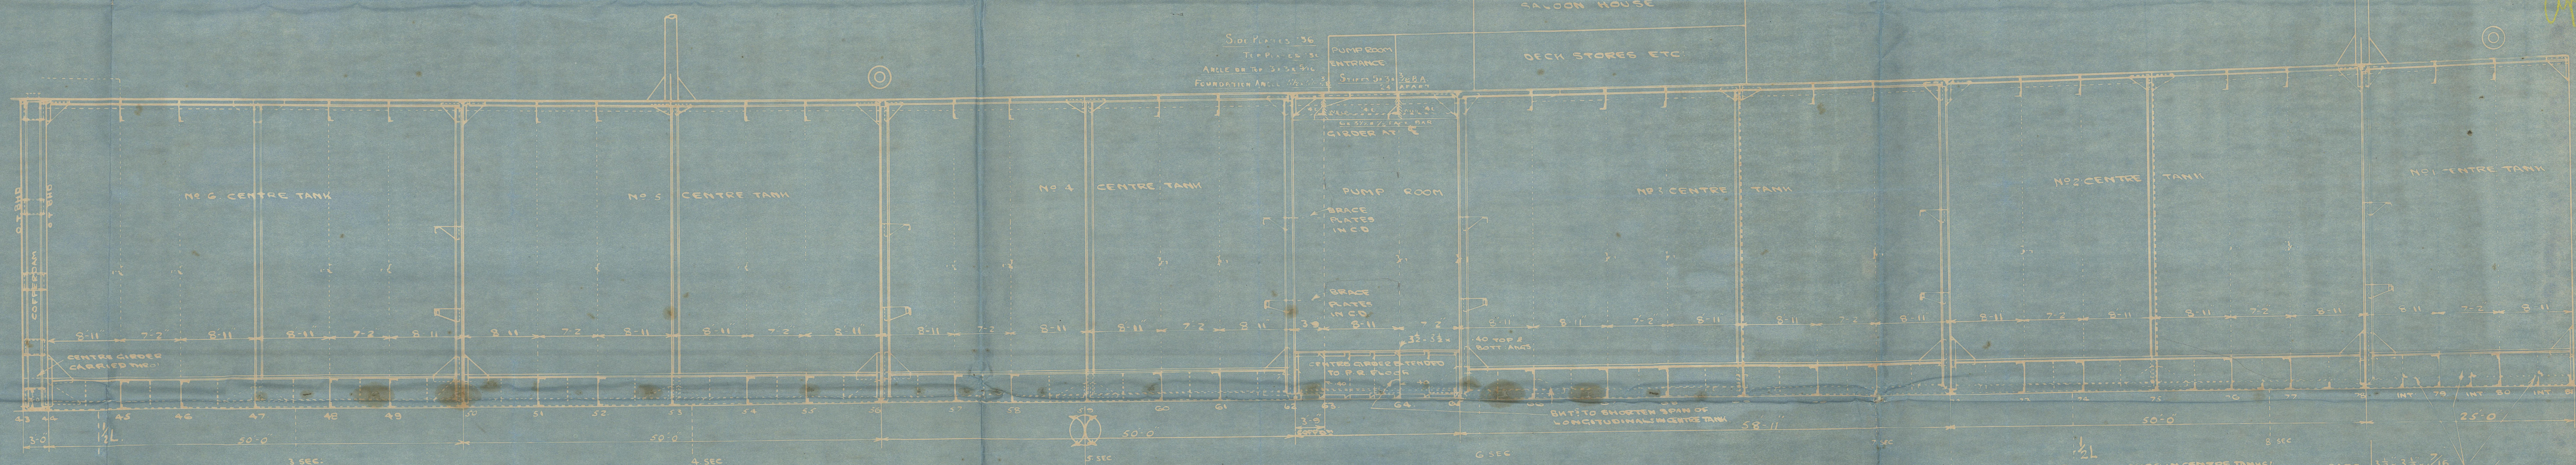

3. All frames marked in
E.L. 25.10
See drawings Report 10

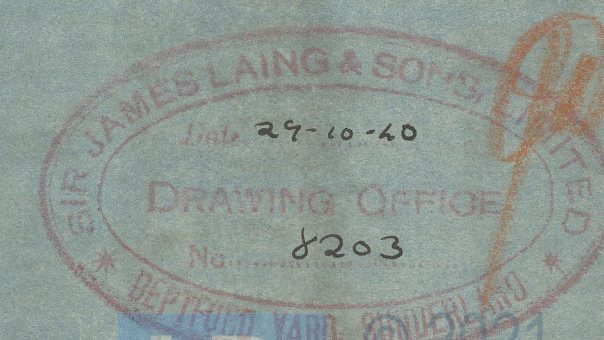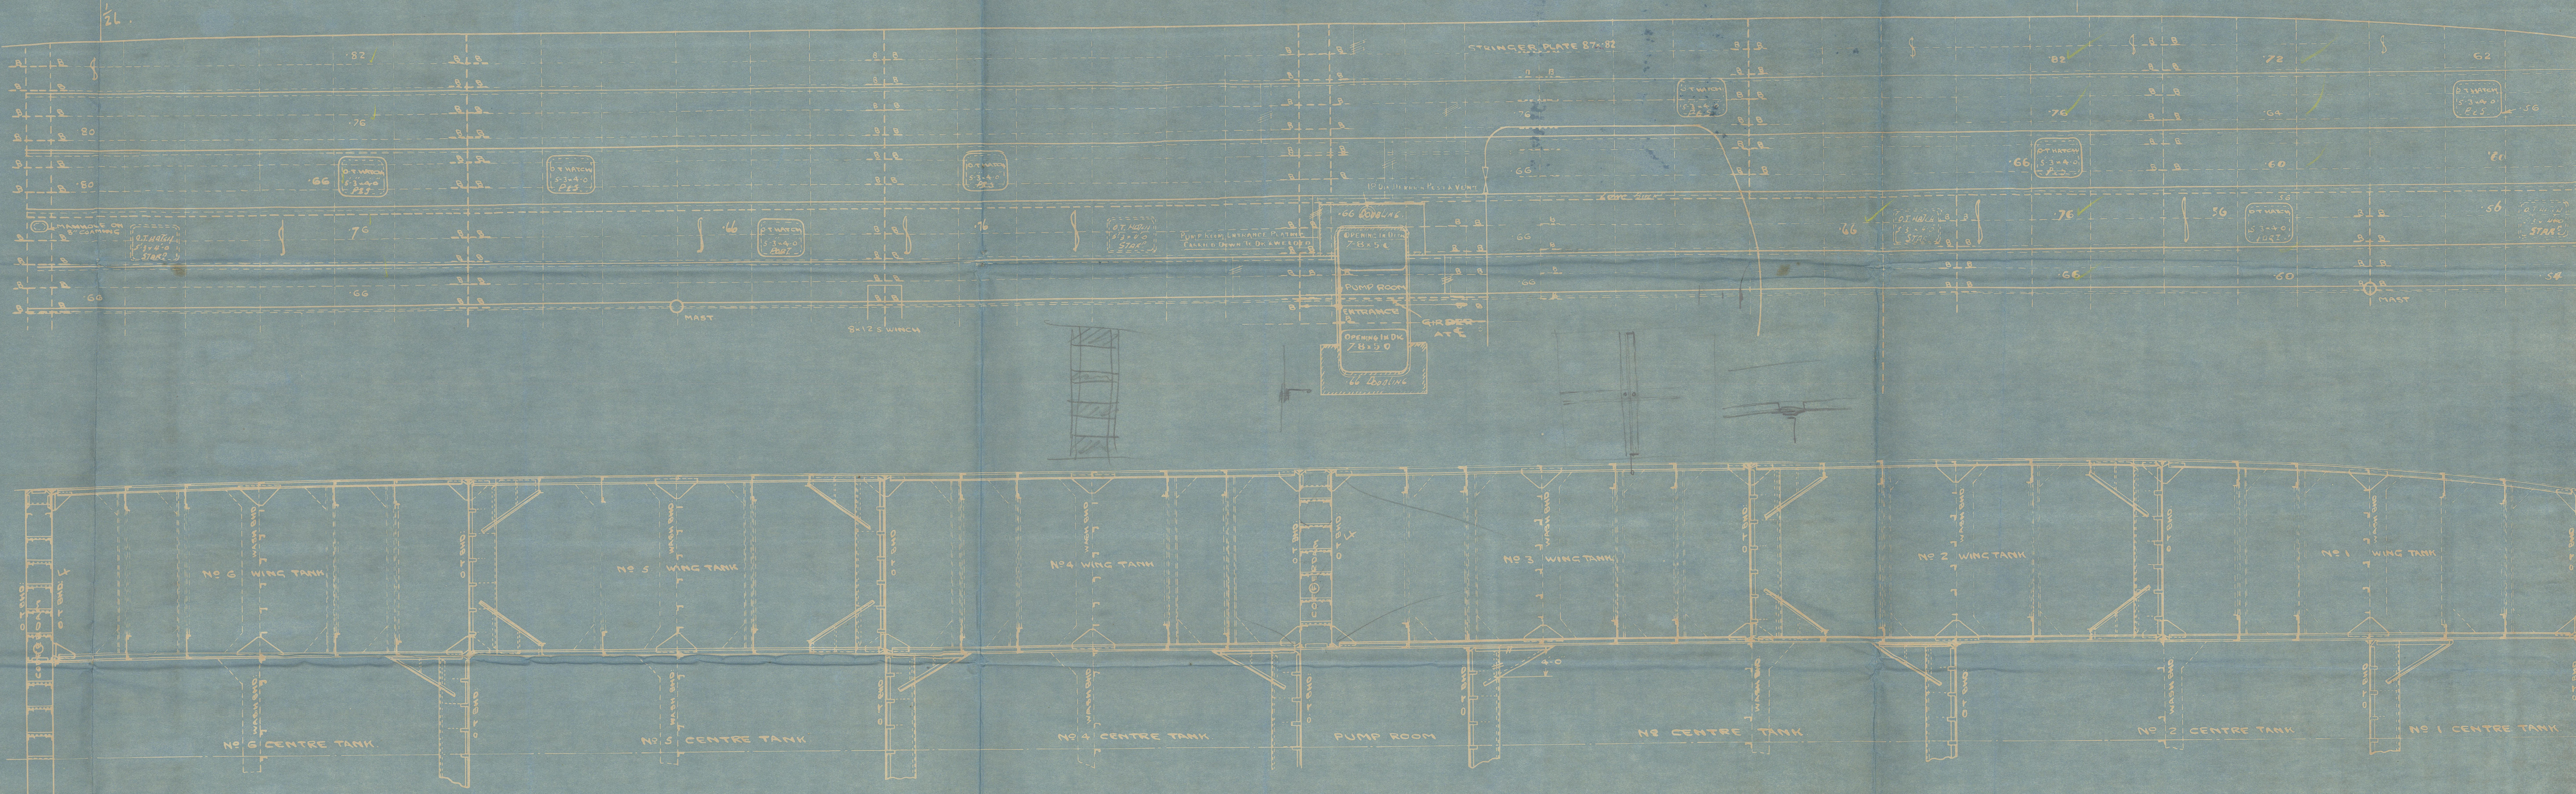

Approved 8/17/40

Chief Engineer

Chief Engineer

002442-002448-0217

'438' Laing's
Profile & Decks



002442-002448-0217



© 2021

Lloyd's Register
Foundation

2

Profile & Deck.

Sir Jaz Laing & Sons

No 728.

T.C. 4.12.40.

H. 11.40.

HAUKEFJELL

EX EMPIRE DRUID

Eagle Oil & Shipping Co Ltd



© 2021

Lloyd's Register
Foundation

002442-002448-0217