



4 JUL 1941

Lloyd's Register of Shipping.

22753

Ship's Name M.V. "OLIVE BANK"Official No. 148889

Memorandum of alterations reported since ship was surveyed for assignment of Load Lines
in SWANSEA.

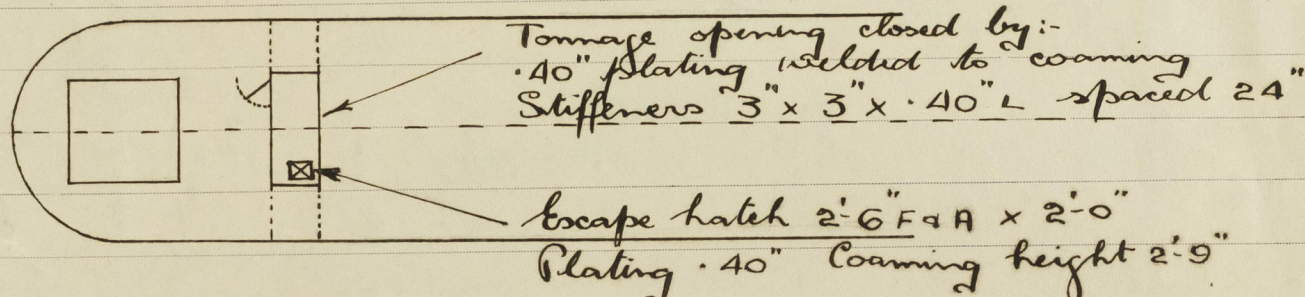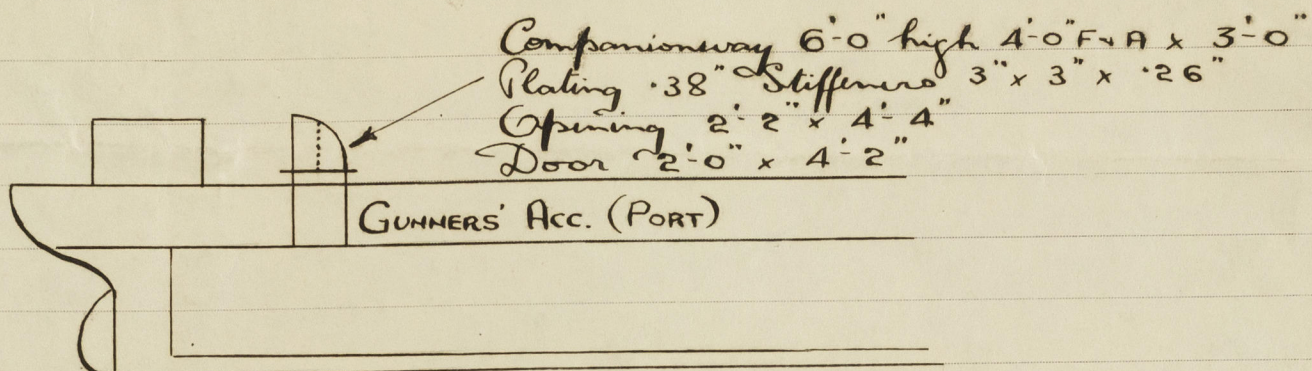

Entrance to Gunners' accommodation protected by steel companion with solid wood $1\frac{1}{2}$ " thick with 20" sill.

Three additional side scuttles 10" dia fitted in way of washhouse and accommodation; side scuttles substantially constructed and fitted with hinged deadlights.

Freeing ports in tonnage well and all overboard scuppers from shelter tween deck spaces permanently closed.

Additional scuppers provided from shelter tween deck spaces to engine room bilge at after end, and existing scuppers in way forward of engine room, led to engine room bilge. Lifelines with suitable end attachments provided.

No sanitary accommodation fitted in tween deck spaces. Watertight bulkheads not extended to shelter deck.

Noted SWB

4/7/41

T. Morris