
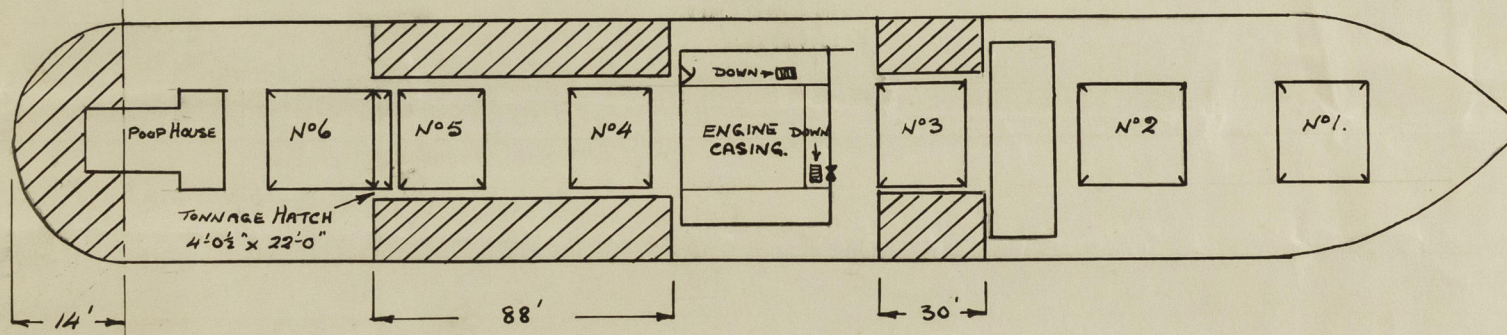
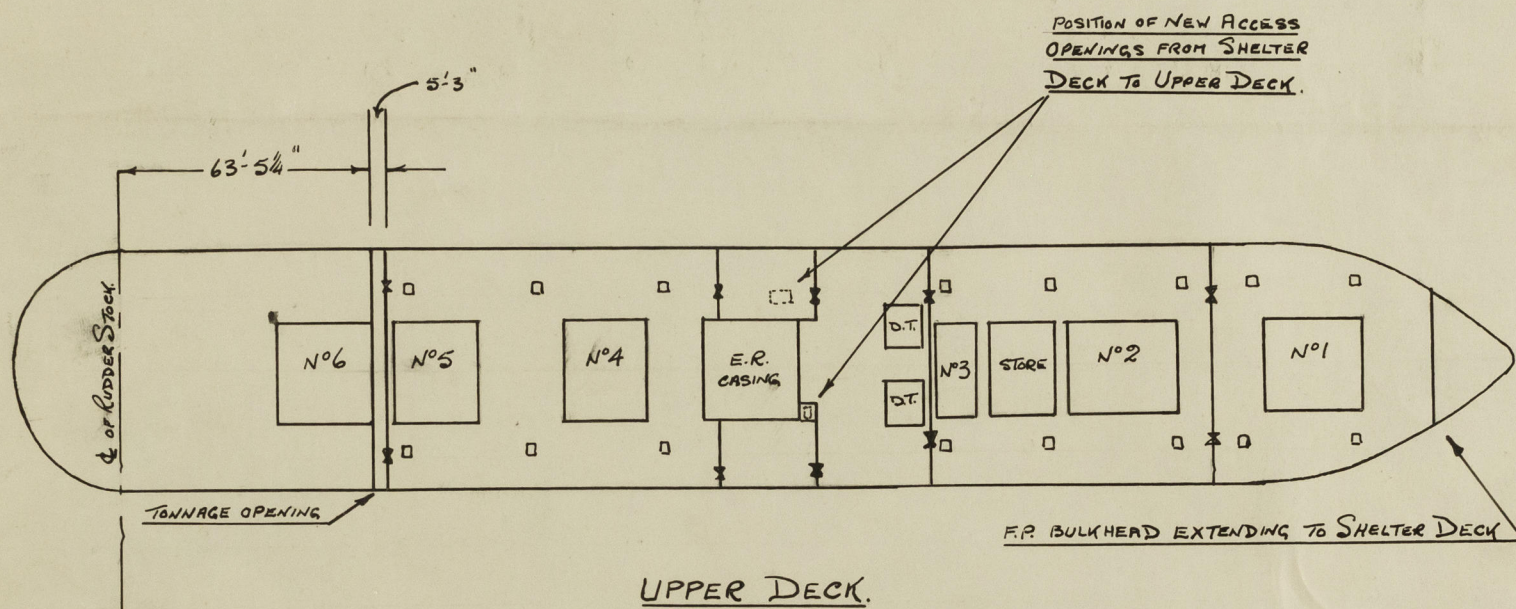


T.S.M.V. "BLYTH NAVIGATOR" (EX-"OLIVEBANK"-54).

24 APR 1954

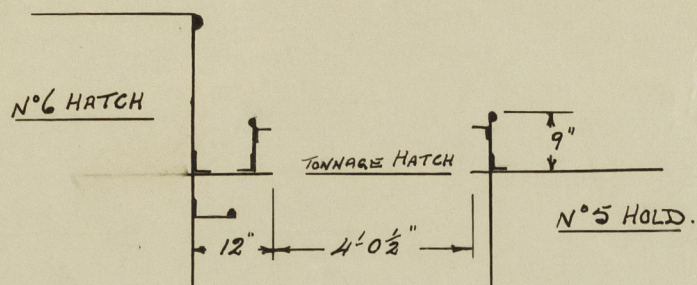

SHELTER DECK SHOWING WOOD SHEATHING REMOVED THUS:-