



Styklisten udføres:					Lystryk:				
Ant.	Bygn. Nr.	Grp. Nr.	Ord. Nr.	Dato	Ant.	Sendt til	Bl. Nr.	Rekv. af	Dato
	3793			18/8 56					

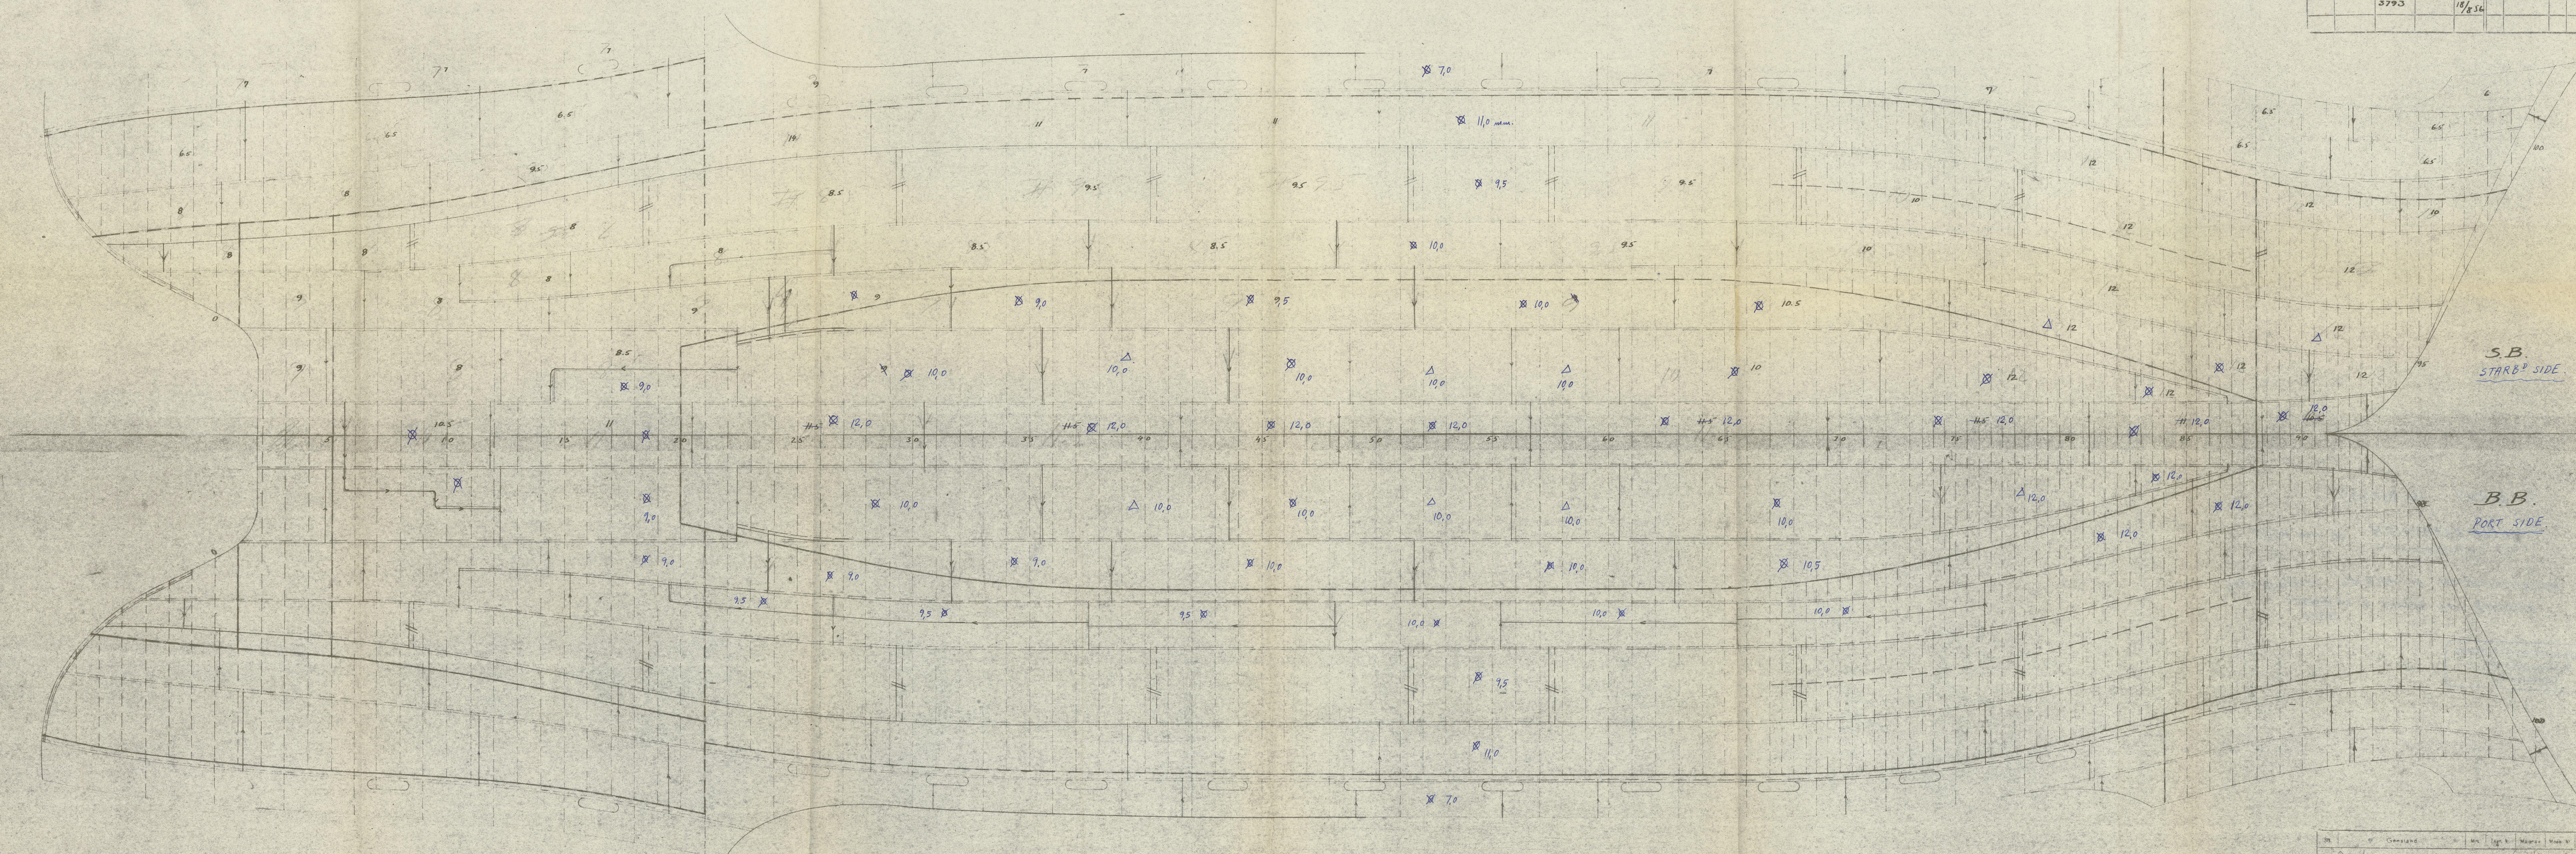

x i.e. renewed
 Δ i.e. removed, faired and refitted.
 Repairs and strengthening of ship in July/August 1956.

AALBORG VÆRFT A/S		TEGNESTUEN	
M/S "Berny"		15-265 D	
København		1956	
SHELL EXPANSION		1956	

RECORDS DEPT.
LONDON.

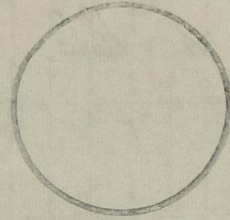

M/S "BERNY" (EX BERGÖ)

SHELL EXPANSION AS NOW BUILT

RECLASSIFICATION AT AALBORG JULY/AUG. 1956.

ATTACHED CPN. REPORT 8. N^o ~~15948~~
15920

LLOYD'S REGISTER OF SHIPPING
St. Kongensgade 49,¹
Copenhagen K.



© 2020

Lloyd's Register
Foundation

002457-002464-0156