


MATERIAL:- FORGED IRON.

ELEVATION.


PLAN:

ELEVATION.

ELEVATION OF BOTTOM GUDGEON

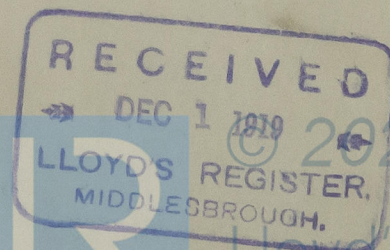

© 2020
Lloyd's Register
Foundation

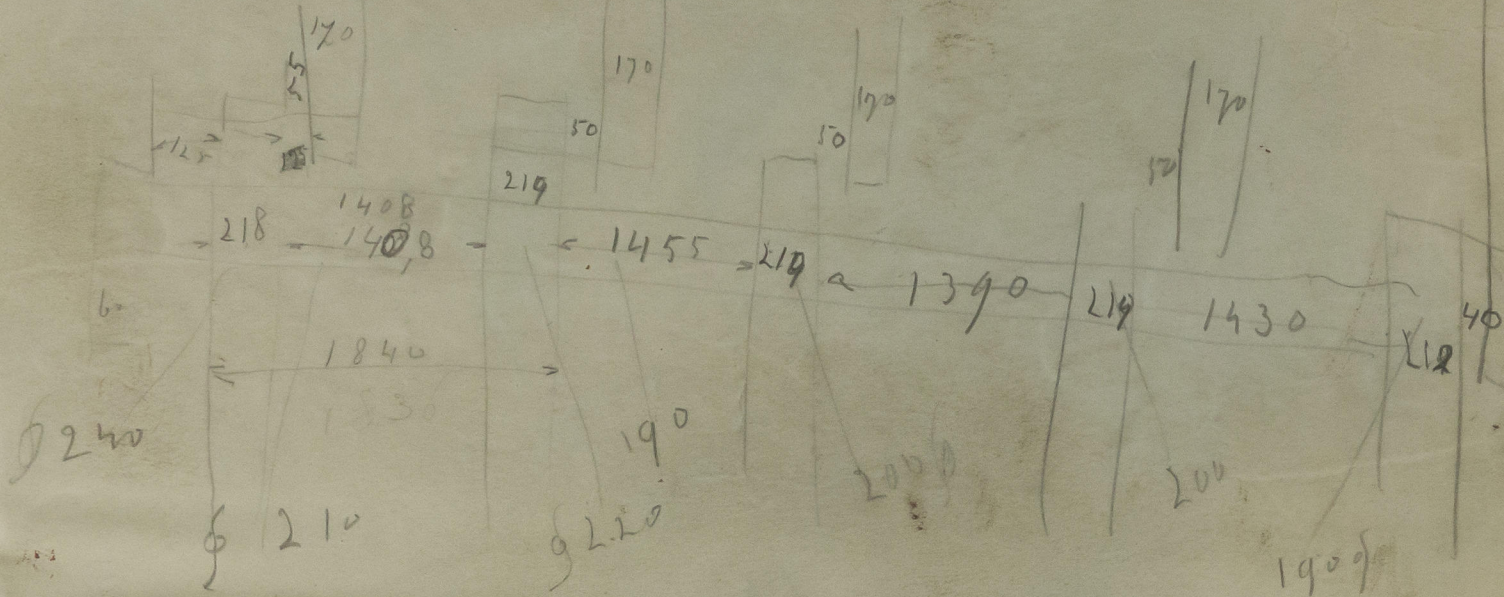

002465-002470-0046



© 2020


Lloyd's Register
Foundation

002465-002470-0046

MESSRS SMITHS DOCK CO.

No 759.

STERN FRAME & RUDDER
MIDDLESBRO' 10782

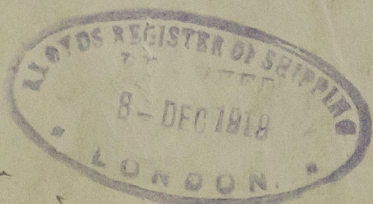


ex Maria Christina
n/a Anteti

SMITH'S DOCK COMPANY, LTD.,
SHIPBUILDING DEPT.,
SOUTH BANK, S.O.

TO BE ENCLOSED TO

Lloyds Mbro'

RECORDS DEPT.,
LONDON.

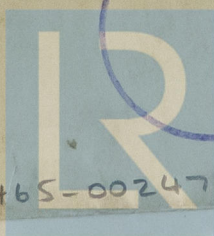

© 2020

Lloyd's Register
Foundation

002465-002470-0046