


See sketch

S.S. "Maria Christina"

FREEBOARD MARKING FOR STEAMERS.

ex "VRD"

Nº 75966 in the Register Book

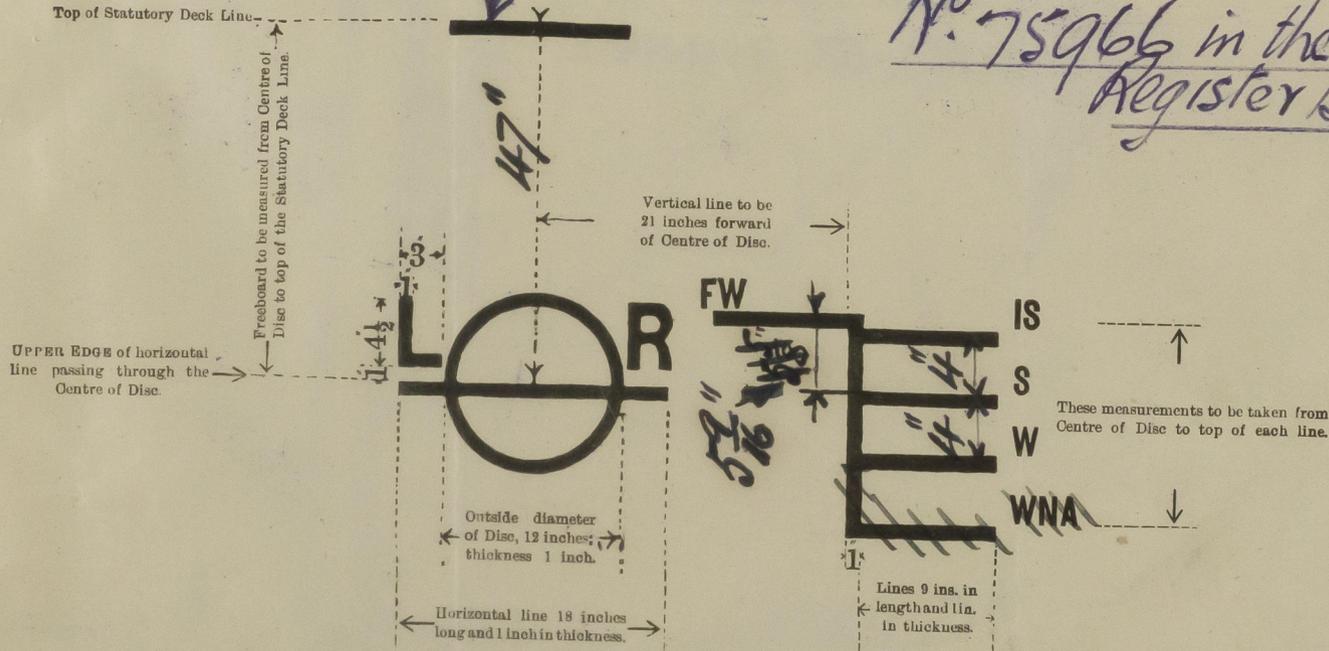

The Centre of Disc to be placed on both sides of vessel amidships, i.e., at the middle of the length of the load water line. Vessels are to be marked with such of the horizontal lines as are applicable to the nature of their employment. In accordance with the Regulations made by the Board of Trade, the discs and lines must be permanently marked by centre punch marks or cutting, and the particulars given in the Certificate are to be entered in the official log.

4'2-3/4"
3'10-1/2"
3'6-1"4"
✓
red the { 1-3/4"
4'4-1/2"
4'0-1/4"
3'8"
✓
1/2"
✓
1/2"
✓



Lloyd's Register Foundation

002465-002470-0085

002465-002470-0086