


			- .67	32 = +.14	
					level tank.
CORRECTED DIMENSIONS.	333.54	47.33	23.75	2972.96	

CORRECTION FOR LENGTH.	
Length of Ship on Loadline.....	333.54
Length in Table	299
Difference	34.54
Correction for 10ft., Table A.....	1.3
Table C. 0.7	
(if required.)	2.42
	+ 2-

Coefficient of fineness .79 / .788

SS MARIA CHRISTINA EX "URD."

DIMENSIONS TAKEN FOR POSITION OF STATUTORY DECK LINE

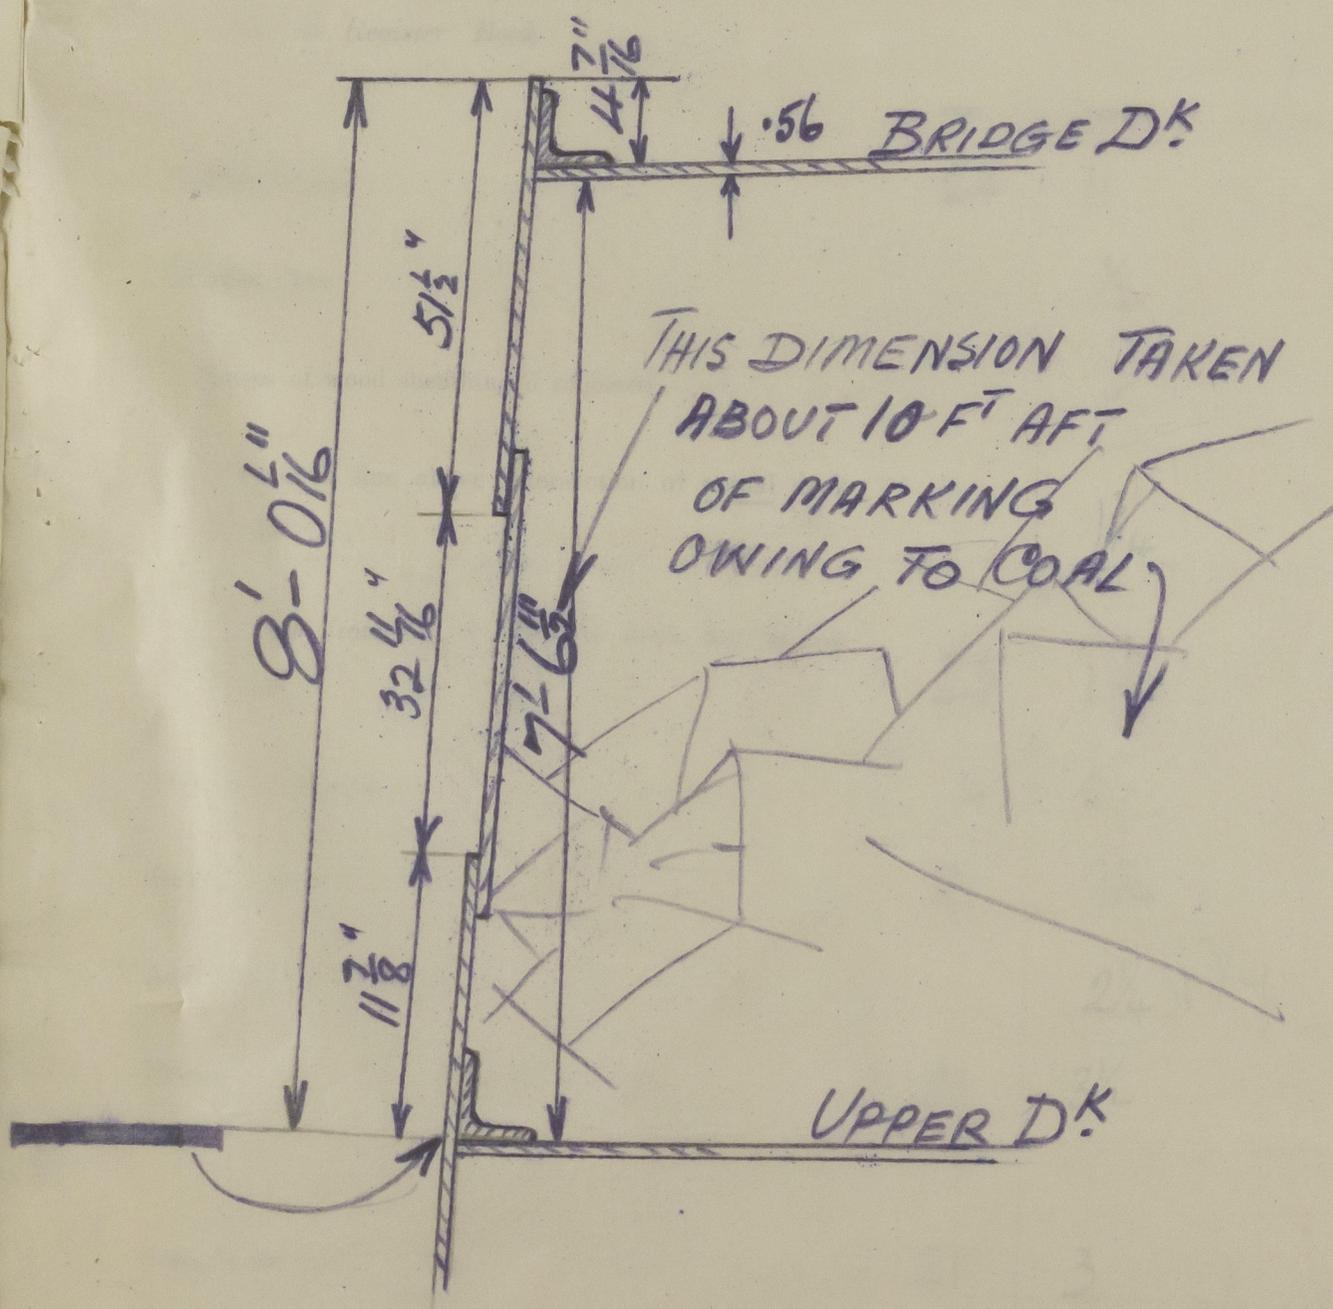

DECK.
ered :.4974
3-1/2".
-1-3/4".

ND OF BEAM.
+ 2 = 1/8"
86

4'2-3/4
3'10-1/2
3'6-1" ✓

measured
on at the } 1-3/4

4'4-1/
4'0-1/
3'8" ✓

4'0"
5-1/2"
4"
4-1/2" ✓

LISBON 2020
JANRY 1923
Lloyd's Register
Foundation

002465-002470-0086

ships the height of the R.Q.D. is to be taken from the level of the top of the amidship beam.
In flush-decked vessels the standard mean sheer means the sheer measured at the stem and stern-post. In vessels with forecastles, it means the sheer measured at points distant one-eighth of the length from the stem and stern-post.

line of keel or to the water line. If measured relatively to water line the vessel's draft at survey, and also the usual load draft forward and aft should be reported.

002465-002470-0088

MARKING F