




VENTS TO W.C.6 AND FIREMEN'S  
WASH ALREADY ON SHIP.

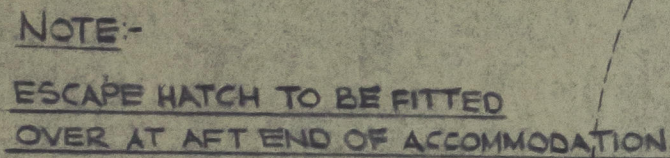

UPPER DECK 12"  
GLASS PANEL IN DOORS OFF PASSAGEWAY  
CABIN BULKHEADS MADE OF WOOD.




Prep. the argt. of Grew's Accom<sup>n</sup>

2½ GOTHLAND.

21.8.15.

31 AUG 1945

2½ GOTHLAND.

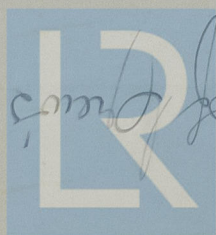

© 2020

Lloyd's Register  
Foundation

- Prep. the argt. of Grew's Accom<sup>n</sup>