

12.12.29

SECTION 2745% FROM CENTRE LINE

SECTION IN WAY OF ENGINE CASING FRAME 38

IN WAY OF DAVITS PARTICULARLY STRENGTHENED





GIRDER DETAIL

SECTION 2500% FROM CENTRE LINE


POOP DECK
SCALE 1:50

FORECASTLE DECK
SCALE 1:50

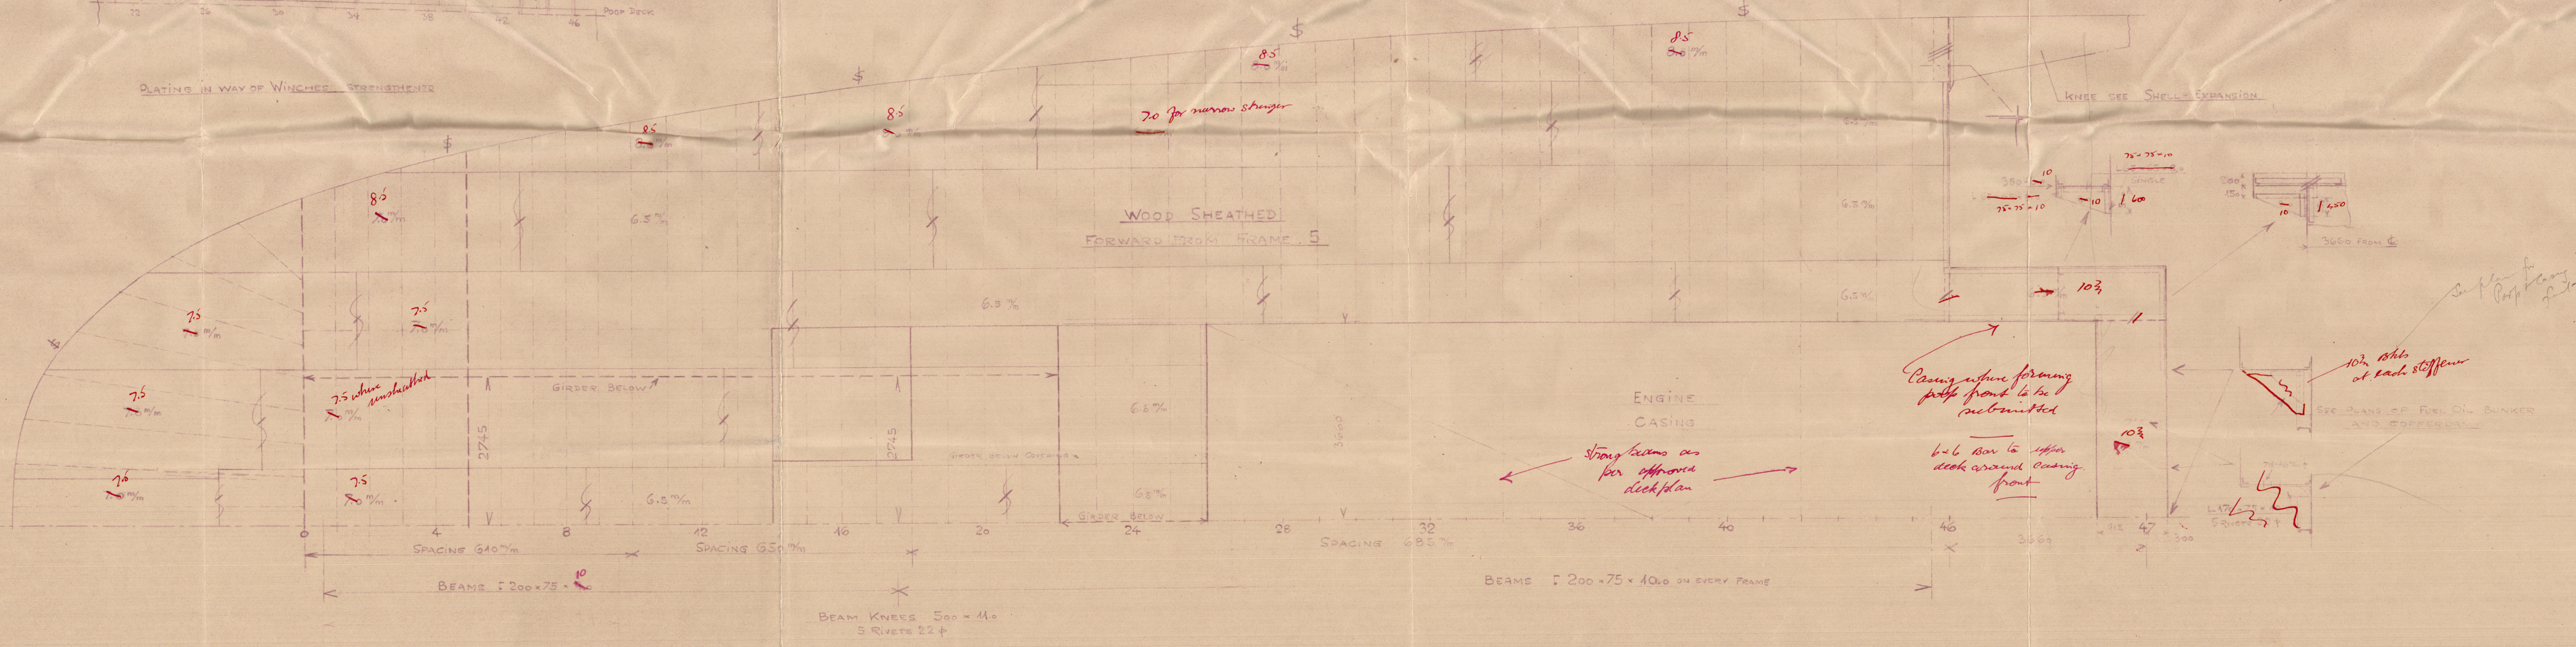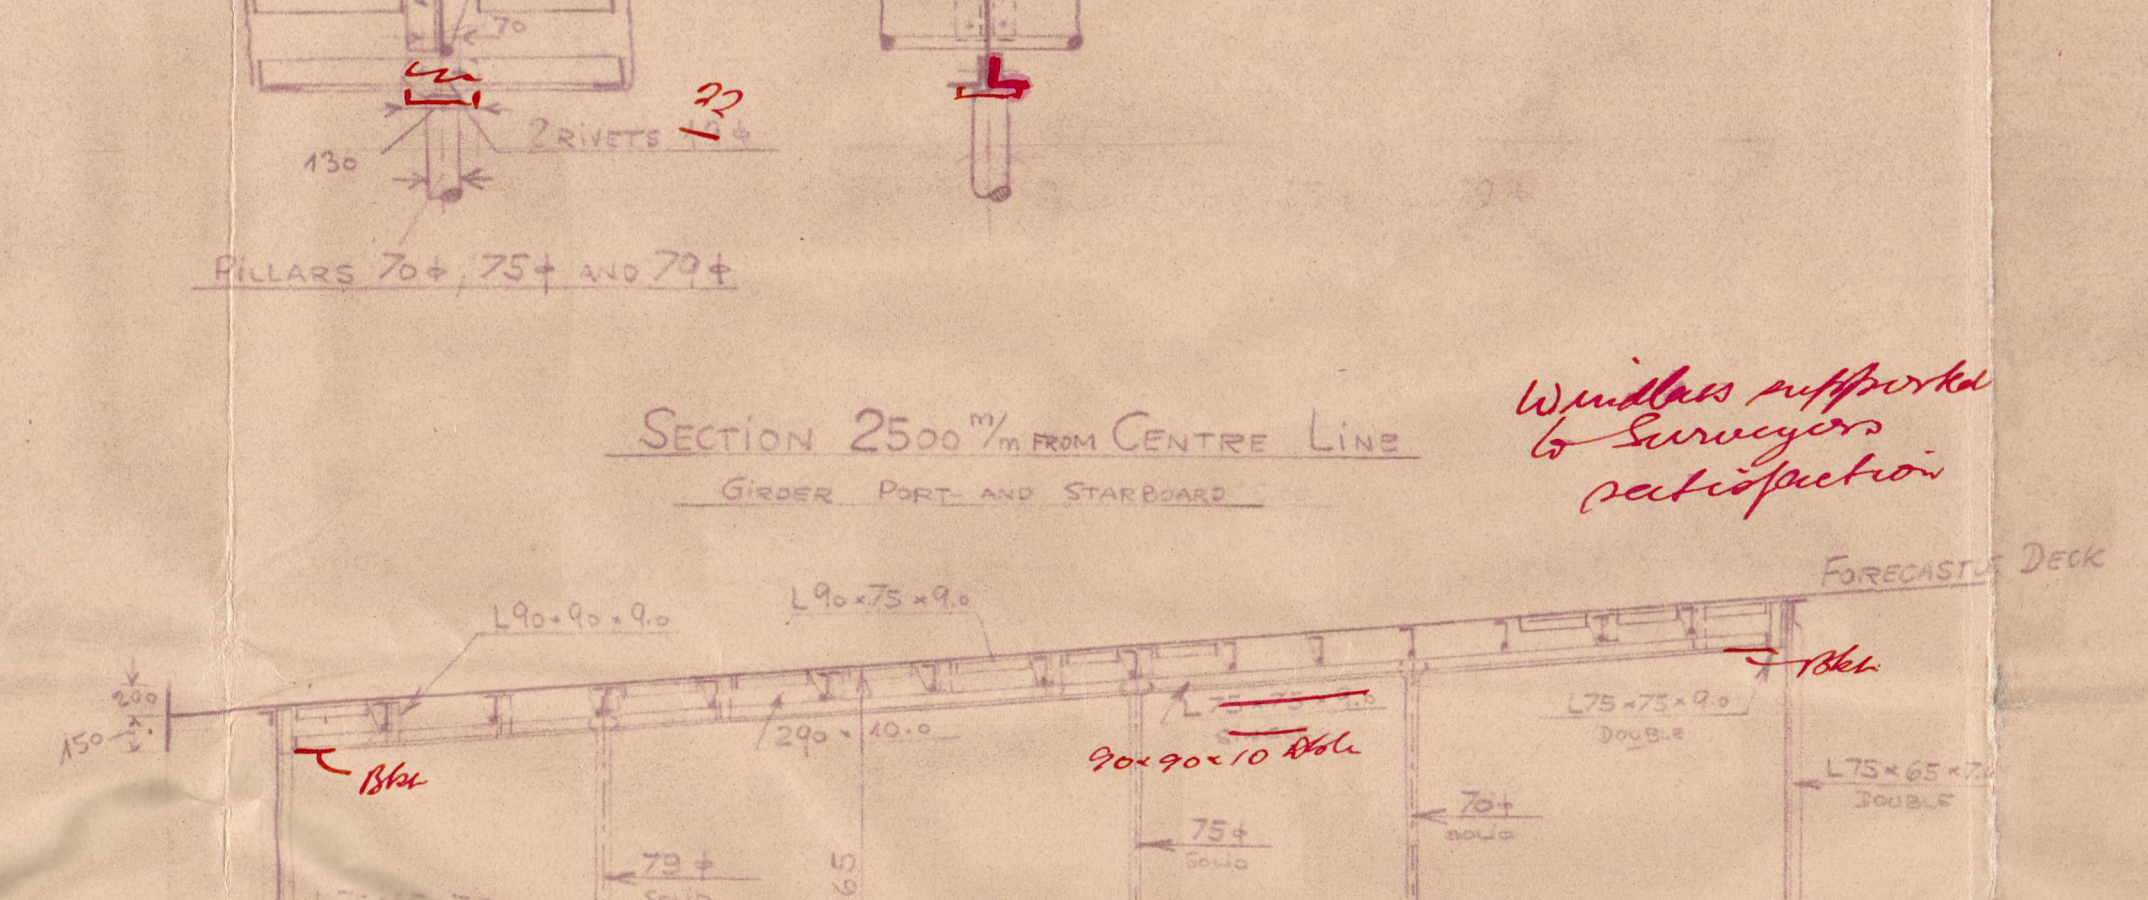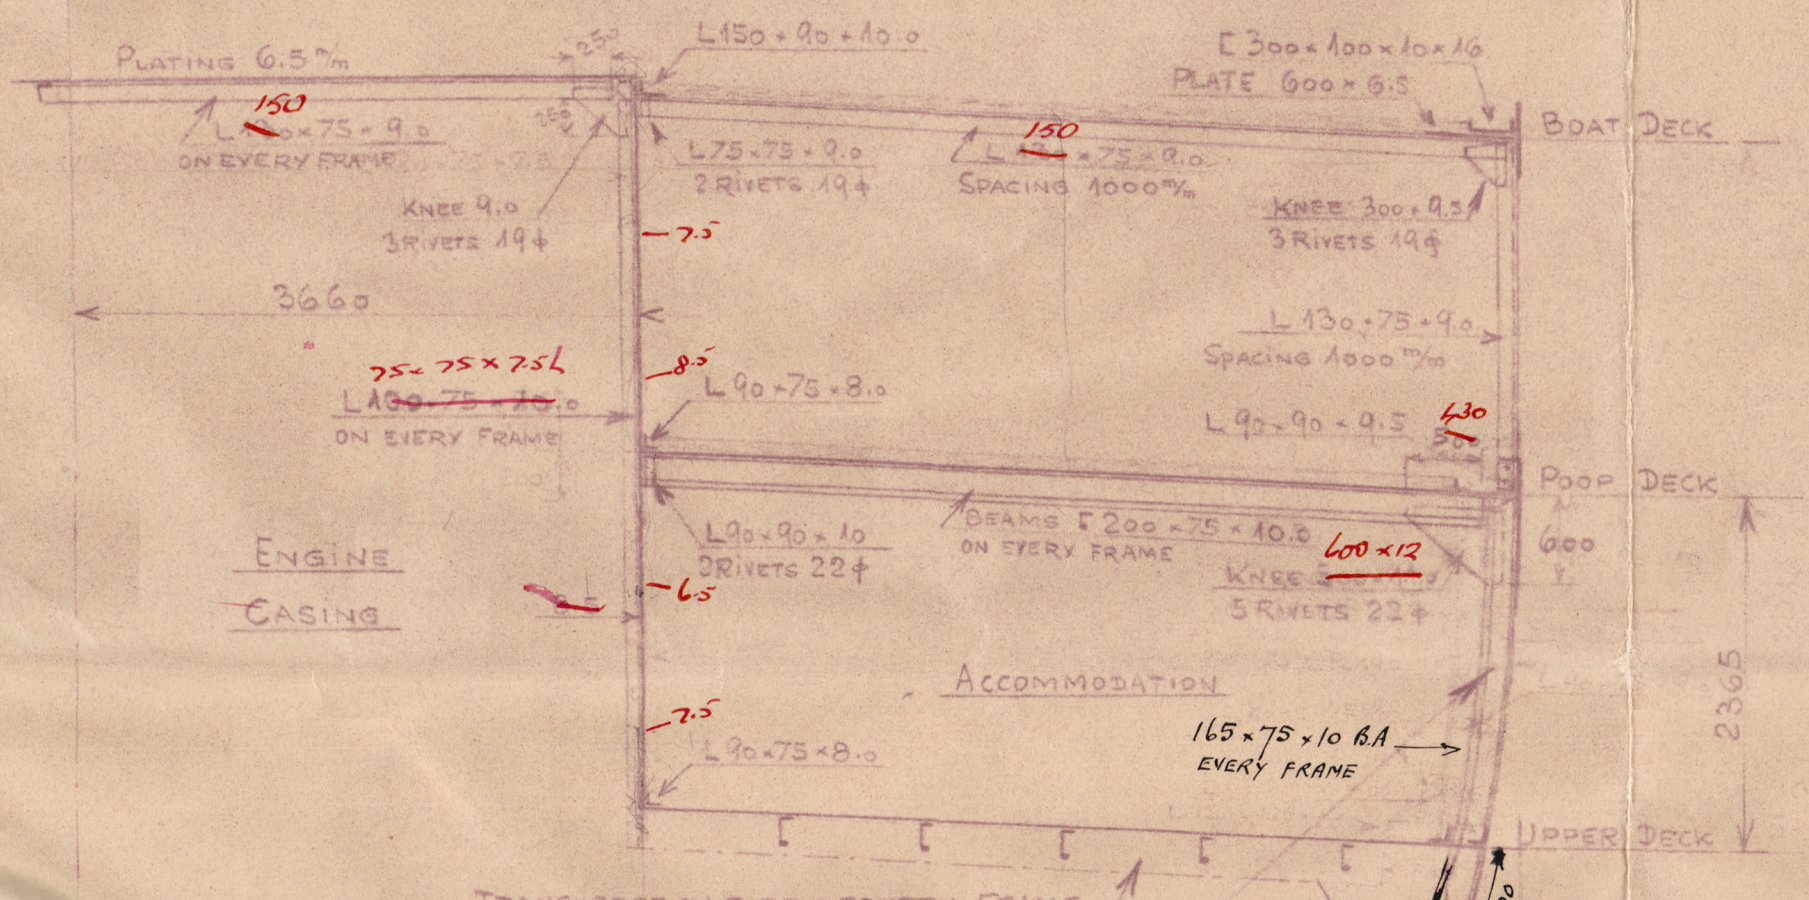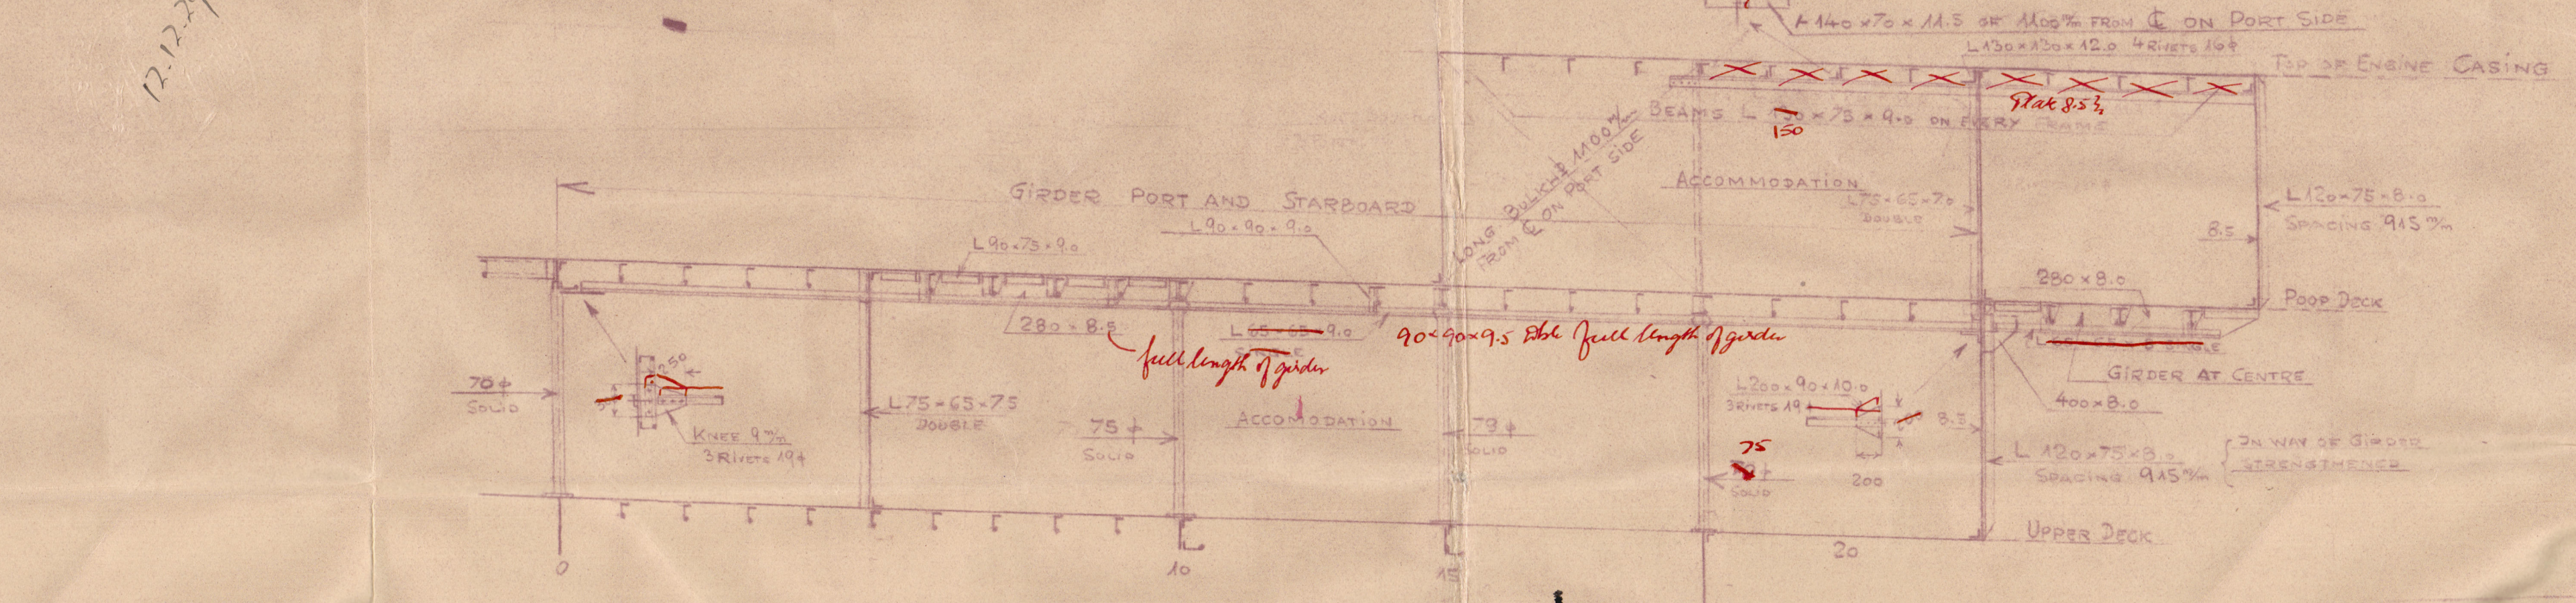

11.S.

AKTIEBOLAGET GÖTAVERKEN

M/S 442 & 445

POOP DECK AND FORECASTLE DECK

anna Kruken
John Kruken

KALKER AV
GRANSKAD

SKALA 1:50
DATUM 3.12.29

DATUM 5.12.1929