

SS N° 787<sup>M</sup>

# MIDSHIP SECTION

SCALE: 1/2" = 1 FOOT.

DIMENSIONS: 270' 0" B.P. x 37' 0" M.D. x 18' 6" M.D. TO MAIN DECK.

CLASS B.S. \*

DRAFT: APPROX. 17' 0"

## PROPORTIONS.

DEPTH TO BREADTH	$\frac{18.5}{37}$	=	.50.
LENGTH TO DEPTH (MAIN D <sup>W</sup> )	$\frac{270}{18.5}$	=	14.6.
" (POOP D <sup>W</sup> )	$\frac{28}{26}$	=	10.4.

$$\frac{270 \times 37 \times 26 \times 78}{100} = 1947.$$

$$\frac{100 \times 37 \times 7.5 \times 50}{100} = 169$$

$$\frac{2116}{100}$$

30 SEP. 1929

Approved J.B.  
S.P. 26

## FRAMING

FRAMES 3 TO 7 5'-3" x 36" O.A. TO POOP DECK CUT & BRACKETED AT W.T. PLAT. REV. FR. 3'-3" x 36" FR. 4 TO 8 LOWER TO MAIN DECK.  
 9 TO 11 5'-3" x 36" O.A. TO POOP DECK. REV. FR. 3'-3" x 36" TO LOWER DECK AT PRO. 9 L.I. AND TO MAIN DECK AT PRO. 10 & 12.  
 13 TO 42 5'-3" x 36" O.A. ALTERNATELY TO MAIN DECK POOP DECK WITH INTERMEDIATE FR. MAIN TO POOP DECK 5'-3" x 36" SCARPHED 12".  
 REV. FR. 13 TO 42 3'-3" x 36" TO LOWER DECK MAIN DECK AT HATCH END BEAMS C.F. 14 V.  
 FRAMES 44 TO 53 7'-5" x 36" B.A. TO MAIN DECK.  
 54 TO 75 9'-3" x 48" B.A. TO MAIN DECK.  
 44 TO 87 5'-3" x 36" O.A. TO MAIN DECK POOP DECK ALTERNATELY SCARPHED 15" TO MAIN FR. WITH 3'-3" x 36" BETWEEN.  
 MAIN DECK DECK DECK ALTERNATELY SCARPHED 12" TO MAIN FR. INTERMEDIATE STIFFENER BETWEEN POOP DECK DECK.  
 3'-3" x 36" STIFF. AT 5'-3" x 36" O.A. CARRIED UP TO POOP DECK AT FORE END OF POOP. REV. FR. FROM FR. 27 TO 28 TO LOWER DECK 5'-3" x 36".  
 FRAMES 88 TO 112 5'-3" x 36" O.A. TO MAIN DECK WITH REV. FR. 3'-3" x 36" TO LOWER DECK TO MAIN DECK AT HATCH END BEAMS EXCEPT FR. 106.  
 113 TO 126 5'-3" x 36" O.A. TO FORECASTLE DECK WITH REV. FR. 3'-3" x 36" TO LOWER DECK.  
 127 TO 130 5'-3" x 36" O.A. TO FORECASTLE DECK CUT & BRACKETED AT W.T. PLAT. WITH REV. FR. 3'-3" x 36" TO LOWER DECK.  
 131 TO 134 5'-3" x 36" O.A. TO FORECASTLE DECK CUT & BRACKETED AT W.T. PLAT. WITH REV. FR. 3'-3" x 36" TO LOWER DECK.  
 135 TO 138 5'-3" x 36" O.A. TO FORECASTLE DECK CUT & BRACKETED AT W.T. PLAT. WITH REV. FR. 3'-3" x 36" TO LOWER DECK.  
## FORGINGS

STEM: 7' 6" x 6" PROP. POST. RUDDER FRAME 7' 6" x 6" INCLUDES 10% INCREASE AS PER SPEC.  
 RUDDER: PLANS OF RUDDER & STERN FRAME WILL BE SUBMITTED.

## EQUIPMENT

UNDER DECK	270' x 37' x 18' 6" = 1205
POOP & BRIDGE	176' 6" x 37' x 7' 5" = 246
FORECASTLE	43' x 37' x 7' 5" = 150
UPPER BRIDGE	100' x 36' x 7' 5" = 200
STEERING GEAR HOUSE	26' x 14' x 7' 5" = 11
BRIDGE HOUSE	18' 5" x 20' 5" x 7' 5" = 200
	1634

## EQUIPMENT

2 DOWN ANCHORS EACH 31 CWT. STOCKED ✓  
 1 30' 4" ✓  
 1 STREAM 8' 2" INCLUDING STOCK ✓  
 240 FATHOMS 1 1/2" STUD CHAIN CABLE ✓  
 75 3 1/2" S.W.R. IN LIEU OF STREAM CHAIN ✓  
 100 4" S.W.R. ✓  
 2 @ 30' 2 1/2" S.W.R. ✓  
 2 @ 90' 6" HAWSE ✓  
 2 @ 90' 5" WARPS ✓


## RIVETING

PLATE PLATE KEEL BUTTS 3R FOR 1/2" 3R TO 2R WHERE UNDER 1/2" AT ENDS.  
 CENTRE GIRDER 2R 3R IN B.S.  
 TANK TOP CE STRAKE 2R 3R IN B.S.  
 PLATING 1R 2R IN B.S.  
 MARGIN PLATE 2R ✓  
 SHELL STRAKES ✓  
 A.B.C.D.E.F. BUTTS 3R FOR 1/2" 2R AT ENDS.  
 F.W. WELLS BUTTS 4R FOR 1/2" 3R AT ENDS.  
 G 3R FOR 1/2" 2R AT ENDS.  
 H.E.J. 2R 3R FOR 1/2" 1R AT ENDS.  
 P.B.E. DECK STRINGER BUTTS 2R 3R FOR 1/2" 1R AT ENDS.  
 MAIN DECK STRINGER 2R 3R FOR 1/2" 1R AT ENDS.  
 LOWER 2R ✓  
 P.B.E. DECK PLATING 2R 3R FOR 1/2" 1R AT ENDS.  
 MAIN 2R 3R FOR 1/2" 1R AT ENDS. 3R AHEAD HATCH.

## SPACING OF RIVETS

SIDE FRAMES TO SHELL SPACED 7 DIAS. APART C.F. TO C.F.  
 IN AFT PEAK C.F. FROM KEEL TO ABOVE LOAD LINE FOR 40' 0" AFT OF STEM SPACED 5/2 DIAS. C.F. TO C.F.  
 DOUBLE BOTTOM FRAMES TO SHELL 7 DIAS. 5/2 DIAS. FOR 40' 0" AFT OF STEM.  
 TANK TOP TO REV FRAMES 7 DIAS. 5/2 DIAS. IN ENGINE SPACE 1/2 DIAS. IN ENGINE SPACE C.F. TO THRUST SEAT.  
 ALT ✓  
 SIDE FRAMES TO REVERSE FRAMES 7 ✓  
 END FRAMES 7 ✓  
 REV 7 ✓  
 BOTTOM FRAMES TO FLOORS 7 ✓  
 NO. OF RIVETS IN EACH ROW OF SHELL LANDING, 6 1/2 RIVETS, 5 1/2 RIVETS, INCLUDING RIVETS IN FRAMES.

BOAT DECK  
 STRINGER PLATE 36" x 3/4"  
 ANGLE 3" x 3/4" x 30" V. 1/2" B.S.  
 DECK SHEATHED WITH 1/2" S.P.

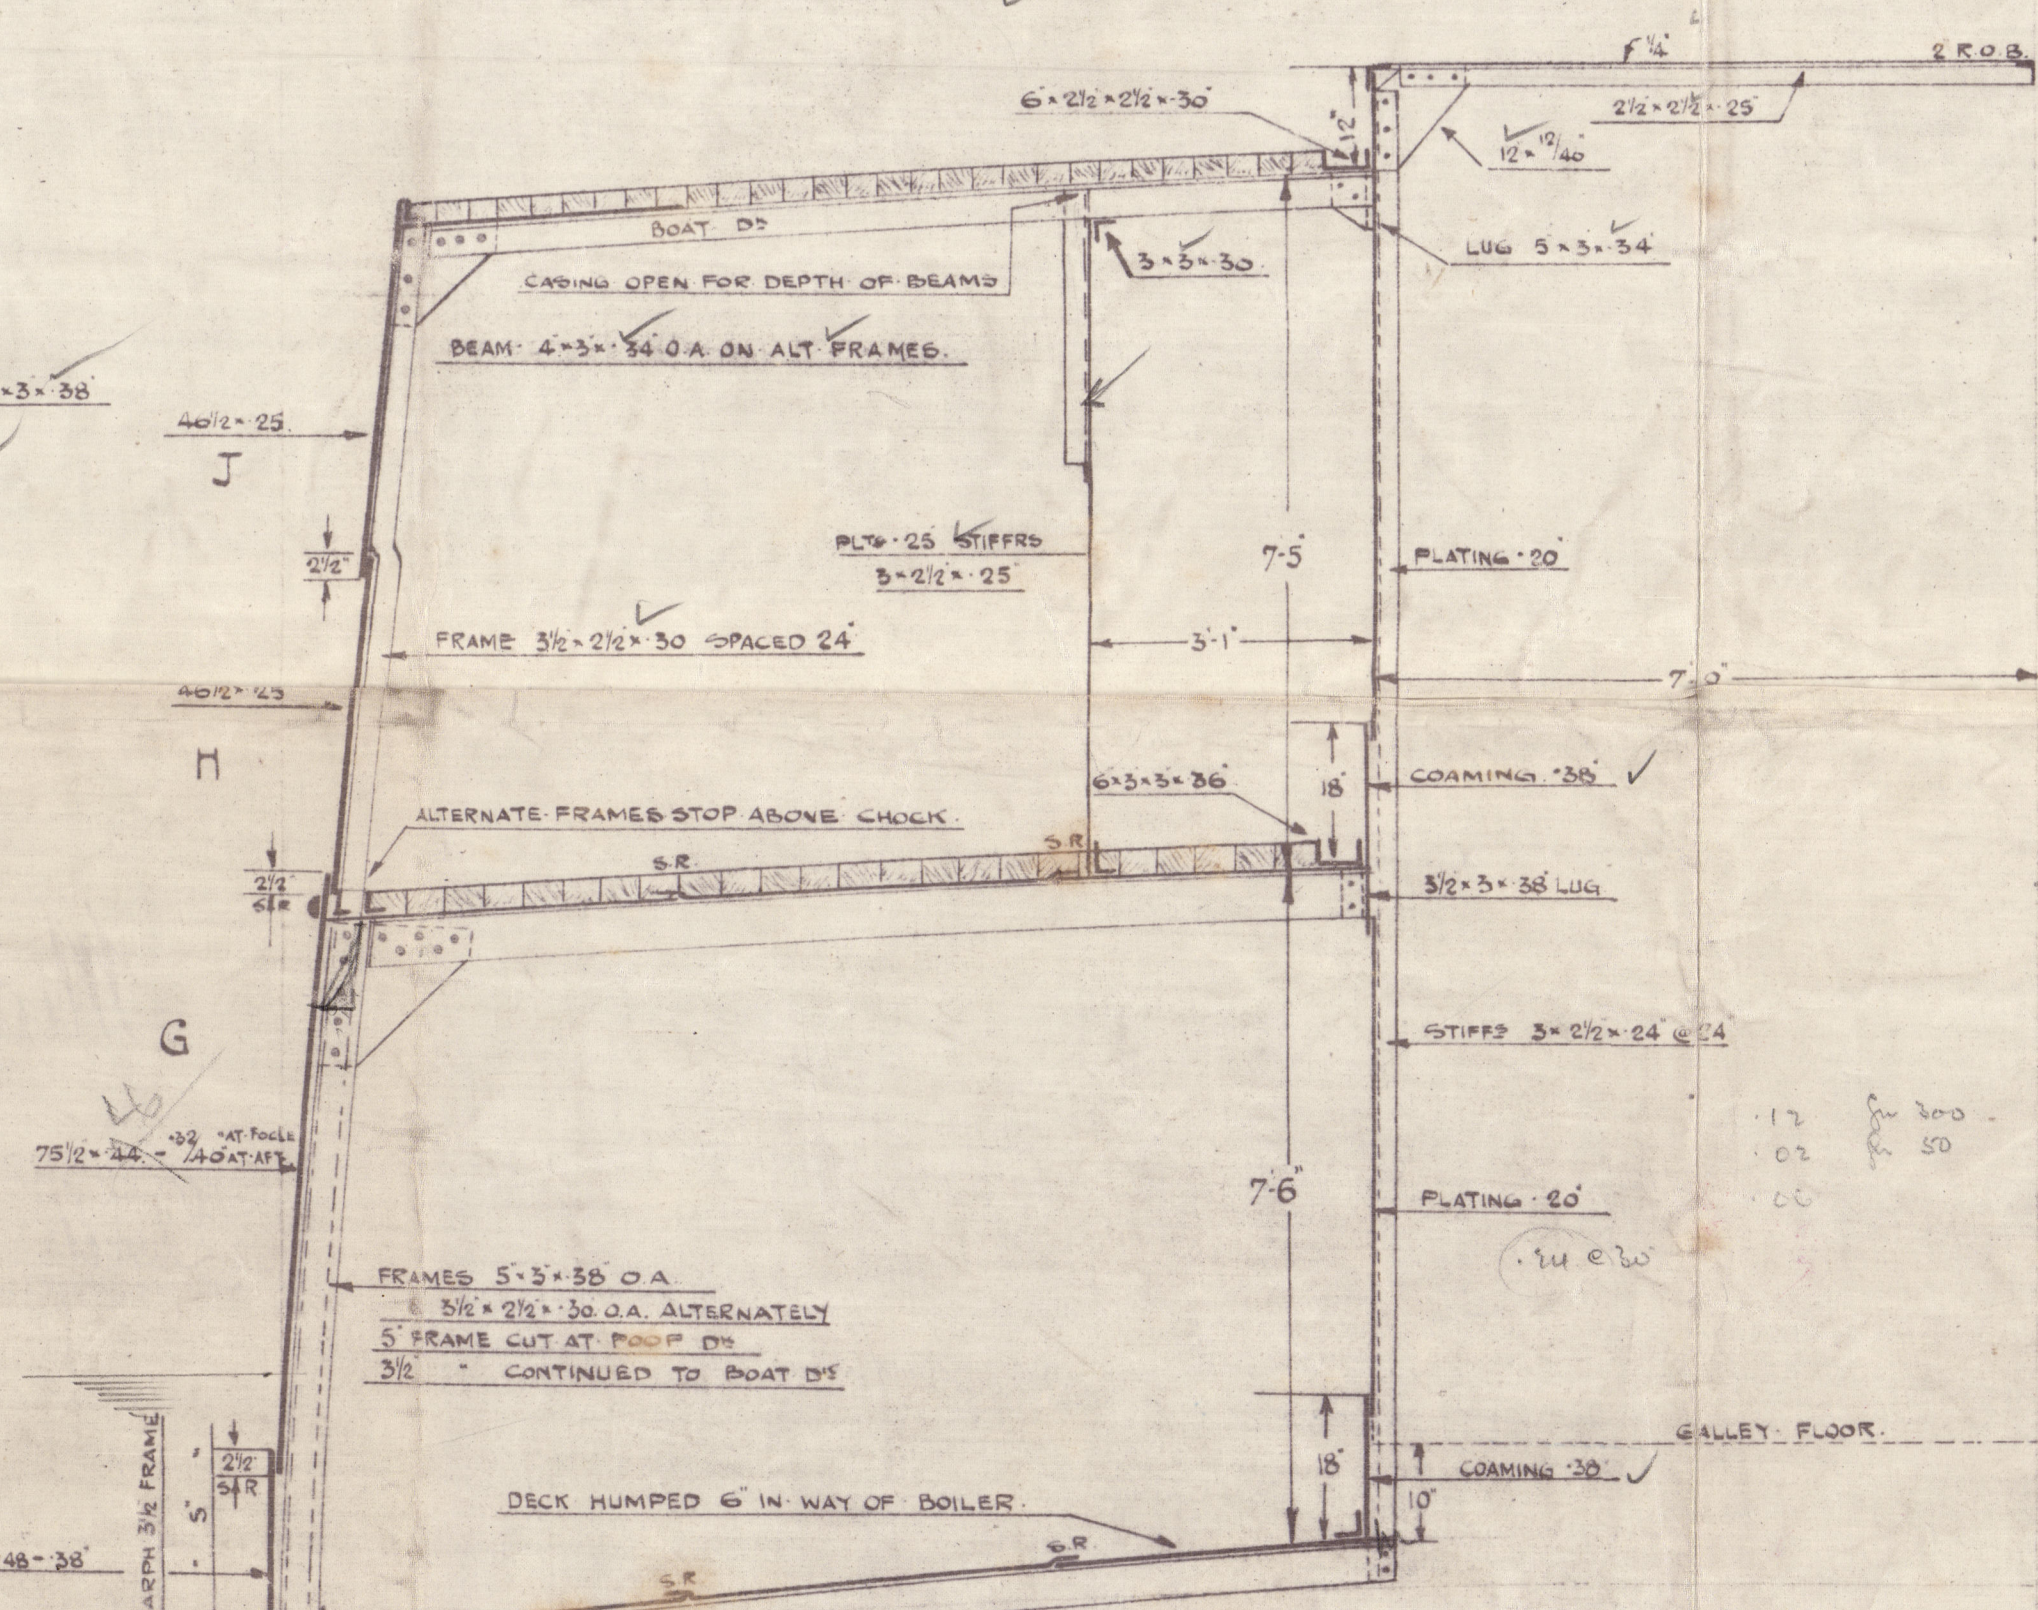

DOUBLE BOTTOM  




1  
Midship Section.

D & W. Henderson & Co.


484<sup>m</sup>

Brookman 1 - 10 - 26.

<sup>EX</sup>  
2/5 Pelebrooke

3/5. <sup>EX</sup> "Eddystone"

RECORDS DEPT.  
LONDON.

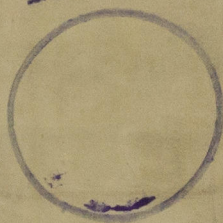

© 2020

Lloyd's Register  
Foundation

002471-002476-0057