


170 787M PROFILE & DE PLAN.

DIMENSIONS 270'0" x 37'0" x 18'6" MTD TO M.D.


SCALE 1/8" = 1 FT

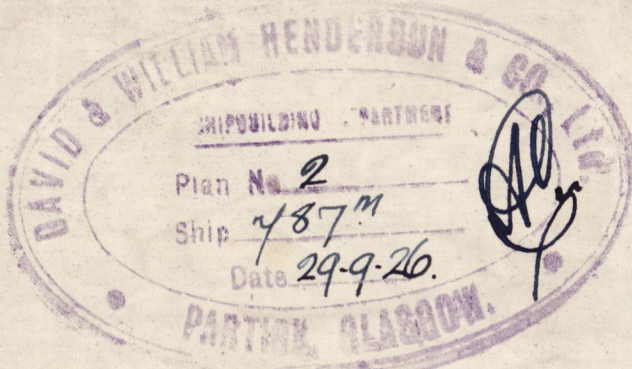

185
43
748
770
47

30 SEP 1940

C. J. P. 110.216

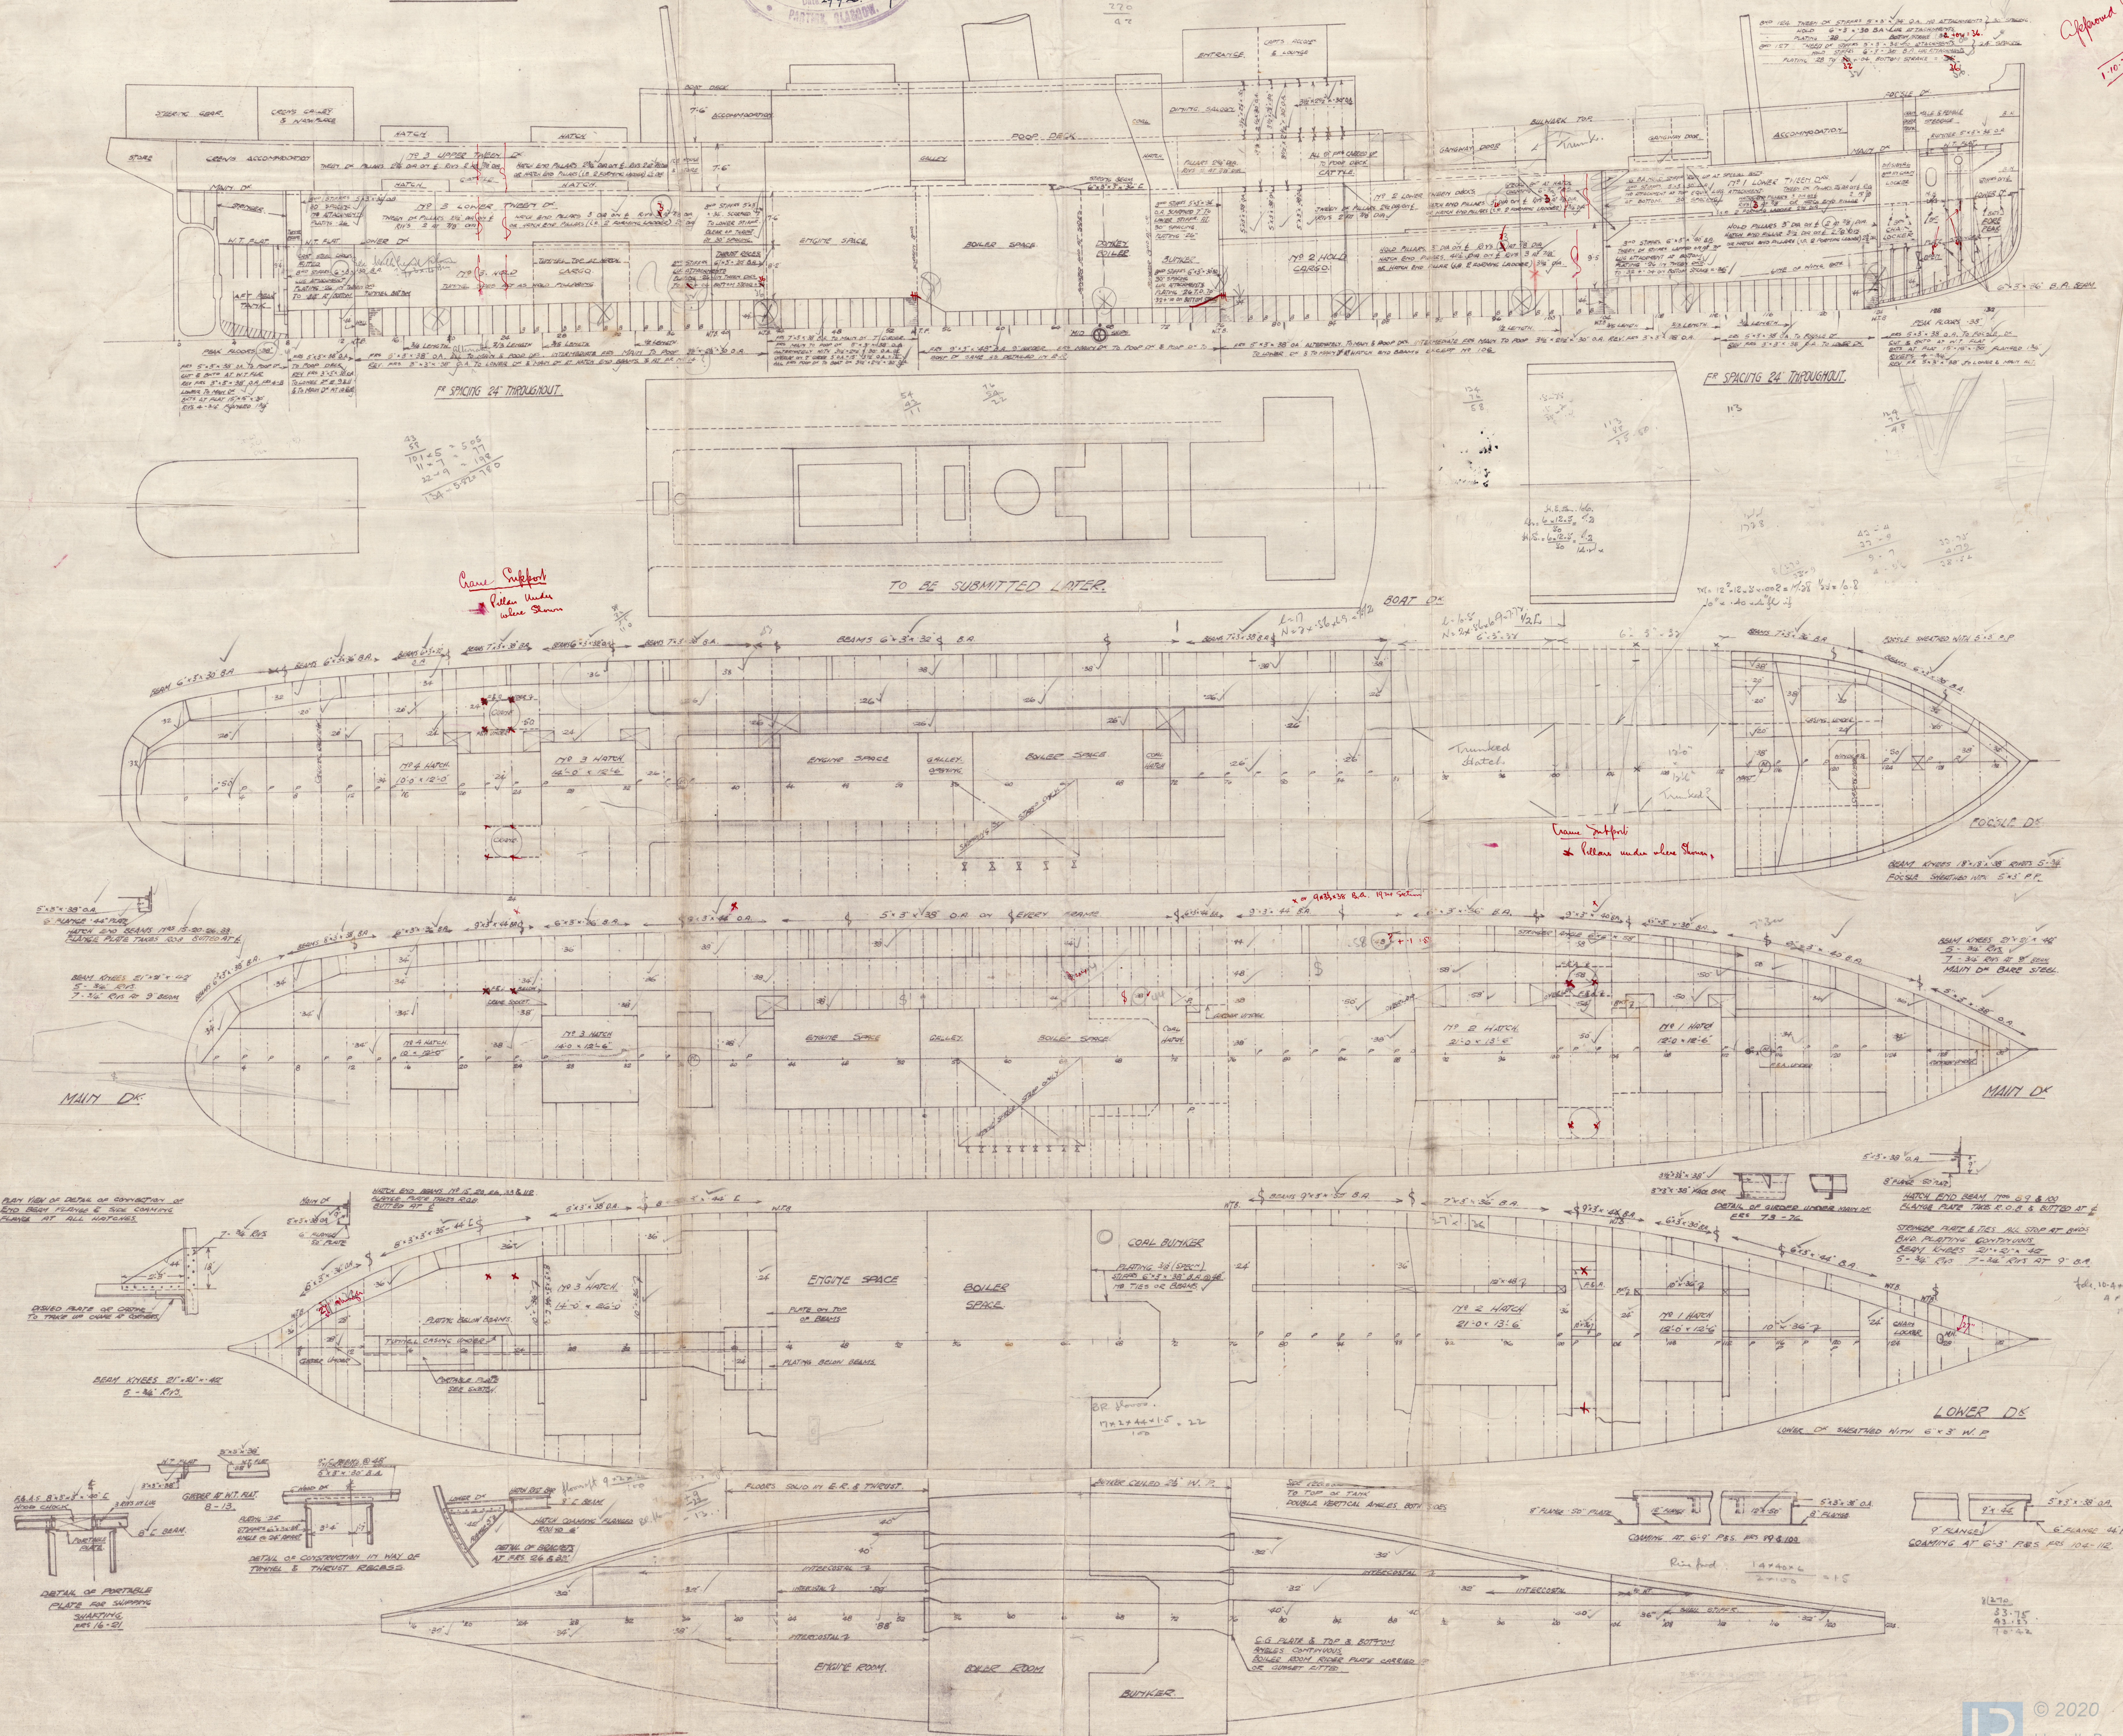

L.

Profile & Decks.

D. W. Henderson & Co.

484^m.

1 " 10 " 26.

5/8 Holbrooke

5/8 " Eddystone "

Brookmount

RECORDS DEPT.
LONDON.



© 2020

Lloyd's Register
Foundation

002471-002476-0058