
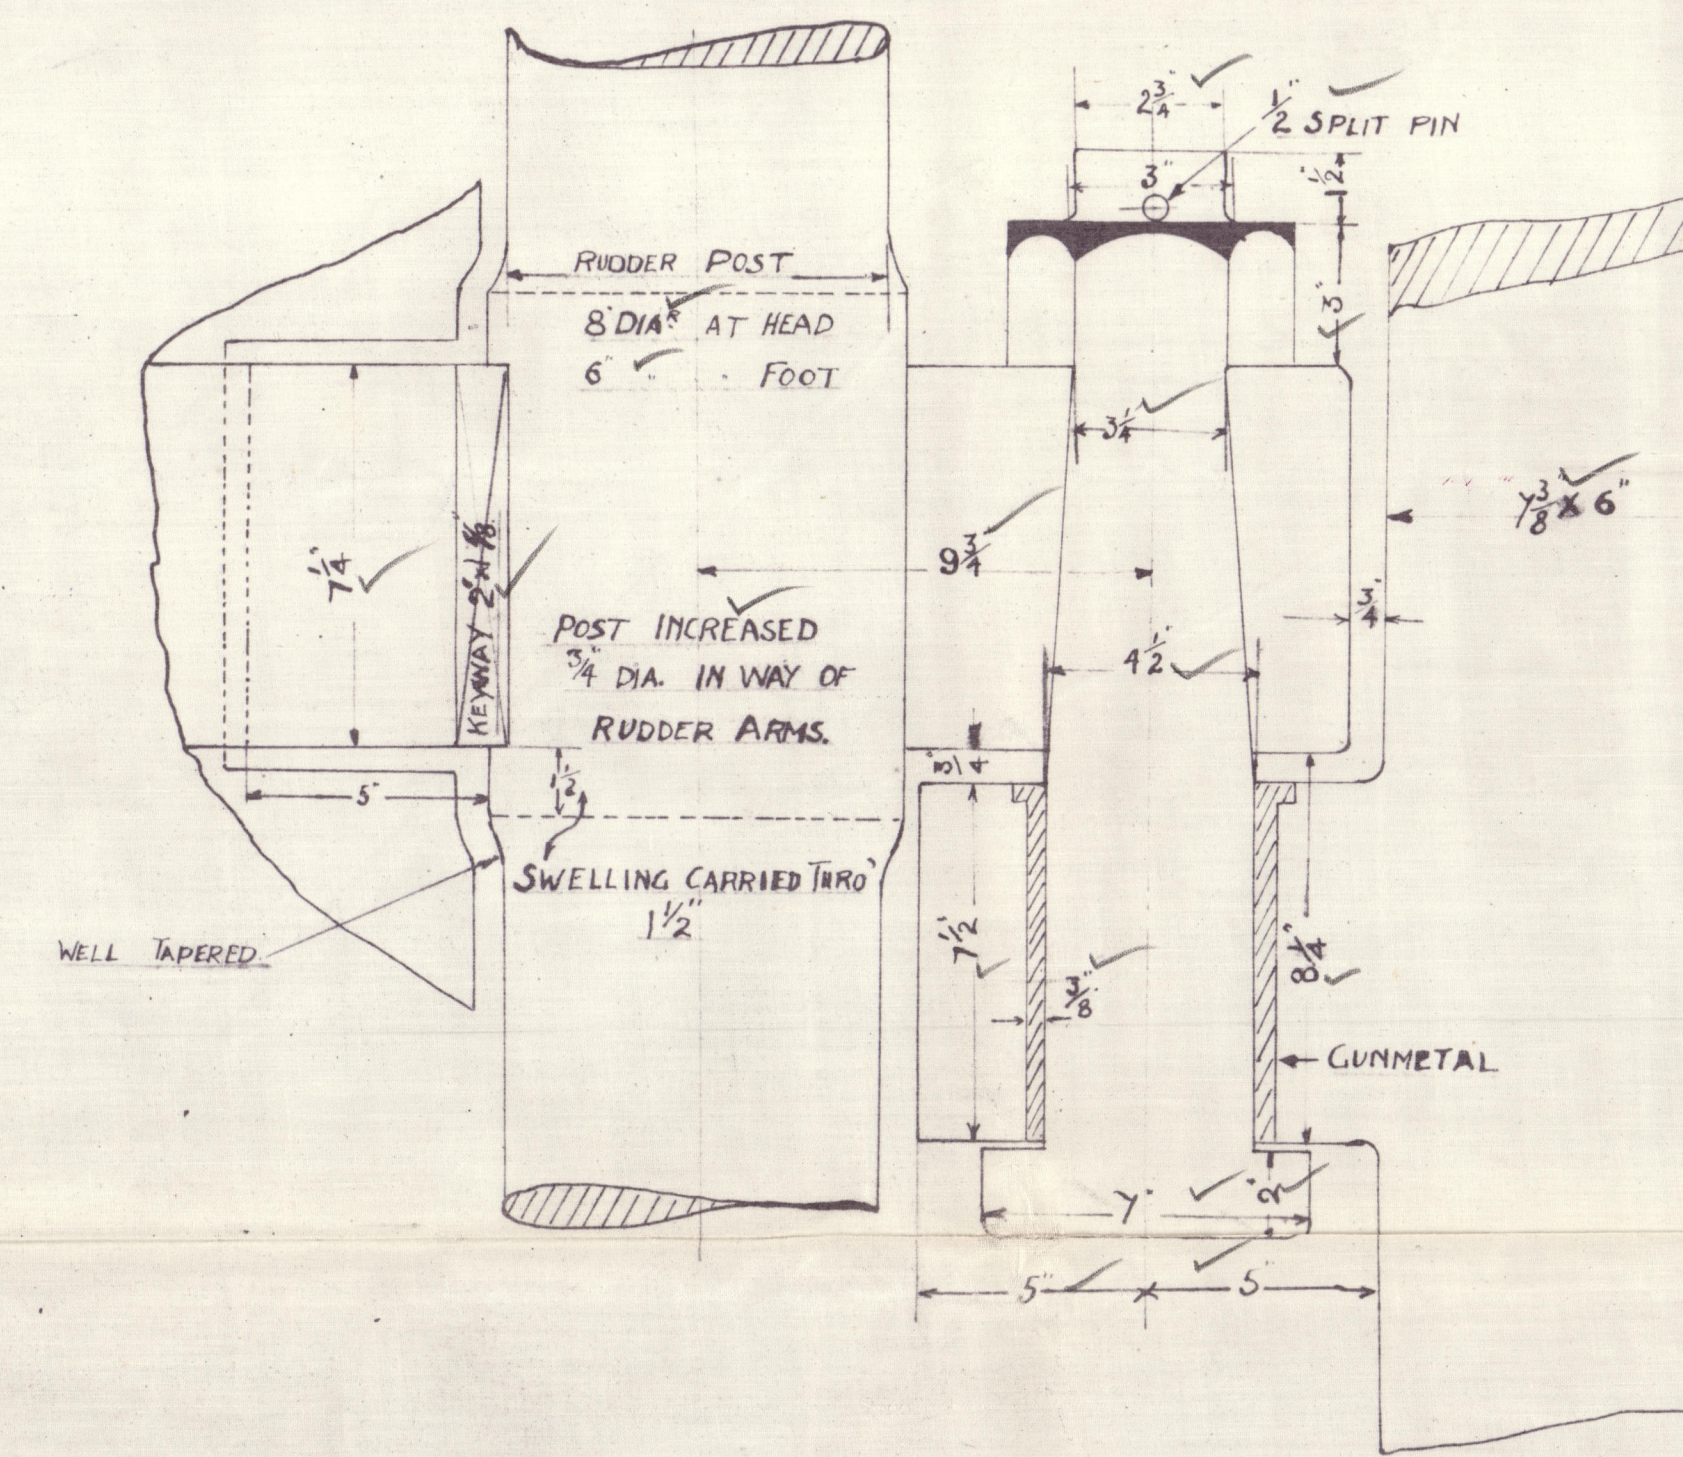


787^M



STERNPOST & RUDDER.

SCALE 1 INCH = 1 FOOT.


RUDDER STOCK & STERNPOST FORGED IRON.

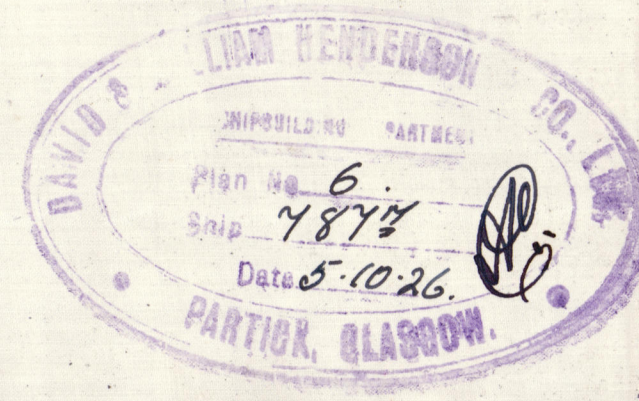

DETAIL OF TOPMOST PINTLE & GUDGEON.
SCALE: 3" = 1 FOOT.

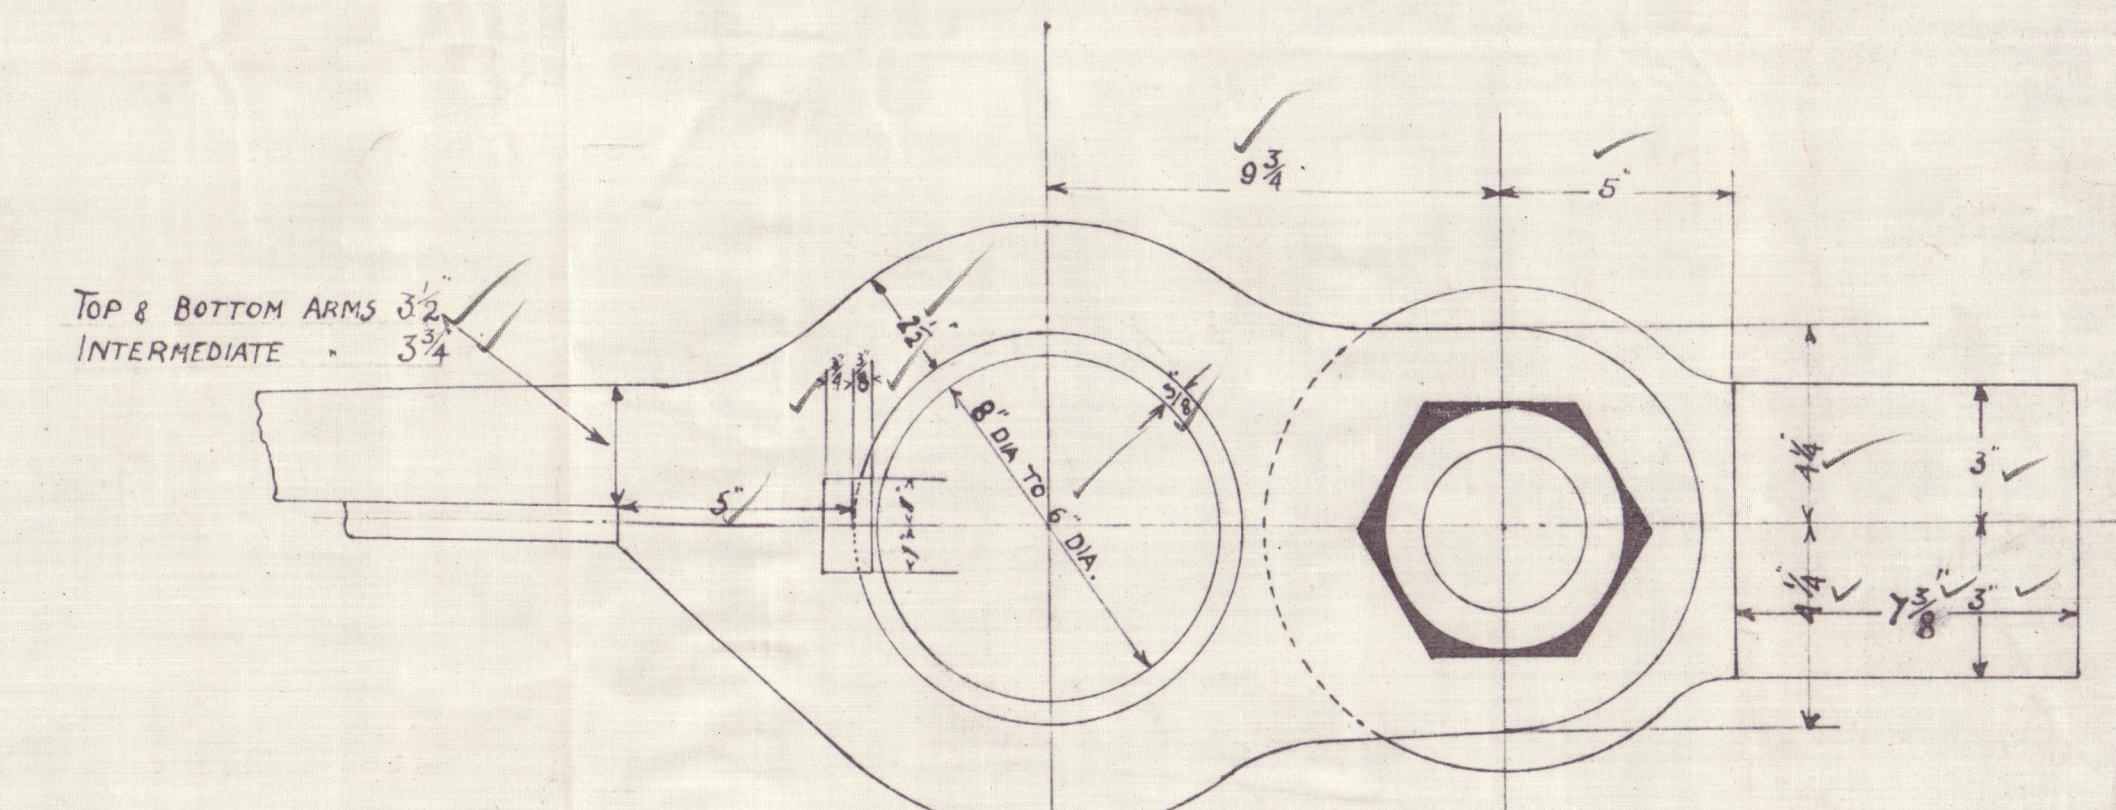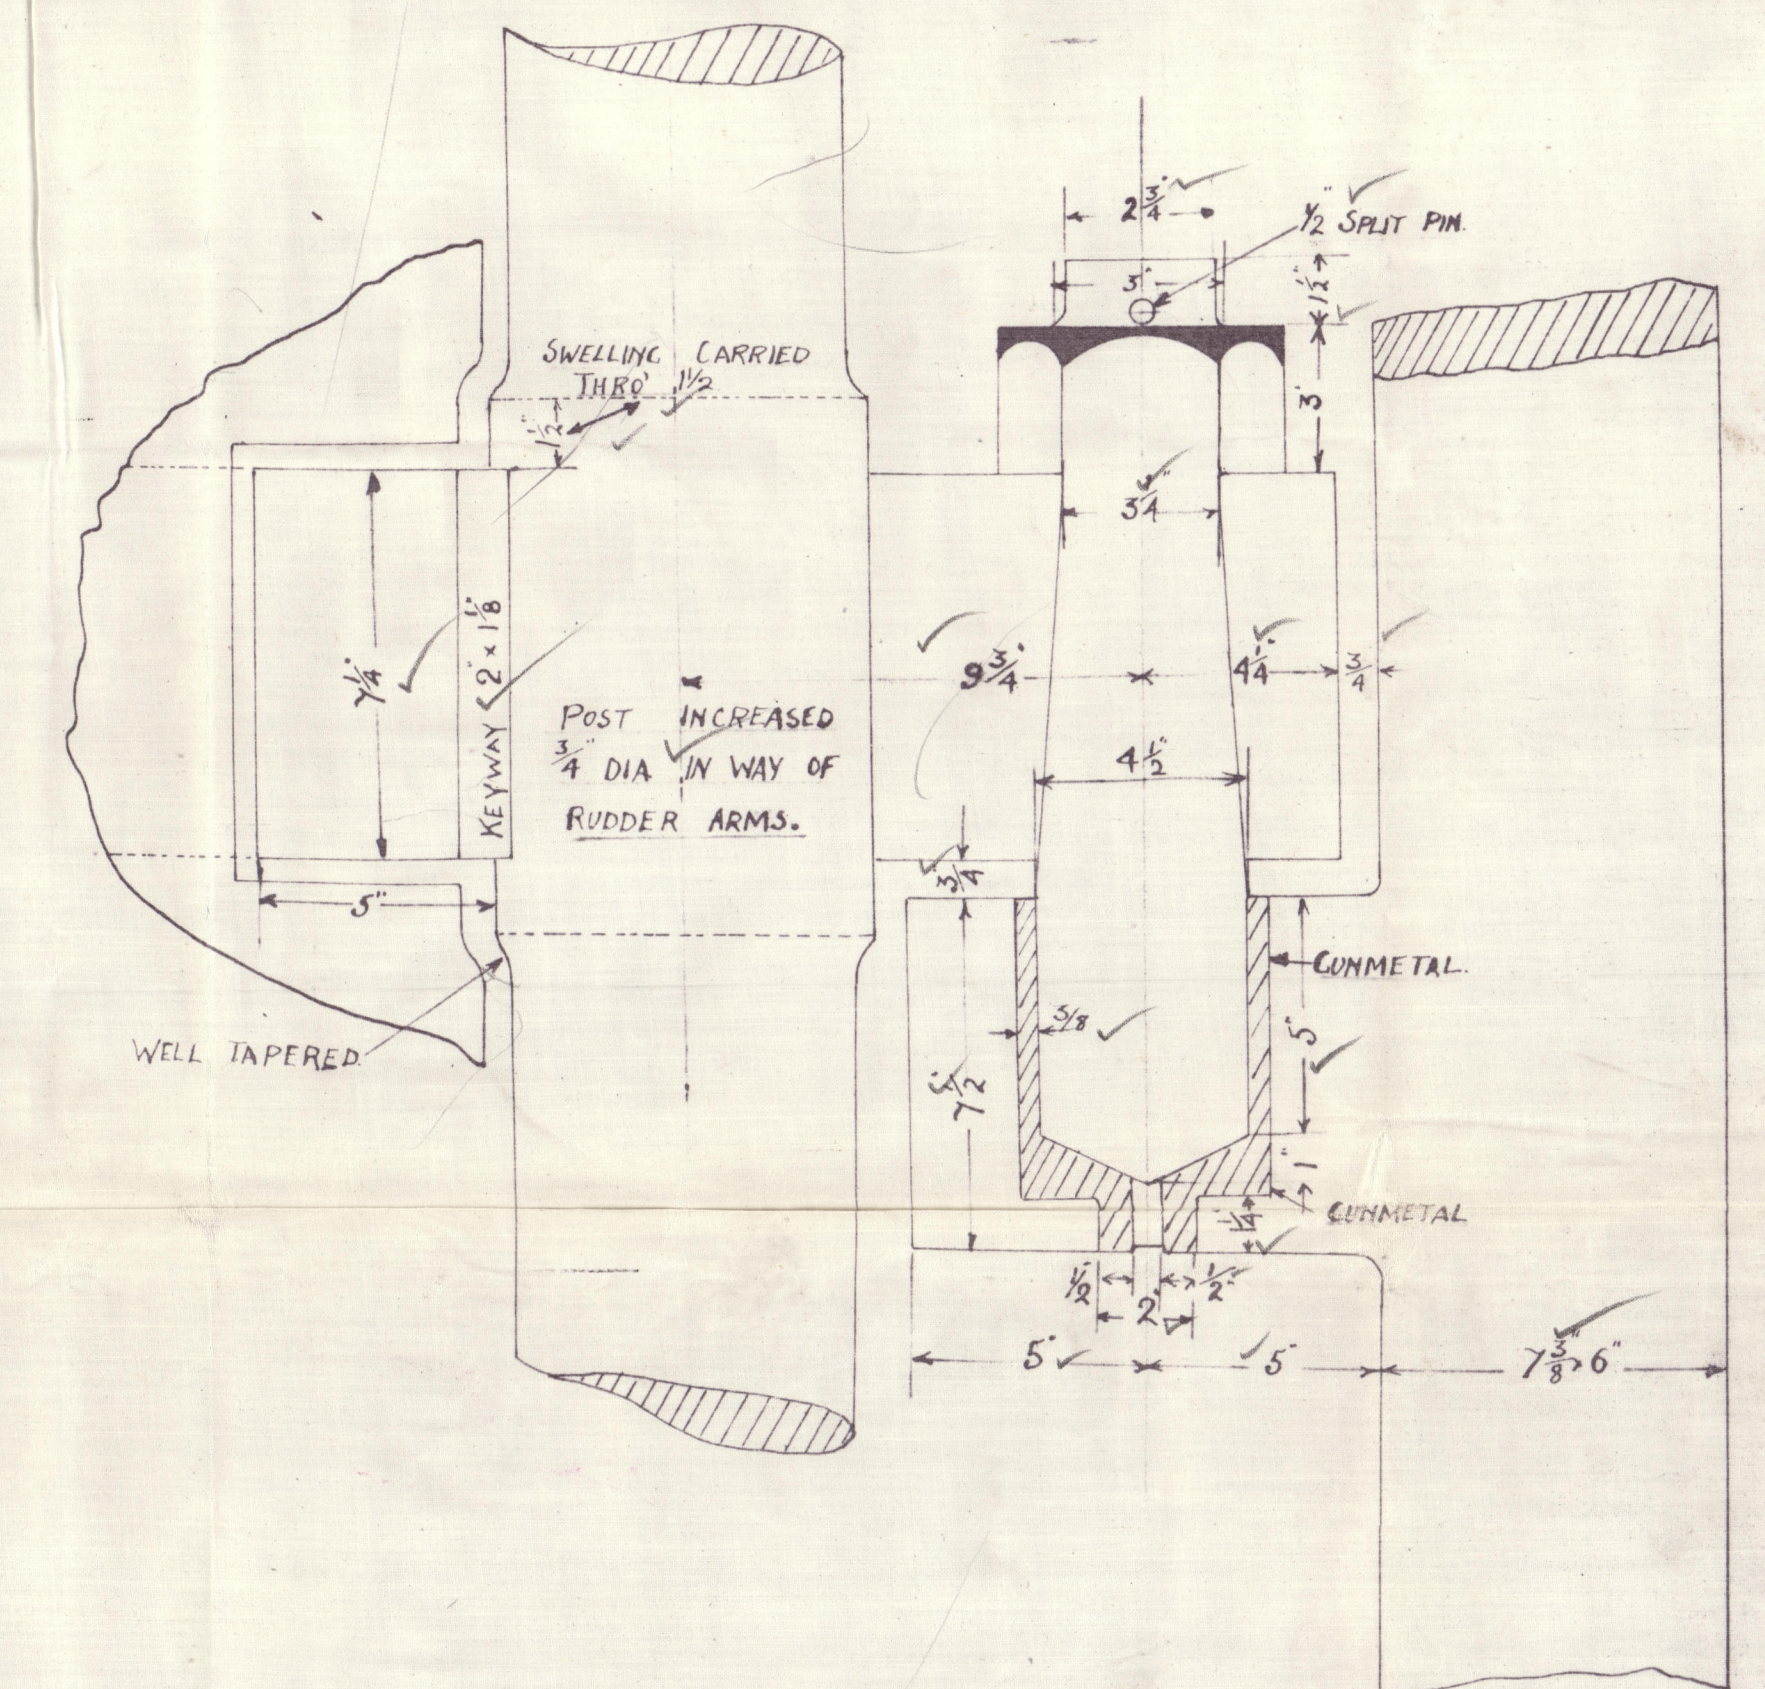

DETAIL SKETCHES OF PINTLES & GUDGEONS.
SCALE 3" = 1 FOOT.

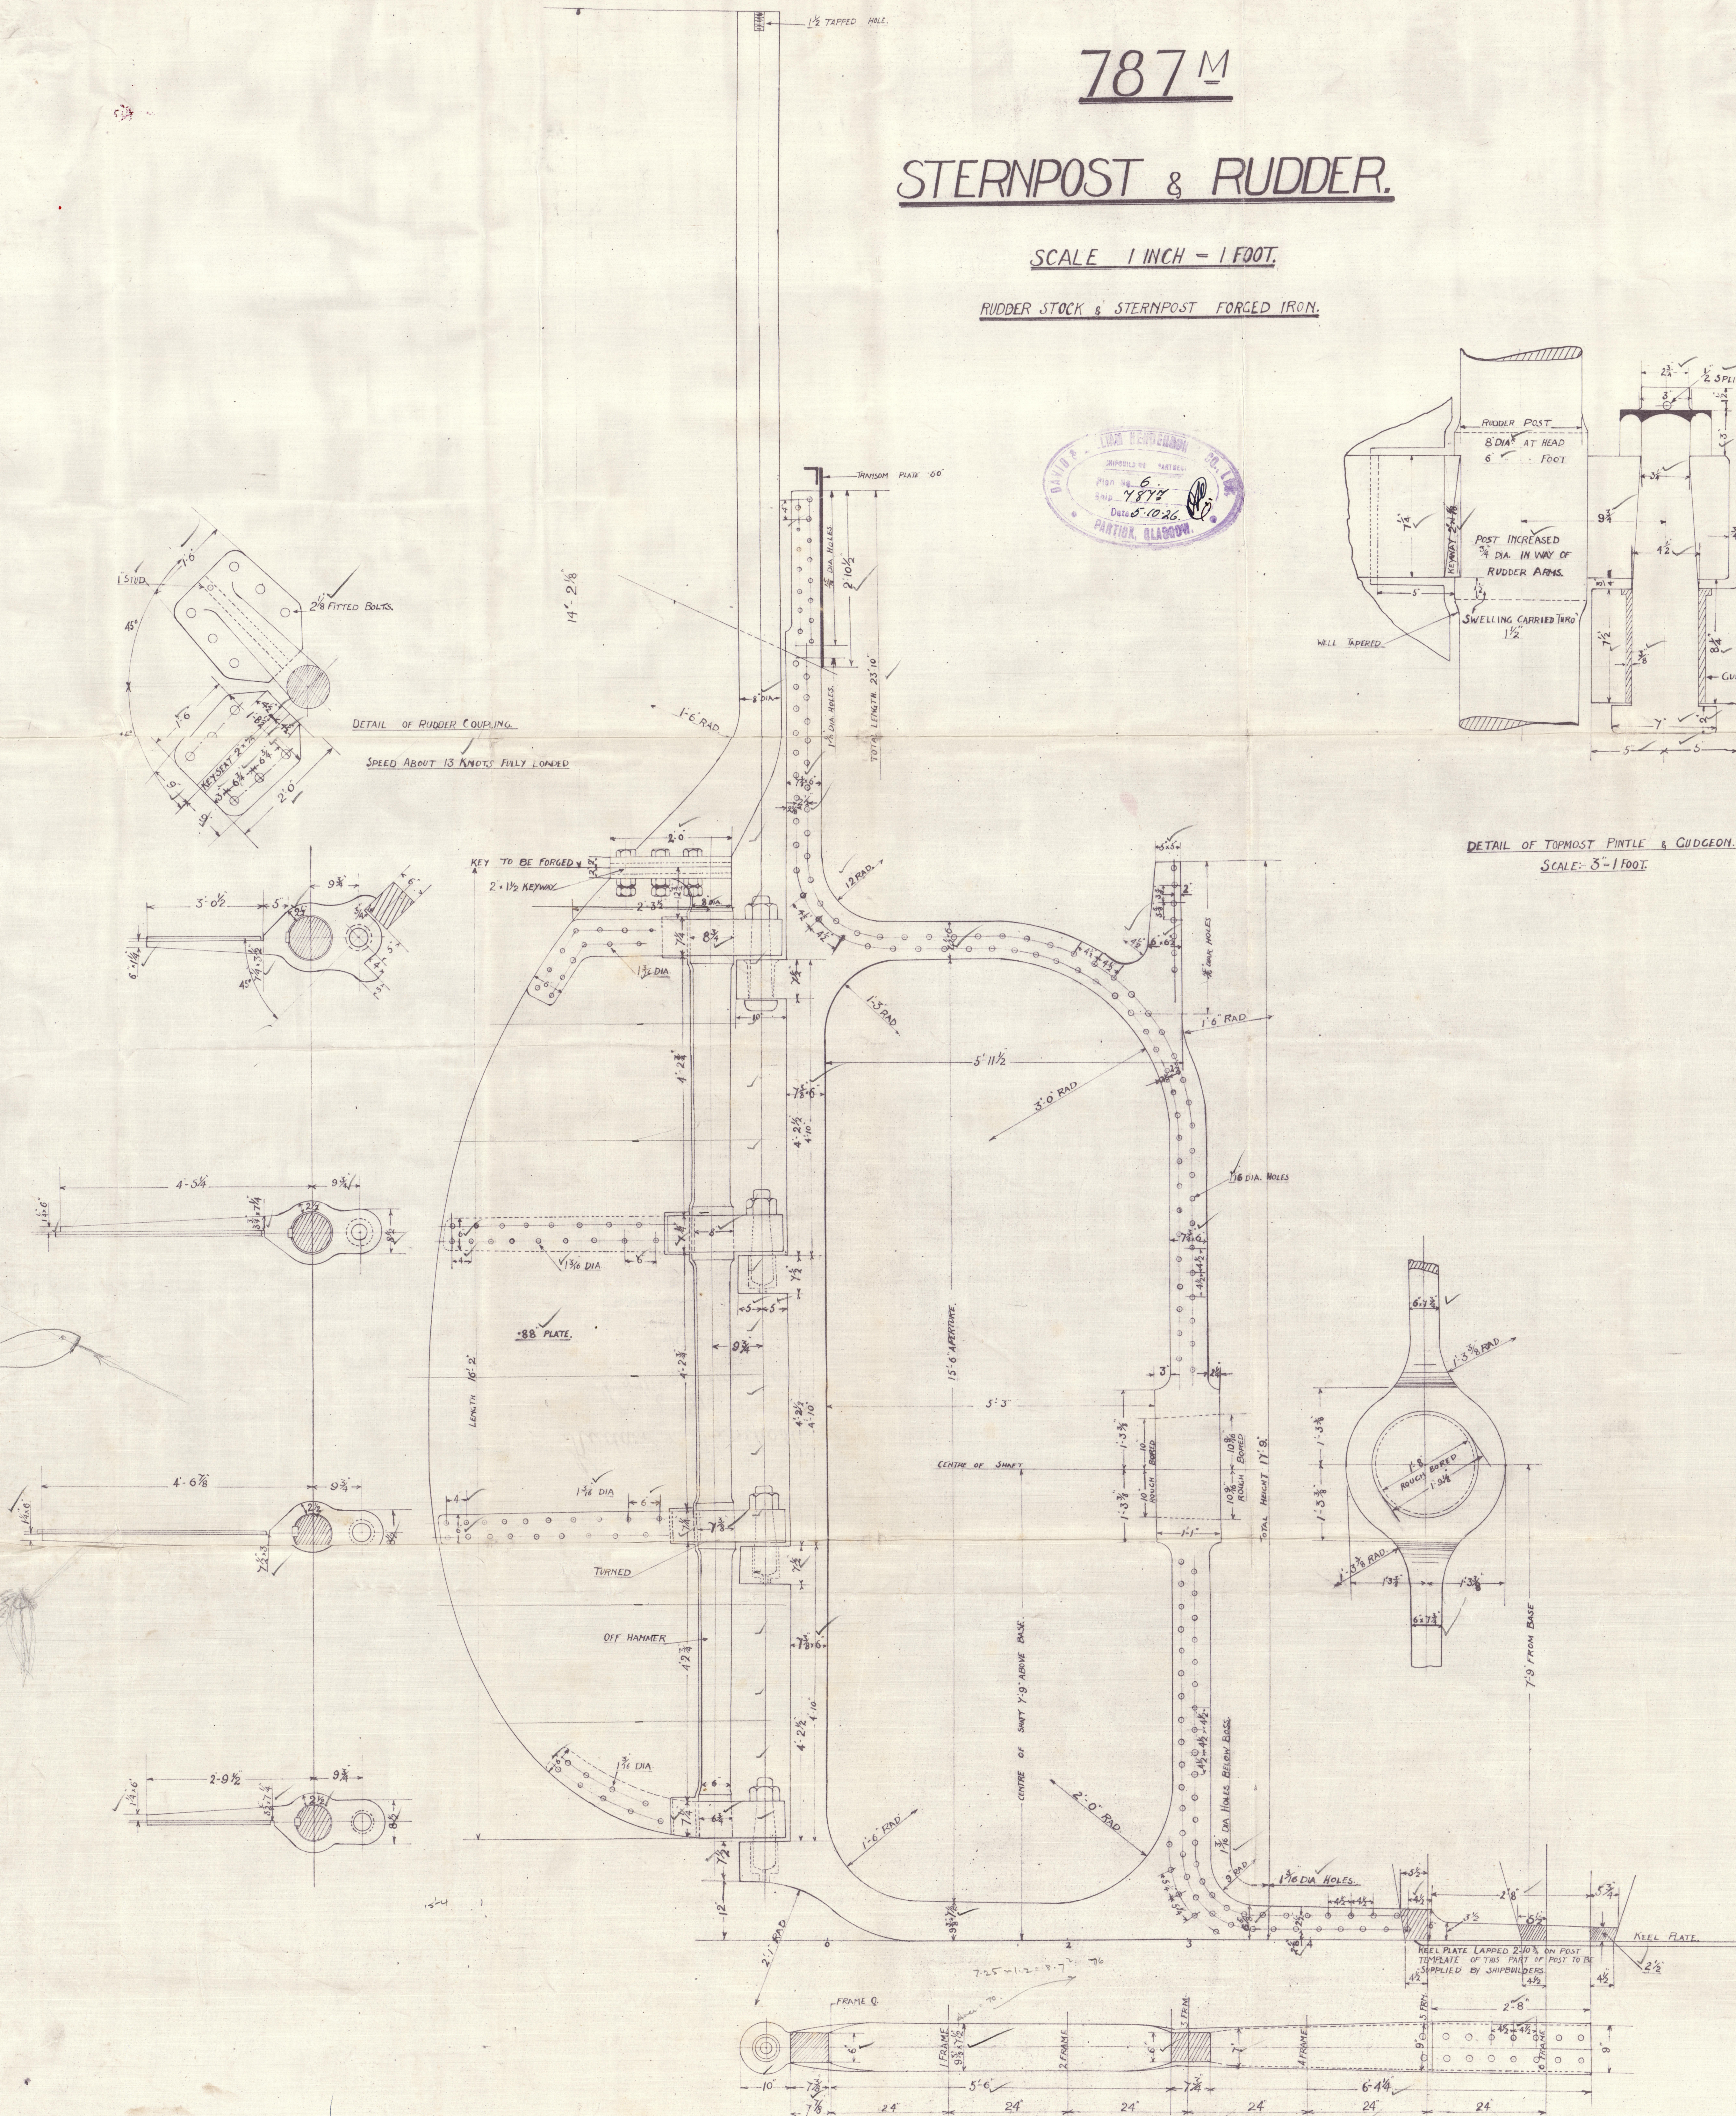

9 OCT 1926

Approved
6/10/26

3

Rudder & Sternpost.

D & W Henderson.

484^m

Breakmont

6 .. 10 .. 26.

^{2x}
^{ss} Colebrooke

^{ss}
"Eddystone"

270'



© 2020

Lloyd's Register
Foundation

002471-002476-0059