


SHIPS 390 PROFILE & DECKS.


DIMENSIONS :- LENGTH B.P. 466'-0", BREADTH MLD., 61'-9", DEPTH MLD. 33'-11".
TO CLASS LLOYDS 100 A1. "CARRYING PETROLEUM IN BULK."
LONGITUDINAL FRAMING AT BOTTOM AND AT DECK.
SCALE 1/8" = 1 foot.

 

Furness S. B. Ltd. Ltd.


Yard No 390.

Profile + Decks (as fitted).

S.S. "British Admiral" 
MDB, RPT. No. 18205

4

002471-002476-0089

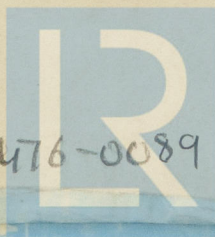

© 2020

Lloyd's Register
Foundation