


N^{os} ~~827~~ - 828.


SCALE ONE INCH = ONE FOOT.

TO LLOYDS REQUIREMENTS.

CASTINGS MACHINED WHERE MARKED THUS |||||
 CASTINGS ROUGH MACHINED WHERE MARKED THUS ~~~~~
 FLANGES ON CASTINGS TO BE DRESSED FOR RIVETING AND WELDING

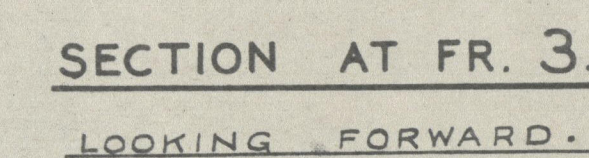

SECTION AT FR. 3.
LOOKING FORWARD.

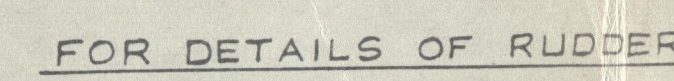

A. OF BOSS PARALLEL

RE OF BOSS- CENTRE
TO RAKE OF
ER SHAFT.

NOT LESS THAN 4-16 F


_____ 4-1

MATHEMATICAL ORDER BOOK 1				PAGE 89	
				REMARKS:	
MARKS	IN	LENGTH	BREADTH	TEN'S	
5.7	1	2	8.7	37.22	100
87%	2	2	4-8	20	150
	3	2	6-11	18	125
	4	2	6-11	24.6	125
	5	2	7-9	79	6
	6	2	5-6	36-23	100
	7	2	1-8	8	100
	8	2	1-11-5	20	36
	9	2	5-11	56-18	42
	10	2	4-7	468	50
	11	2	4-1	30	50
	12	2	4-1	36-18	42
	13	2	4-7	335-18	42
	14	2	1-1	30	100
	15	2	5-7	27-18	42
	16	2	4-1	20	36
	17	2	4-1	20	42
	18	2	6-1	26	38
	19	2	5-3	46	50
	20	2	4-1	50	42
	21	2	6-3	21	40
	22	2	5-7	5	50
	23	2	5-7	5	50
	24	2	5-7	5	18
BAGS					
	1	2	5-0	4-4	50
	2	2	5-0	4-4	40
	3	2	6-9	3-3	30
	4	2	6-9	3-3	30
	5	2	3-1	5	40
					FLAT BAR
					" "

PLAN № 3.


SECTION AT FRAME 2.

LOOKING AF-T.

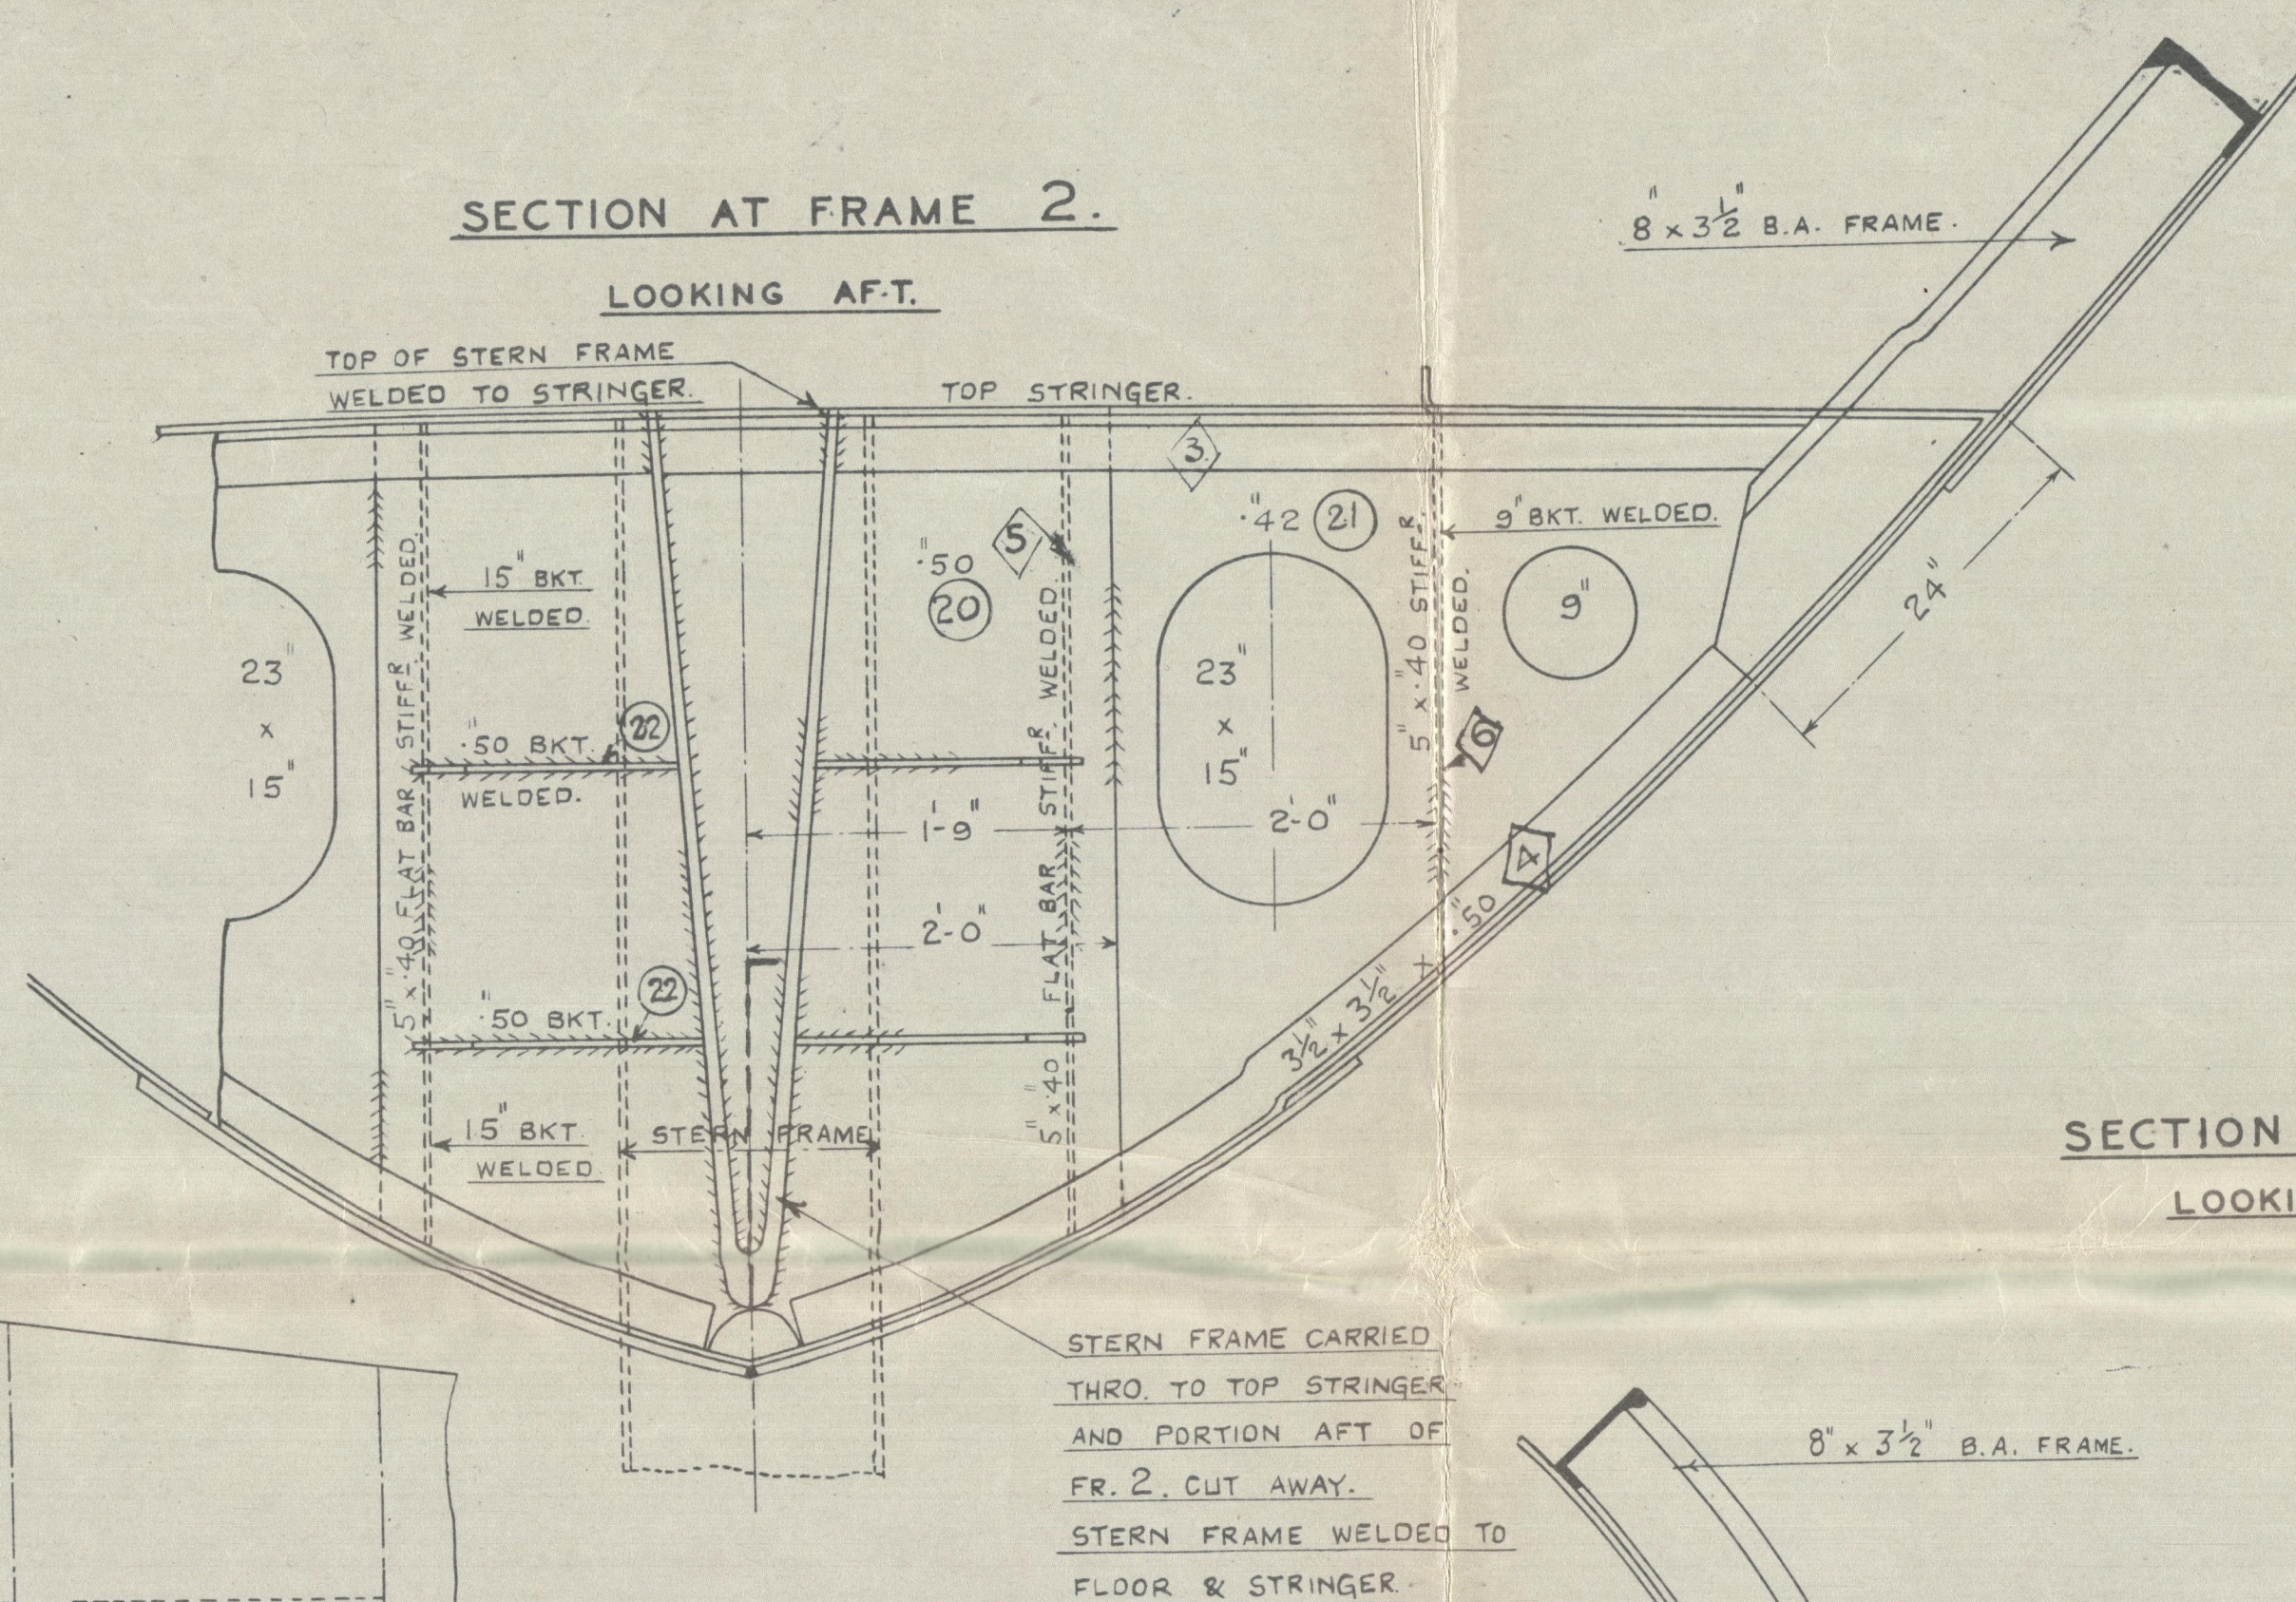


SECTION FRAME 6.


LOOKING AFT.

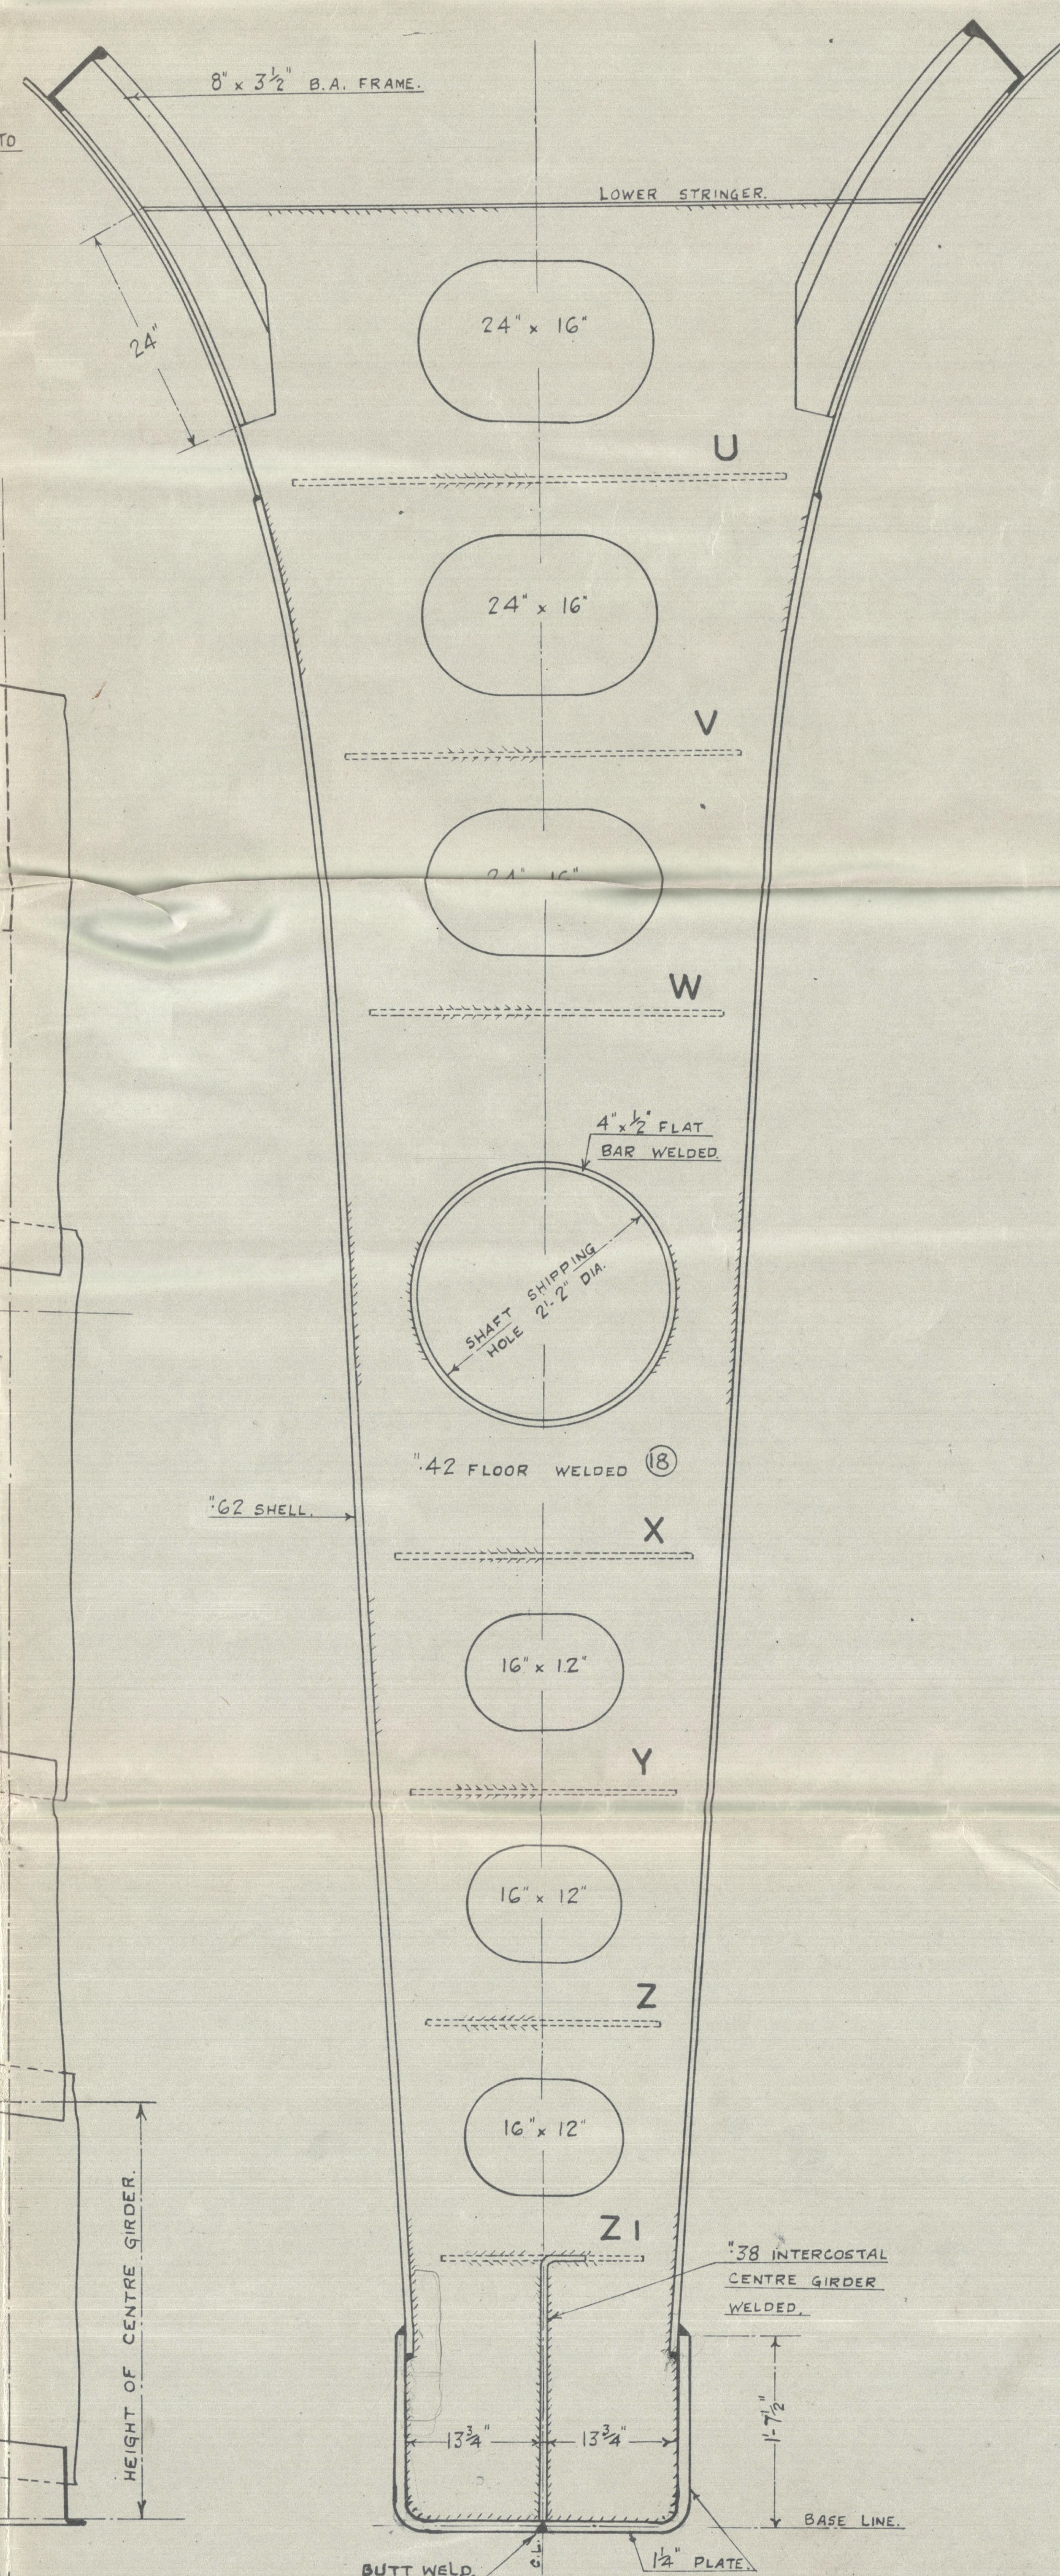


PLAN AT LOWER STRINGER.

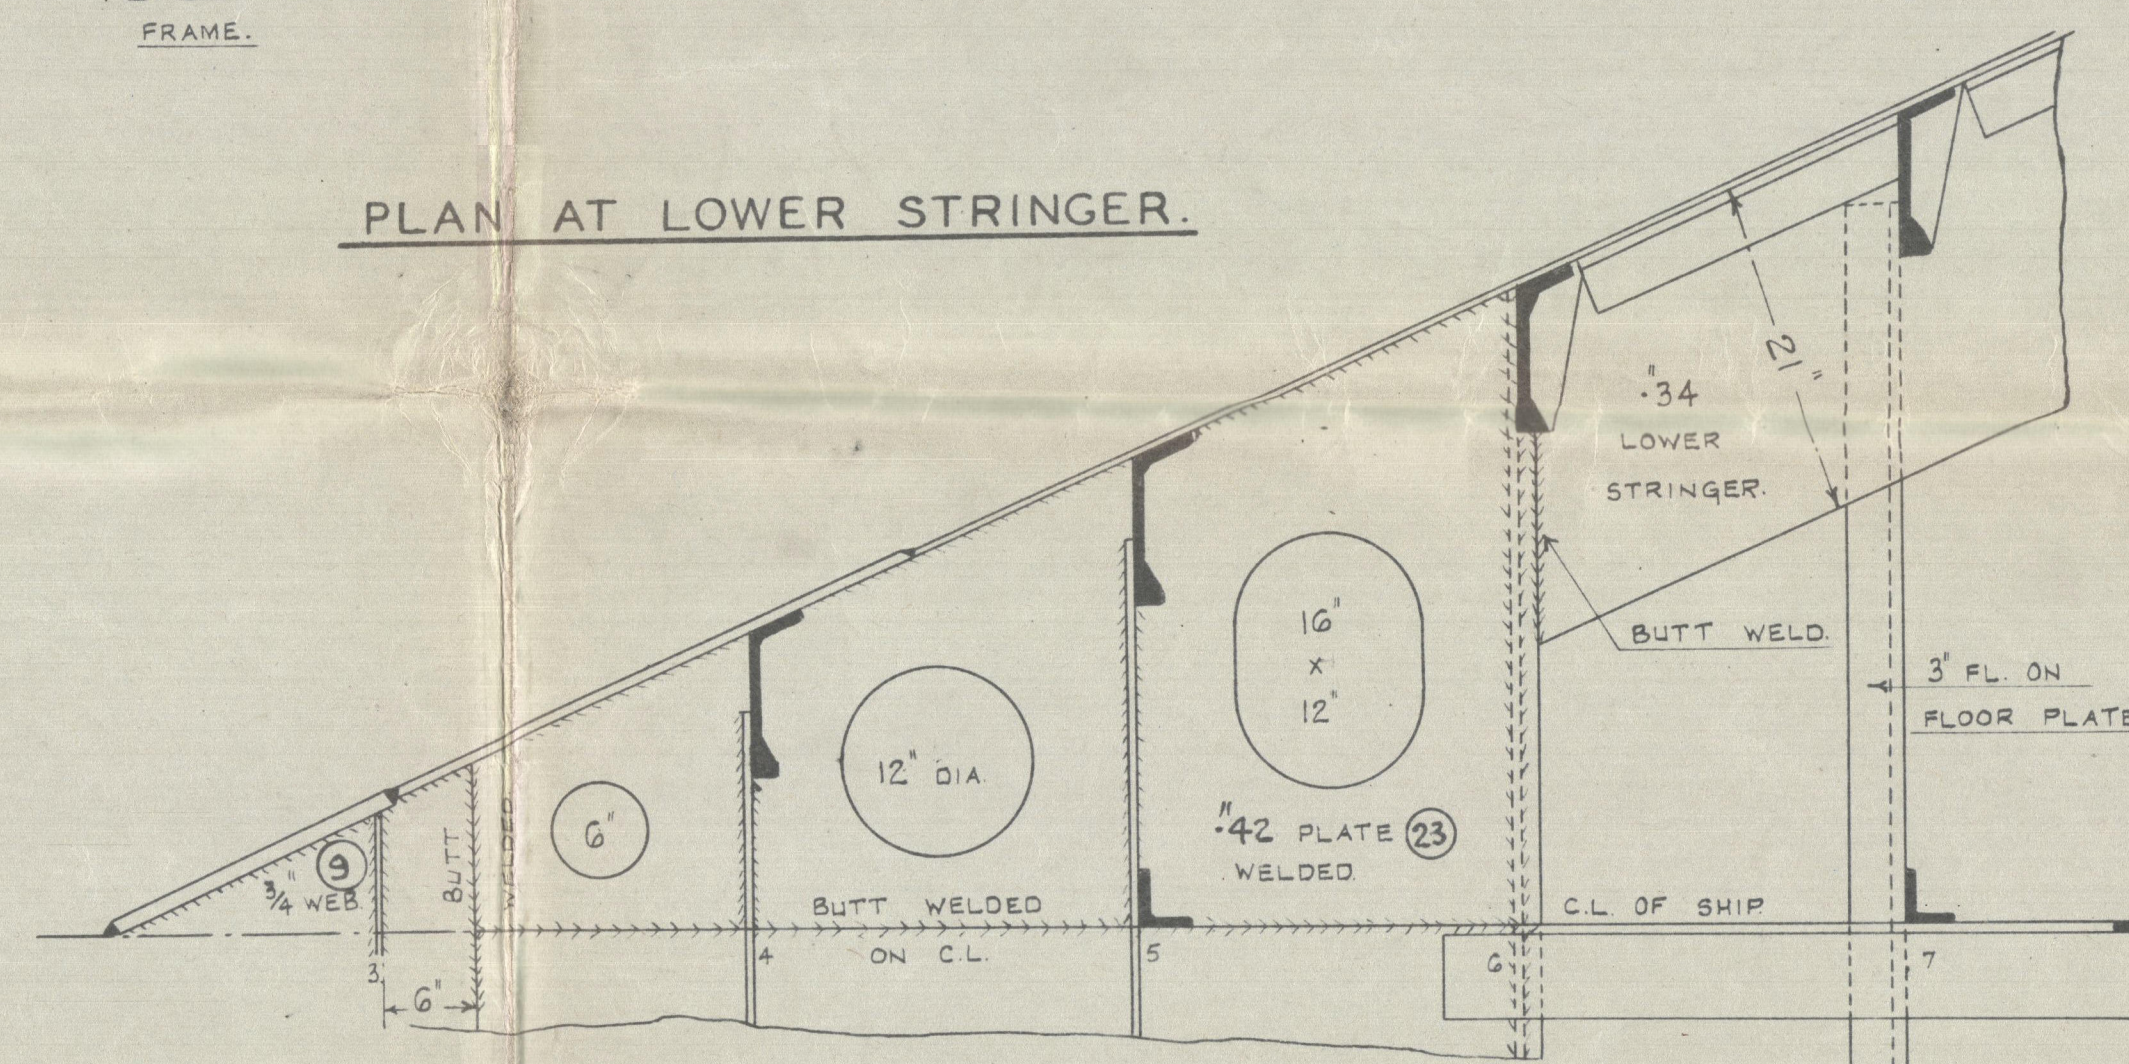


PLAN AT V.

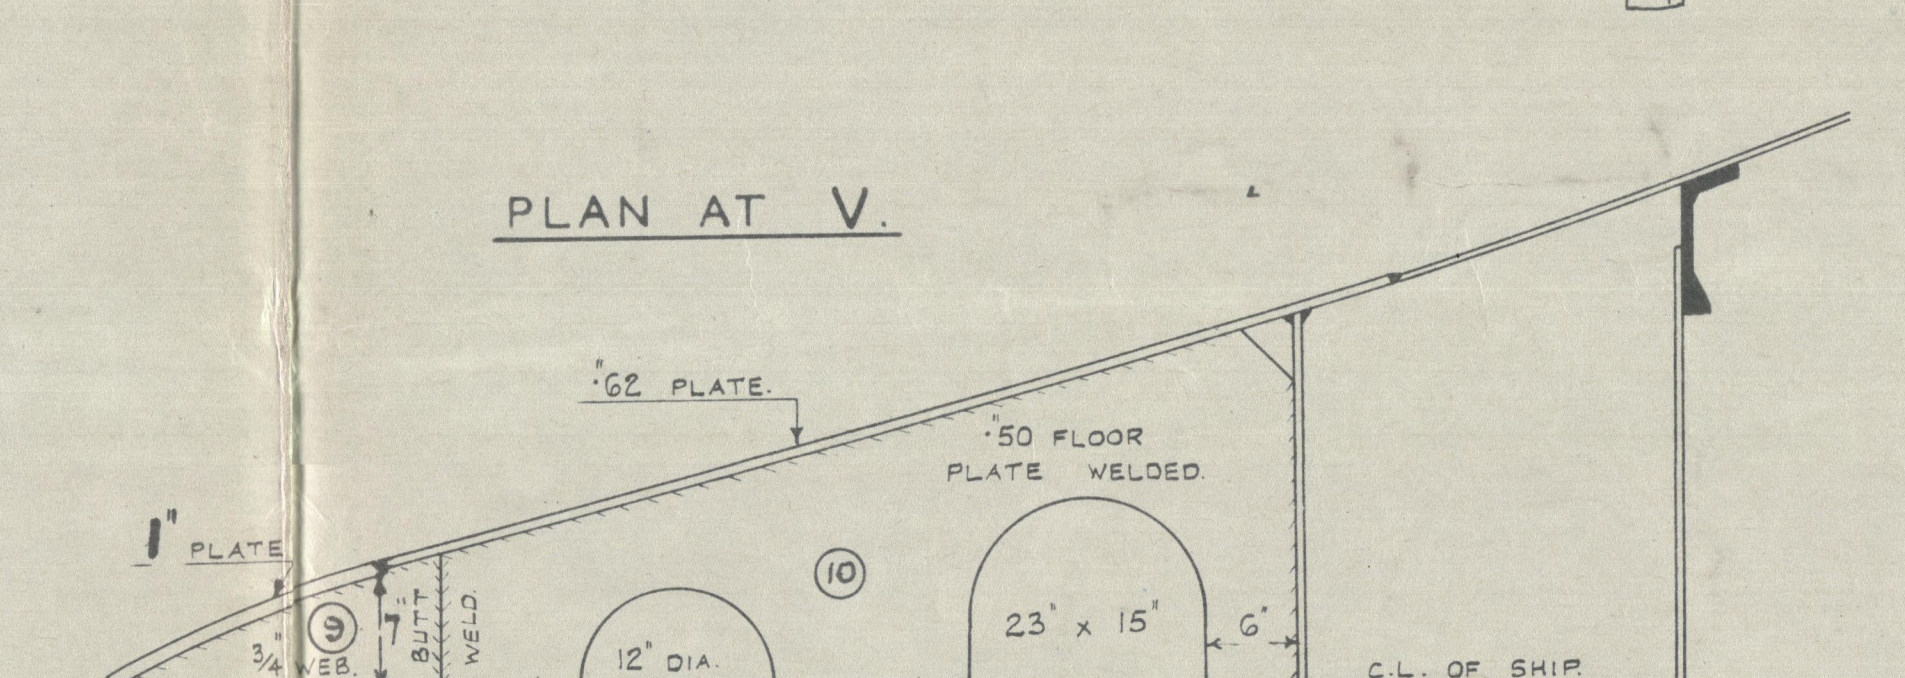


PLAN AT C.L. OF SHAFT.

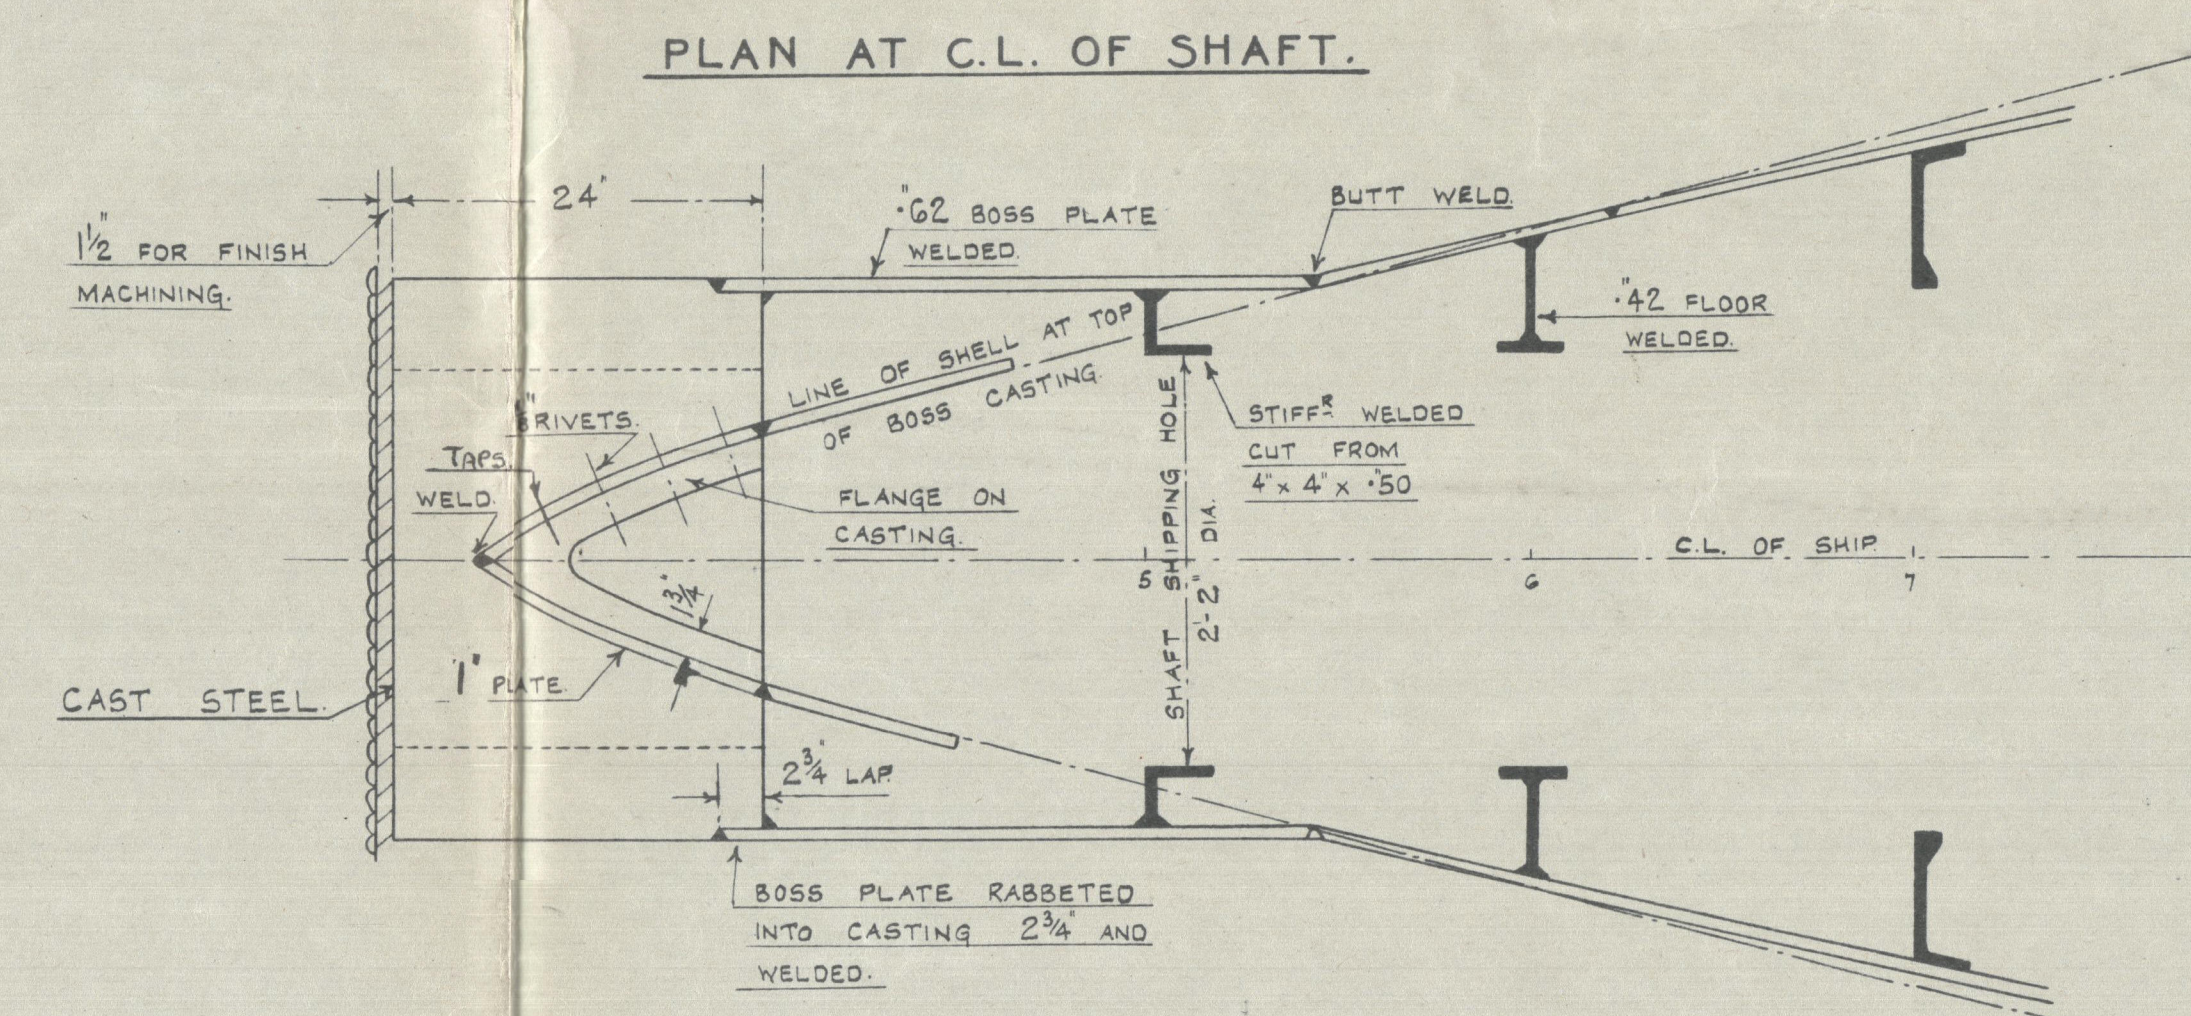

PLAN AT X.

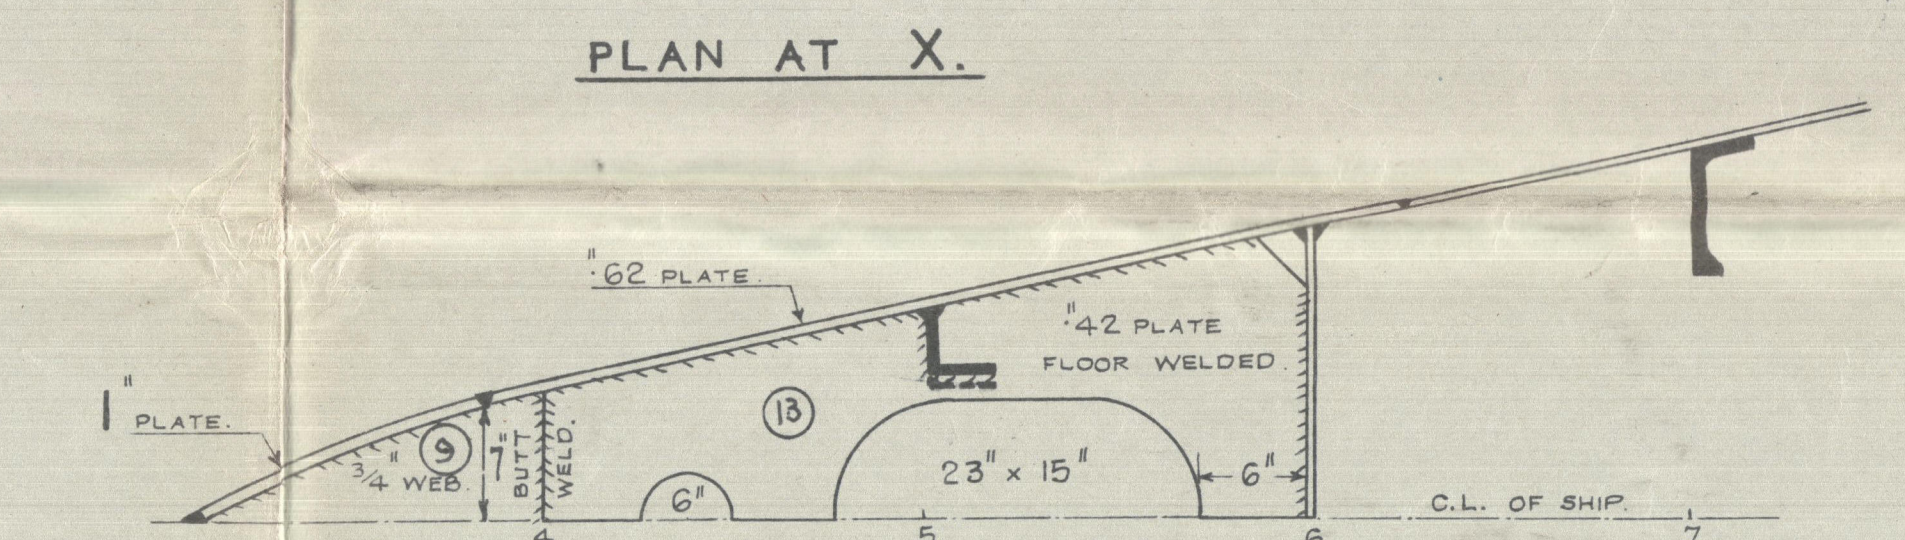


PLAN AT ZI.

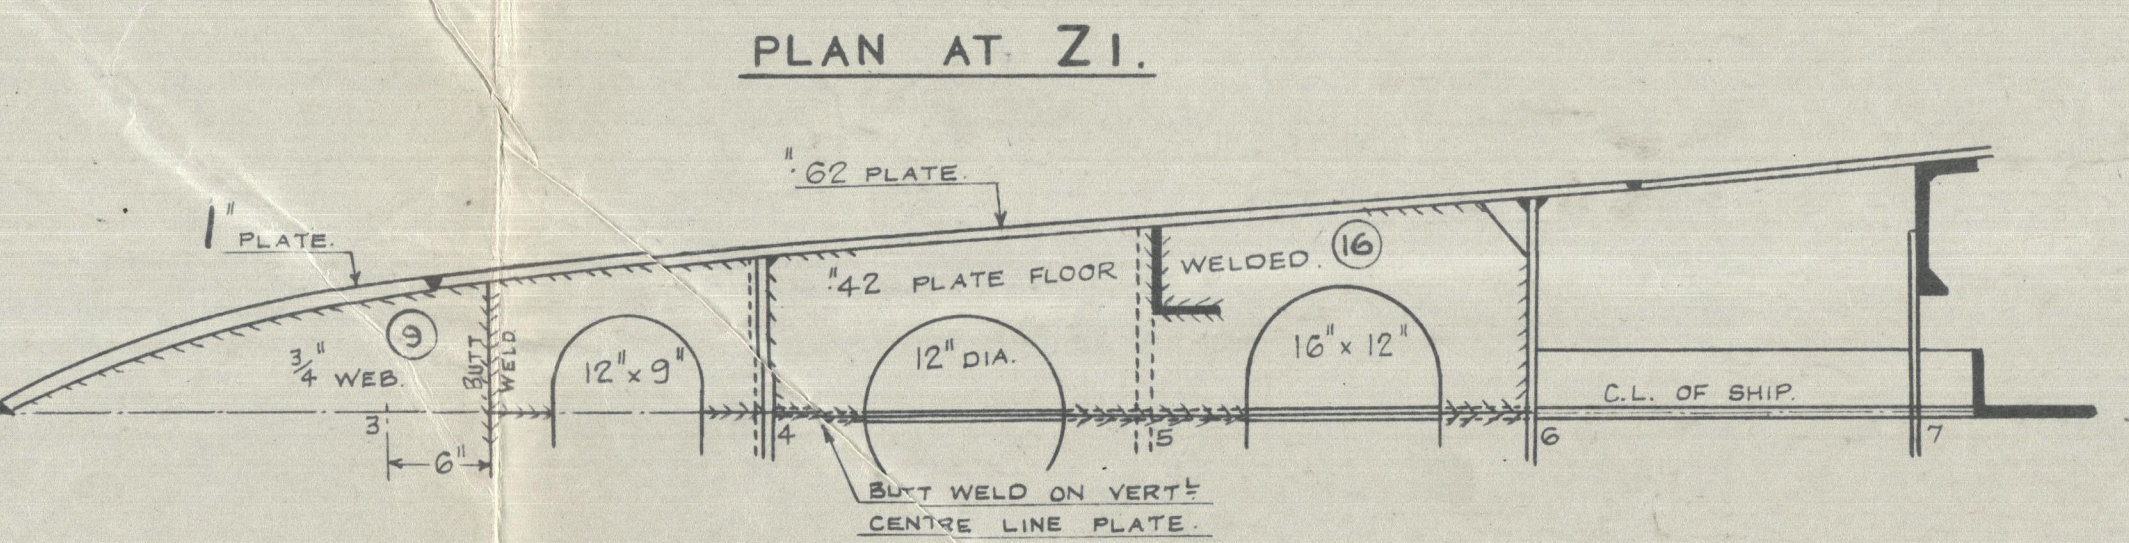


SECTION FR. 5.

LOOKING AFT.

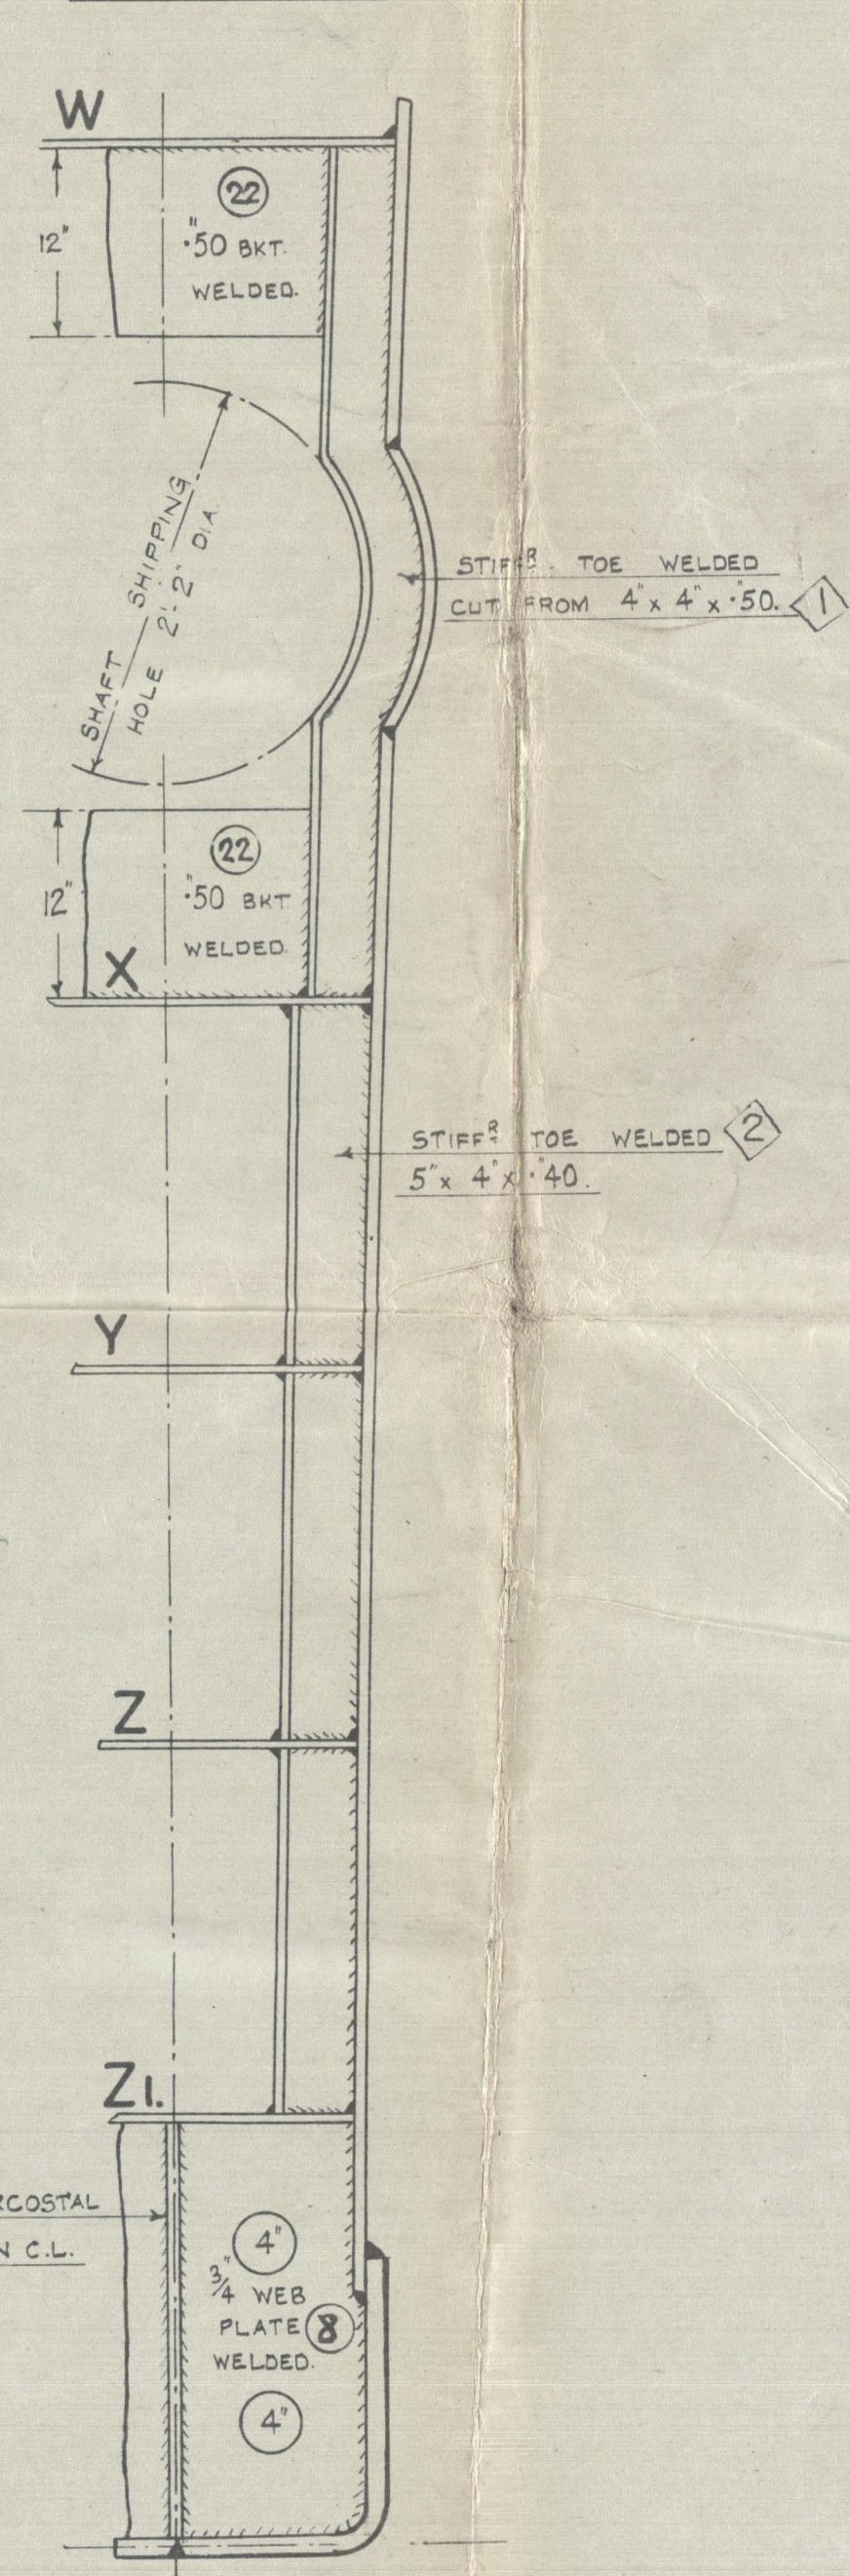

SECTION FR.4.

LOOKING AFT.

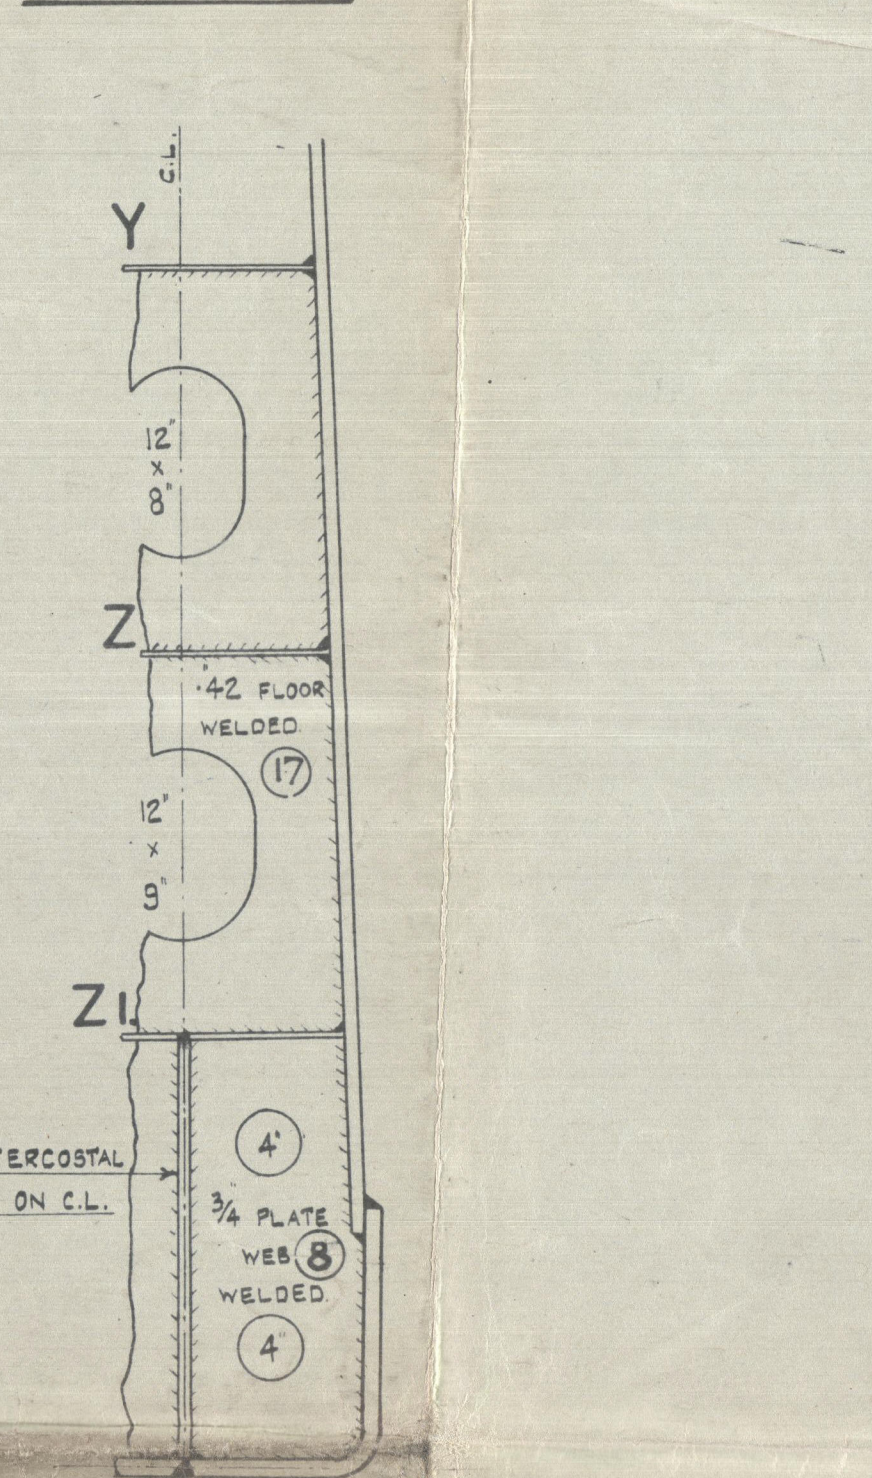

Granthill

9-0 F
4-6 A

Shen frame.

SOUTHWICK YARD NO 4

"Empire Cowdrey"

SUNDERLAND RPT. NO. 34064.

Baxtergate X.



©2020
5

Lloyd's Register
Foundation

002477-002484-0004