

S/S N° 288


# RUDDER & STERNFRAME

TO CLASS +100 A.1 AT LLOYDS


SCALE  $\frac{5}{4} = 10$

A x D = 93  $\frac{1}{2}$  x 31 = 2893

SPEED UNDER 10 KNOTS

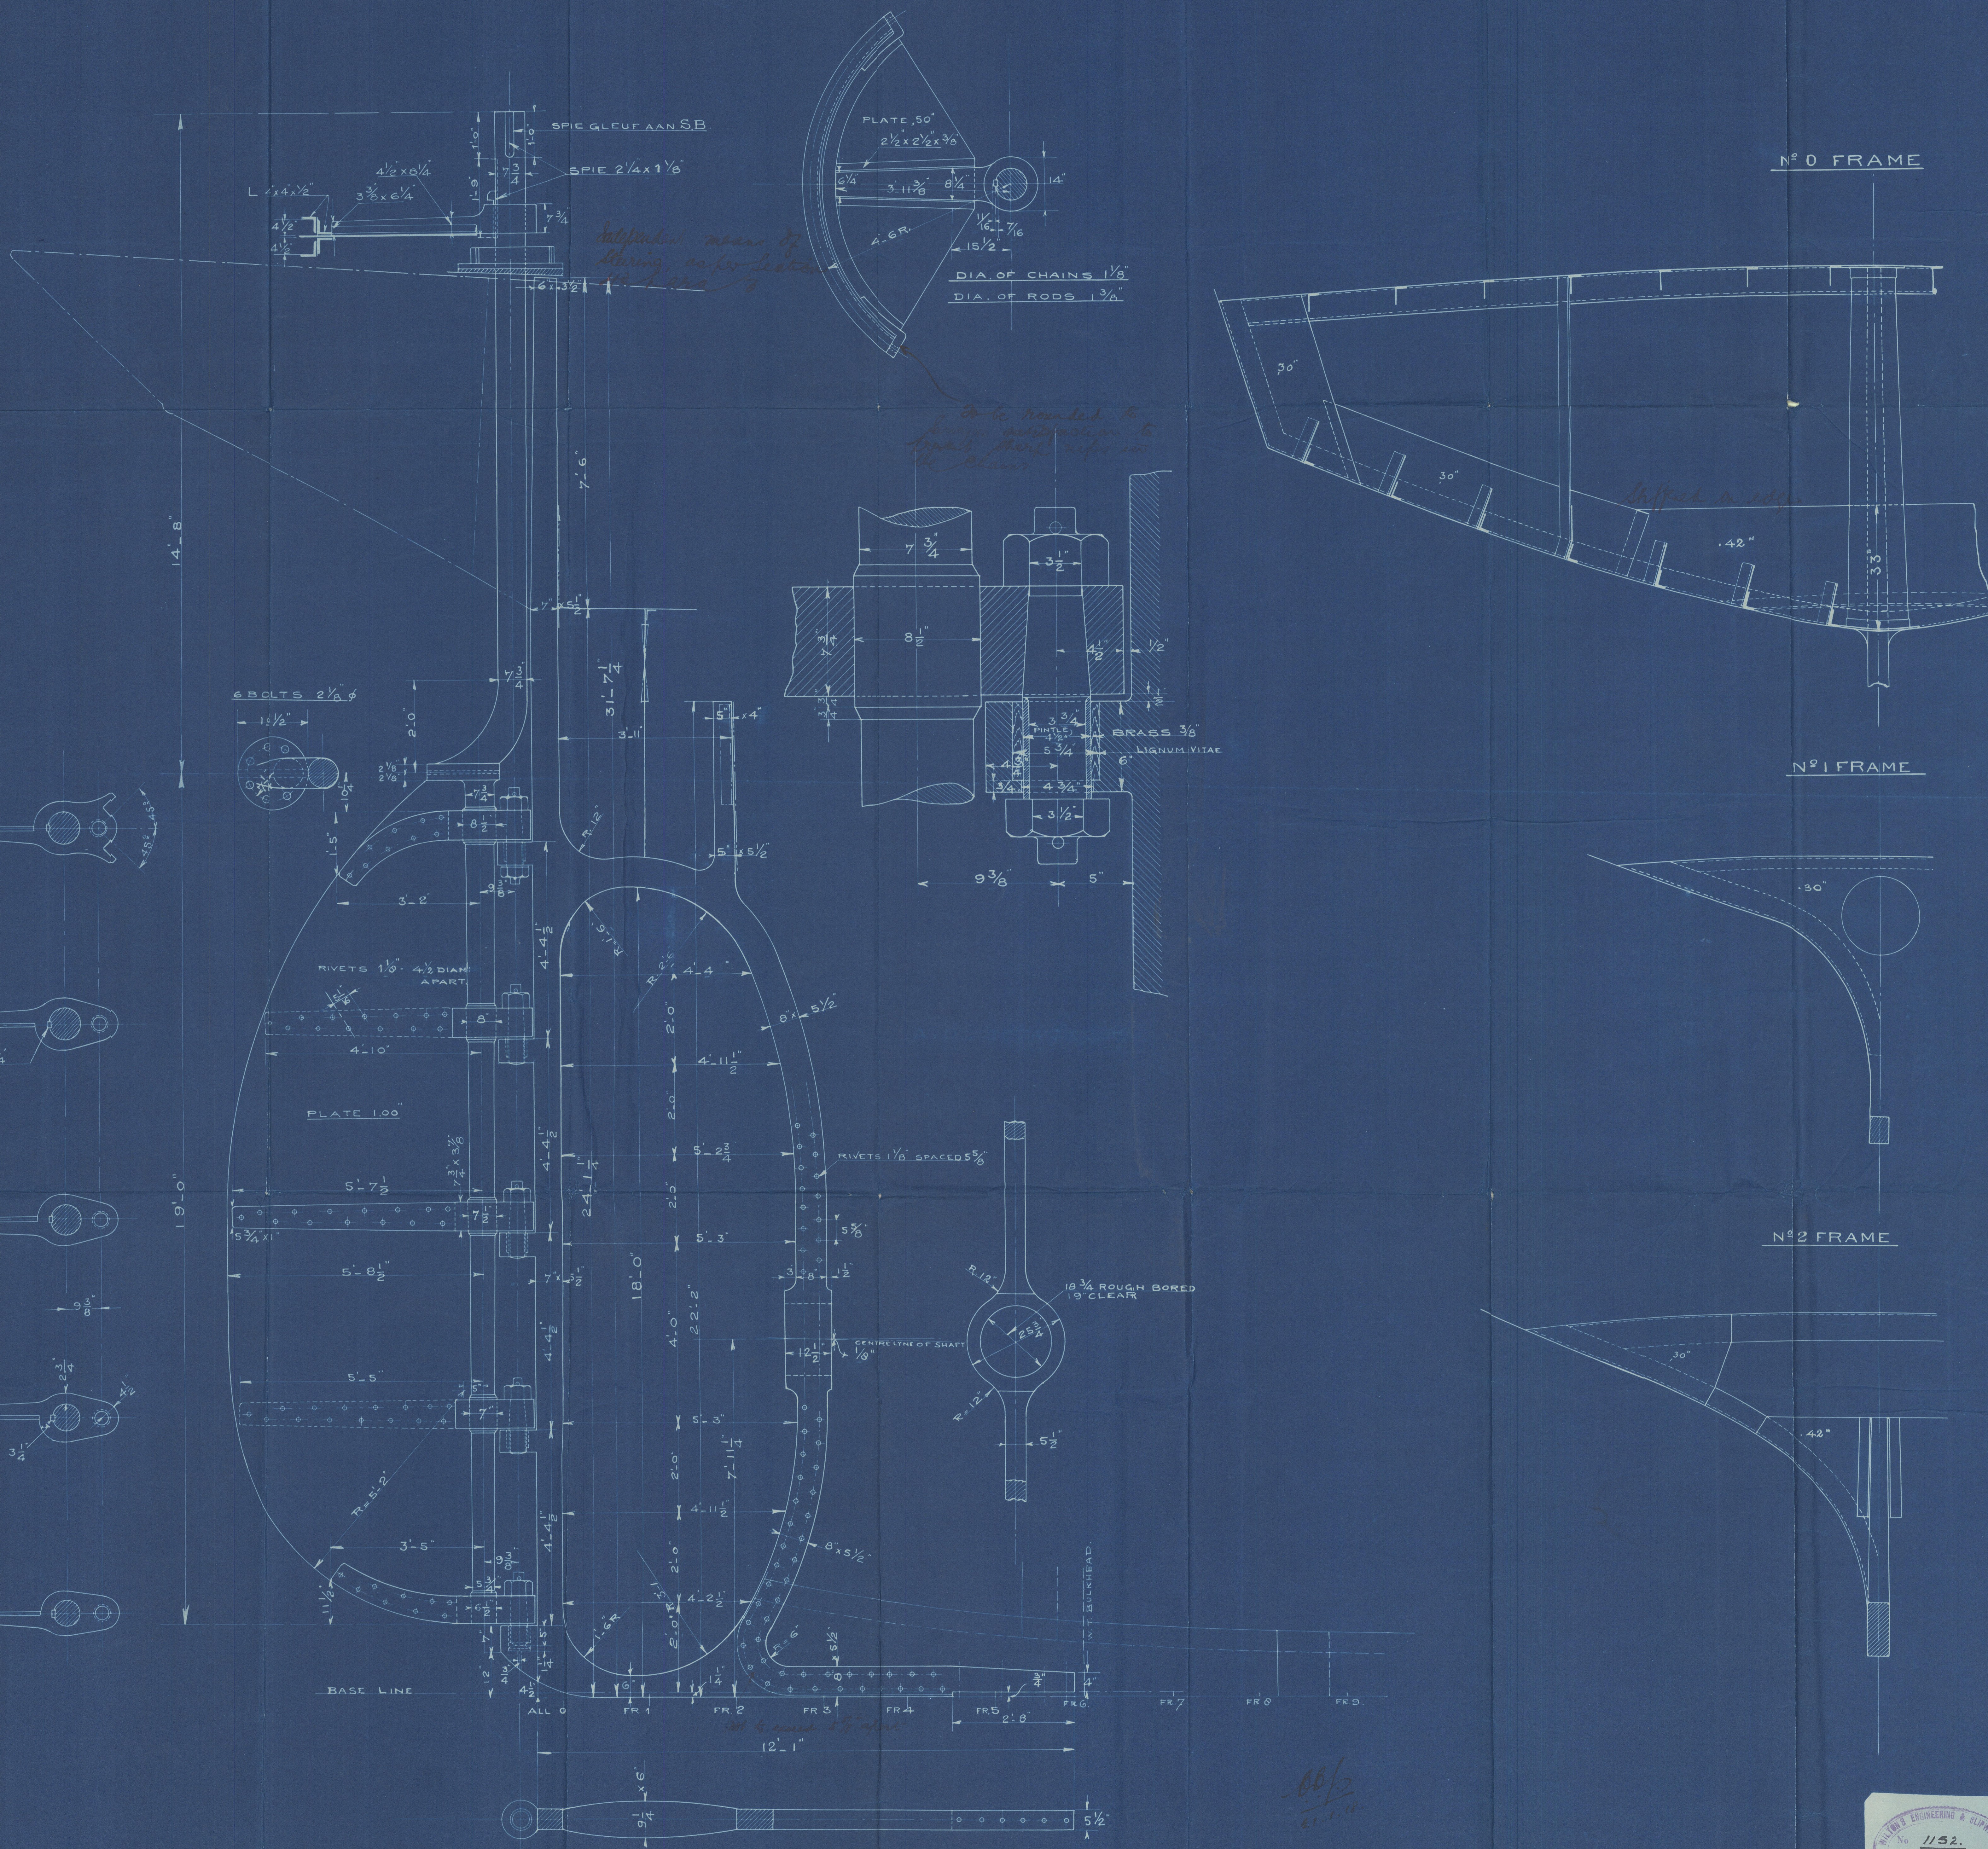

S/S "Veneborg"  
ex Eigen Hulp VII

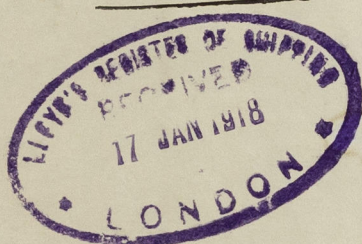

Sternframe and Rudder

Rotterdam

Report No. 10773



© 2020

Lloyd's Register  
Foundation

002477-002484-0115