
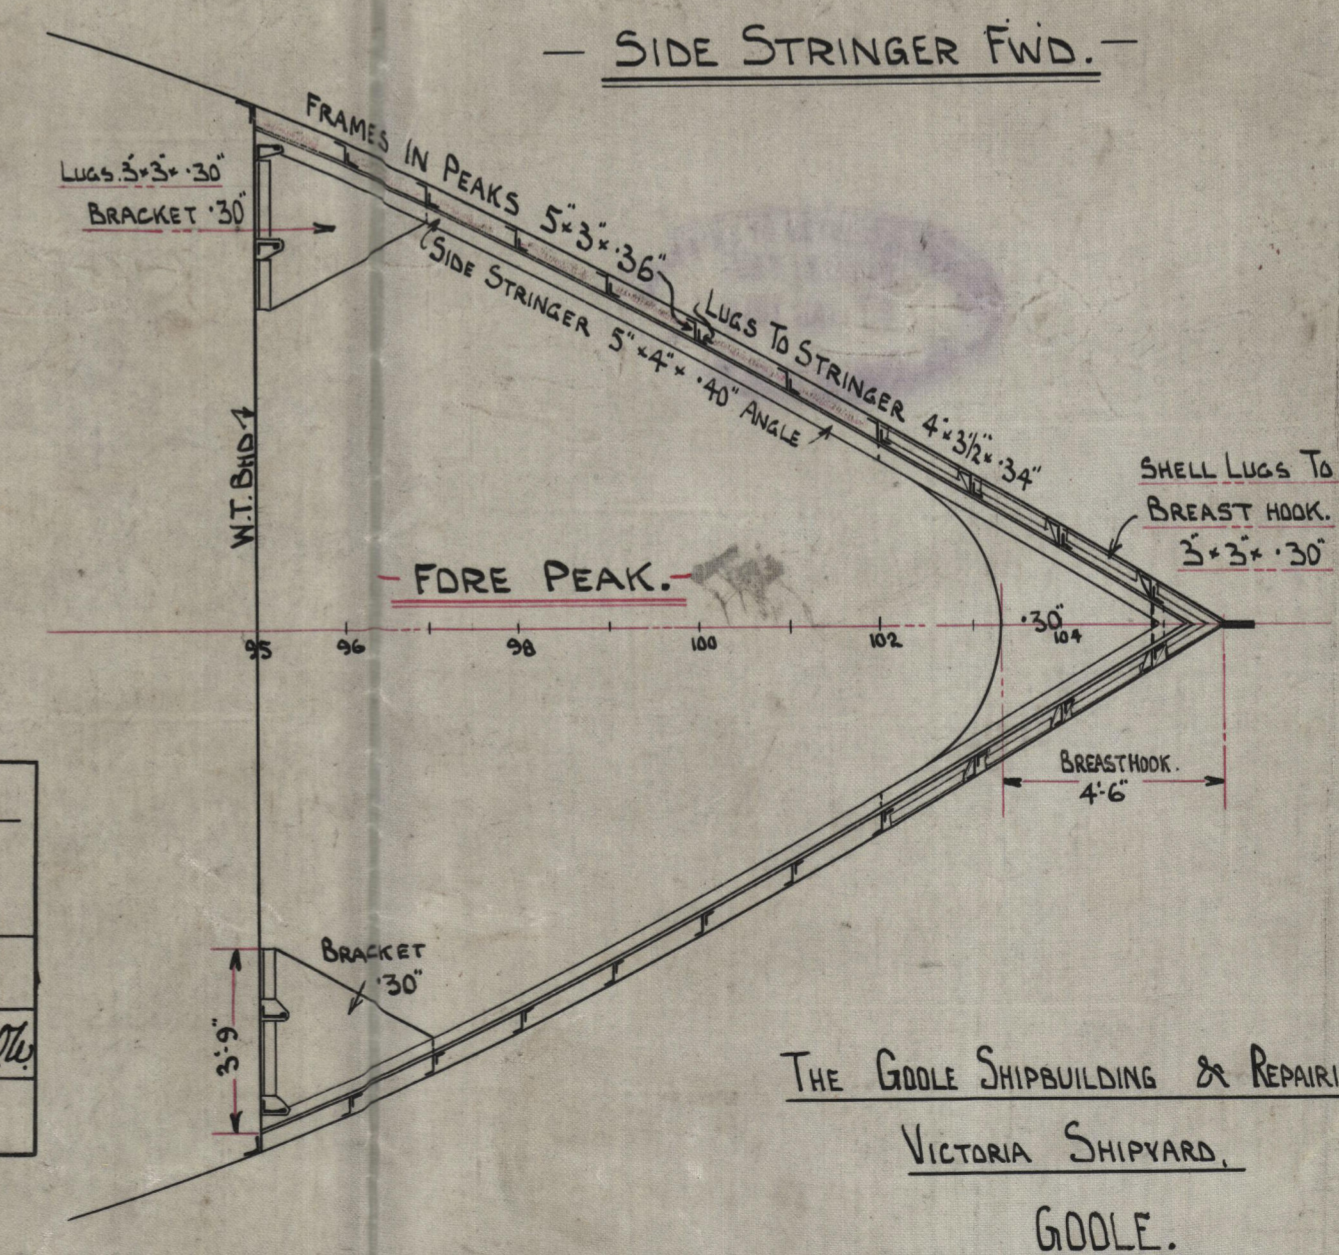
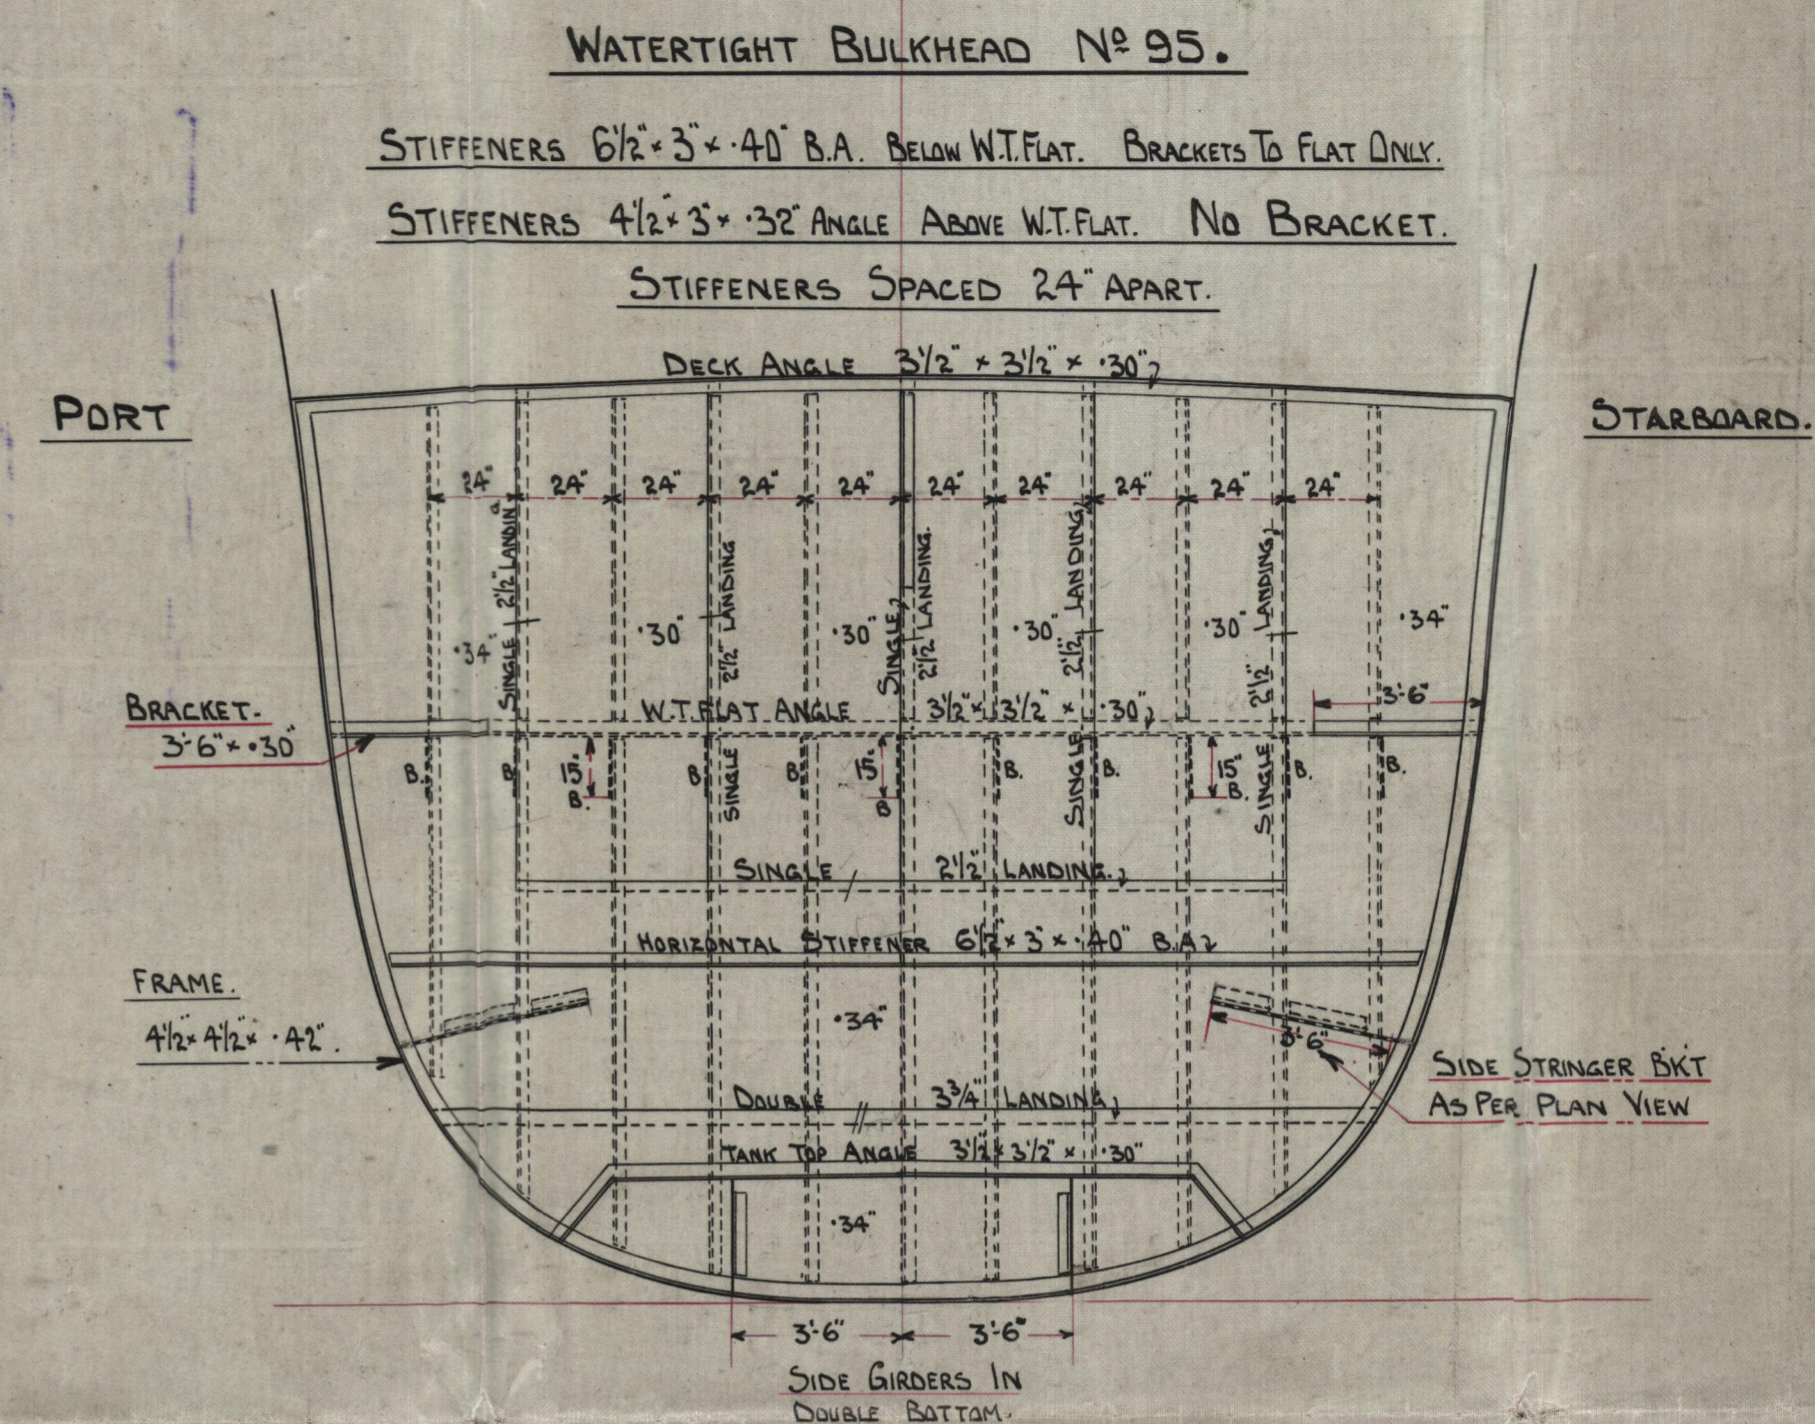
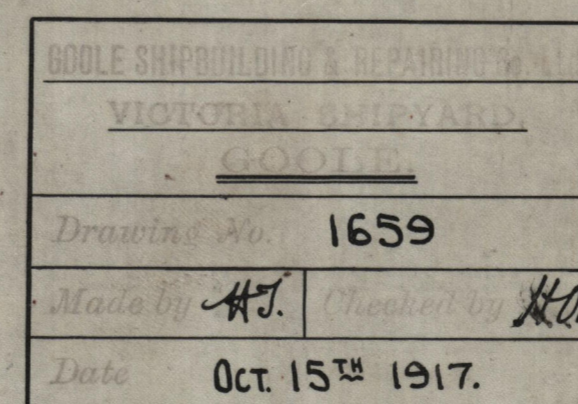


6/11/17

PLAN OF  
STRENGTHENING FORWARD.

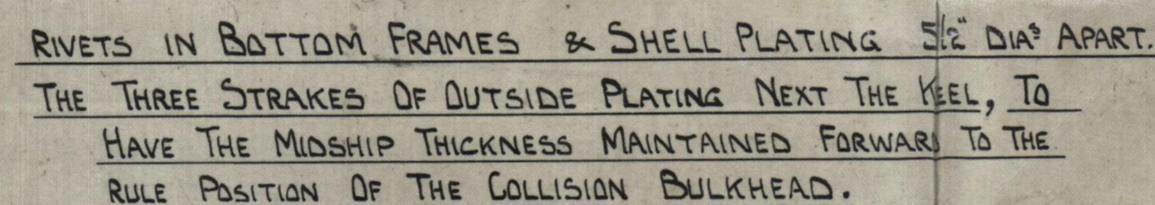

THE GOOLE SHIPBUILDING & REPAIRING CO. LTD.,  
VICTORIA SHIPYARD,  
GOOLE.

66/

Hall Rpt No 3090.

Lloyd's Register  
Foundation

002477-002484-0155