

6/11/17

BULKHEAD N^o 8
PLATING. .26.
STIFF^{RS}. ~~4 1/2" x 3" x .36"~~ 6 1/2" x 3" x .46
SPACED 24" APART. NO BRACKETS.
FRAME 4 1/2" x 4 1/2" x .44".
BEAMS 3 1/2" x 3 1/2" x .32".

S.S. № 179.

PROFILE & DECK PLANS.

DIMS:- 200'-0" B.P. x 32'-0" MLD. x 15'-1" MLD. MIN Dk.

— SCALE $\frac{1}{8}" = 1 \text{ FT.}$ —

BULKHEAD N° 95.

PLATING $\cdot 34^{\circ}$ TO $\cdot 30^{\circ}$

STIFFS. BELOW FLAT $6\frac{1}{2} \times 3 \times 40\text{BA}$ BRACKETS TO FLAT

NO BRACKETS TO " ABOVE " $4\frac{1}{2} \times 3 \times 36\text{DA}$ SPACED 24" APART.


HORIZONTAL STIFFS $6\frac{1}{2} \times 3 \times 40\text{BA}$.

DECK ANGLE $3\frac{1}{2} \times 3\frac{1}{2} \times 30$

FRAME ANGLE $4\frac{1}{2} \times 4\frac{1}{2} \times 42^{\circ}$.

Drawing	1653.
Material <i>MS.</i>	checked by <i>MS.</i>
Date	OCTOBER 10 TH 1917.

PILLARING THROUGHOUT TO SURVEYORS SATISFACTION.

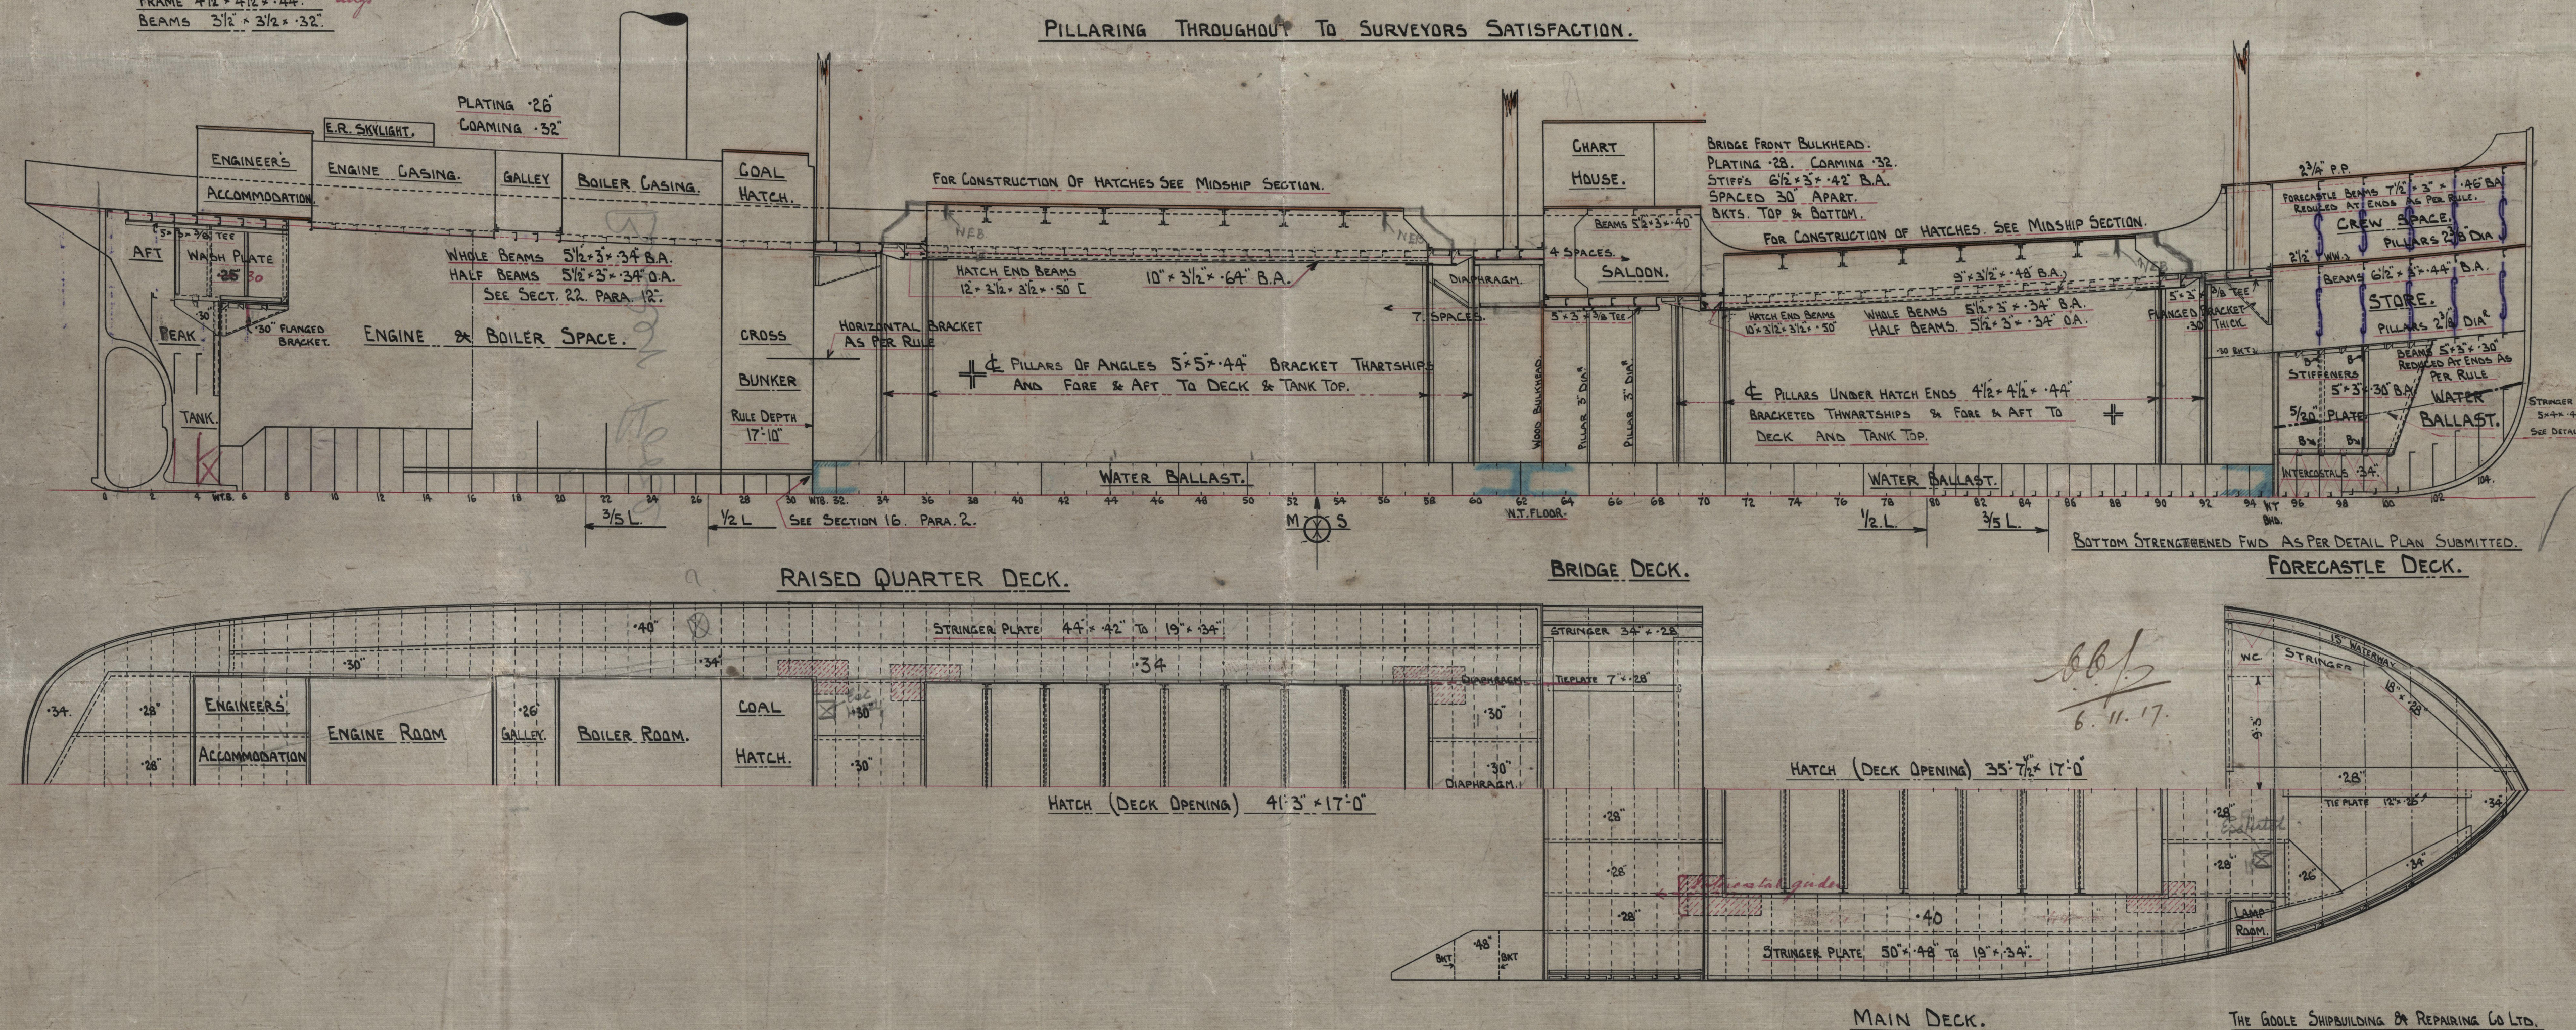

THE GOOLE SHIPBUILDING & REPAIRING CO LTD.
VICTORIA SHIPYARD
GOOLE.

002477-002484-0151

002477-002484-0156

