

Nos 11969 & 11979

# FRAMING PROFILE.

DIMENSIONS:- 460'-0" B.P. x 59'-0" x 34'-10" MLD



SCALE:- 1/8" = 1 FOOT.

No 11969 TO CLASS LLOYDS 100 A1<sup>+</sup>  
"CARRYING PETROLEUM IN BULK."

No 11979 TO CLASS B.S.\* (BULK OIL CARRIER).

LONGITUDINAL FRAMING AT BOTTOM & AT DECK.

ALL SECTIONS ARE TO "NEW BRITISH STANDARD"

 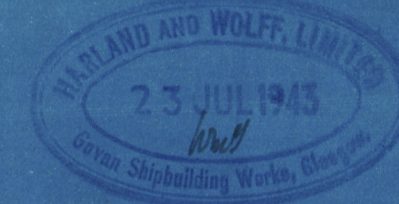

APPROVED  
LLOYD'S REGISTER OF SHIPPING  
James R. Clark  
DATE 29/1/43

PLANS FOR FORE END FRAMING &  
DEEP TANK TO BE SUBMITTED

002490-002497-0126

89.101

L

A



© 2020

Lloyd's Register  
Foundation


HARLAND & WOLFF L<sup>TD</sup>

N<sup>o</sup> 11969.

(3)

"FRAMING PROFILE"

W/S 647

1196 British Inglew 

At Glasgow Rpt No 69631

R. GLASGOW REPORT No. 69699

W/S R 647

002490-002497-0126

© 2020

Lloyd's Register  
Foundation