


# Lloyd's Register of Shipping.

## SURVEYS FOR FREEBOARD.

(CONDITIONS OF ASSIGNMENT.)

N<sup>o</sup> 34527Ship's Name M.V. "BRITISH MARSHAL"Port of Survey SunderlandOfficial Number 180959Surveyor's Signature Naël F.H. DuncanNationality and Port of Registry British LondonDate of Survey During Construction

Disposition and dimensions of superstructures, trunks, deckhouses and machinery casings to be inserted in the diagrams and tabular statement:—

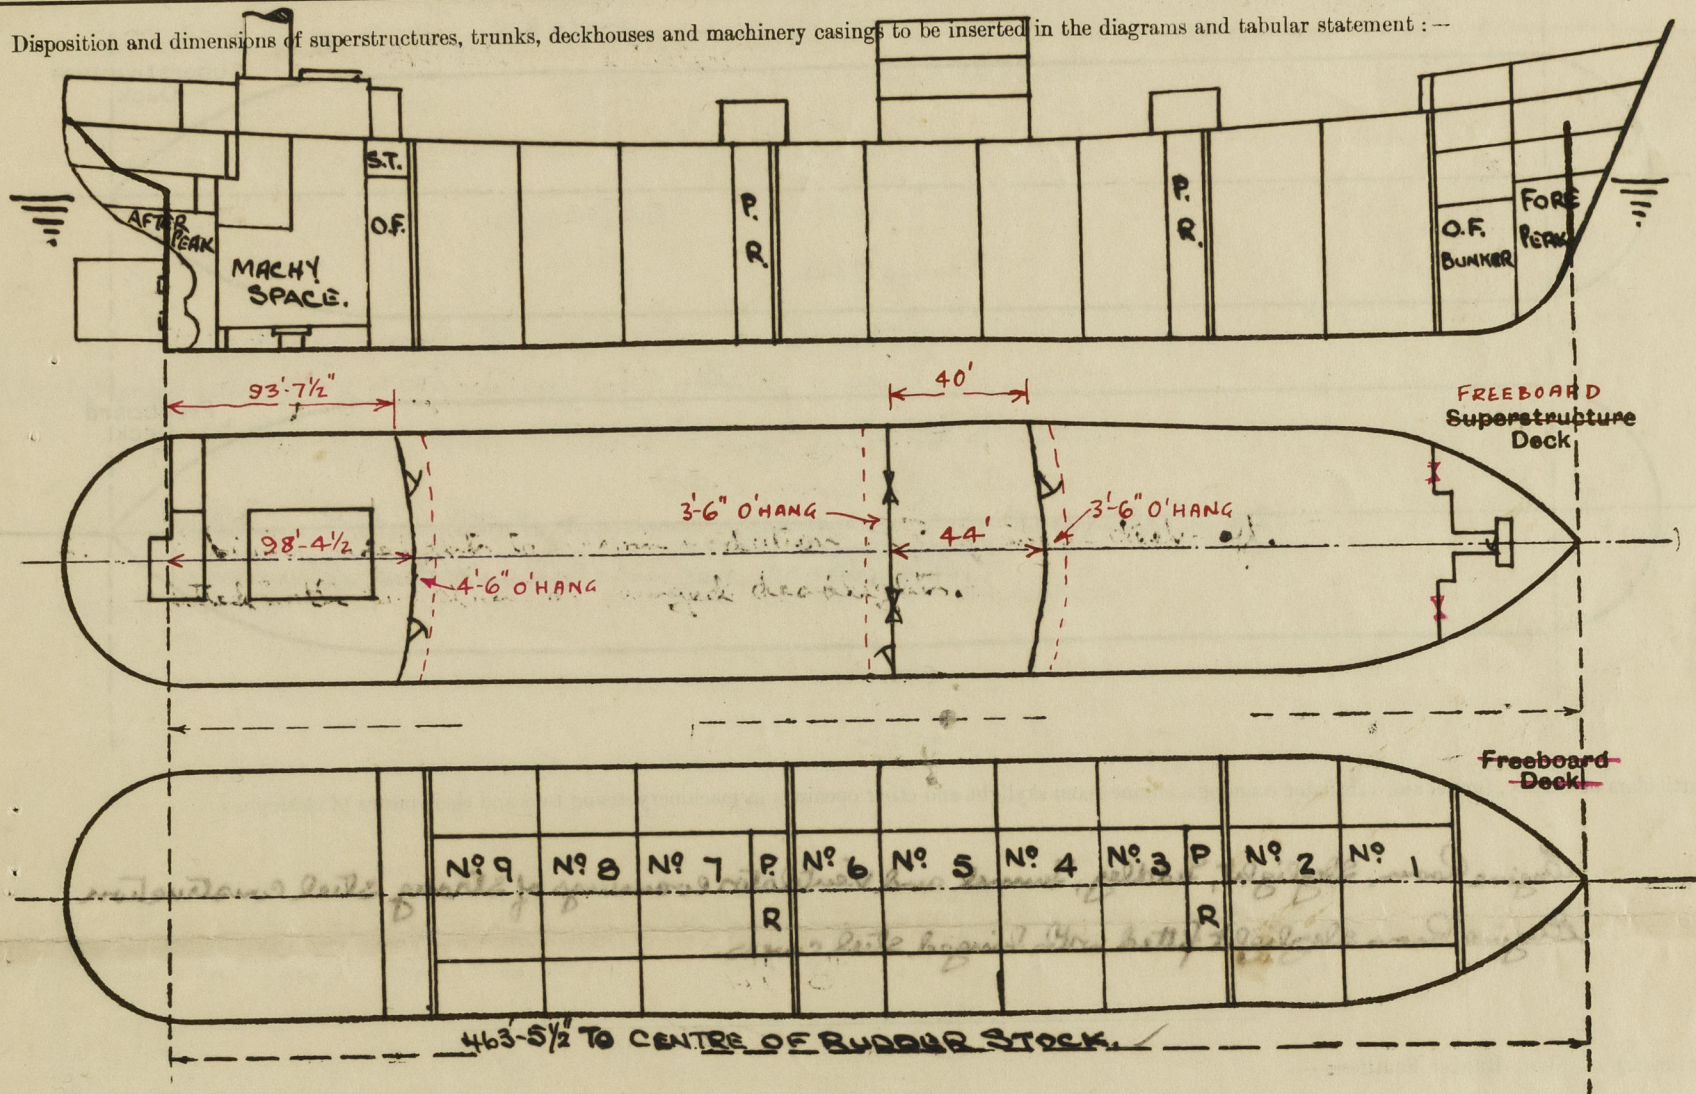


Particulars of Superstructures, Trunks, Casings, Deckhouses.								
	Coaming	Plating	Stiffeners	Spacing	End Attachments of Stiffeners	Size of Openings	Height of Sills	Height of Casings
Poop Bulkhead ...	44	44	10x32x40 L	30"	Lugs T+B	2@5'-0"x3'-0"	18"	8'-0"
Raised Quarter Deck Bulkhead ...						2@4x3-1	19"	
Bridge, After Bulkhead ...	30	30	4x3x32 L	30"	✓	1@4x3x2-3	18" W.T.D.	8'-0"
Bridge, Forward Bulkhead ...	44	44	10x32x40 L	30"	Lugs T+B	5-0x3-0 1@4x3x2-0	18"	8'-0"
Forecastle Bulkhead ...	31	31	3 1/2 x 3 1/2 x 38 L	24" and 27"	✓	2@4-1x3-1	19"	8'-0"
Trunk, Aft ...								
Trunk, Forward ...								
Exposed Machinery Casings on Freeboard or Raised Quarter Decks ...								
Exposed Machinery Casings on Superstructure Decks ...								
Machinery Casings within Superstructures not fitted with Class I Closing Appliances ...								
Deckhouses on Flush Deck Ships ...								
Particulars of Closing Appliances (state if capable of being manipulated from both sides).								
Poop Bulkhead ...	Two mechanics W.T. Doors.							
Raised Quarter Deck Bulkhead ...								
Bridge, After Bulkhead ...	Two with shifting boards fitted in channels; One with W.T. Door.							
Bridge, Forward Bulkhead ...	Two mechanics W.T. Doors.							
Forecastle Bulkhead ...	Two with shifting boards fitted in channels; One with W.T. Door.							
Exposed Machinery Casings on Freeboard or Raised Quarter Decks ...								
Exposed Machinery Casings on Superstructure Decks ...								
Machinery Casings within Superstructures not fitted with Class I Closing Appliances ...								
Deckhouses on Flush Deck Ships ...								



# PARTICULARS OF PROTECTION TO OPENINGS, ETC.

The following diagrams should be used to indicate the positions of cargo and coaling hatchways, gangway, cargo and coaling ports, ventilators, companionways, etc., which would affect the seaworthiness of the ship:—

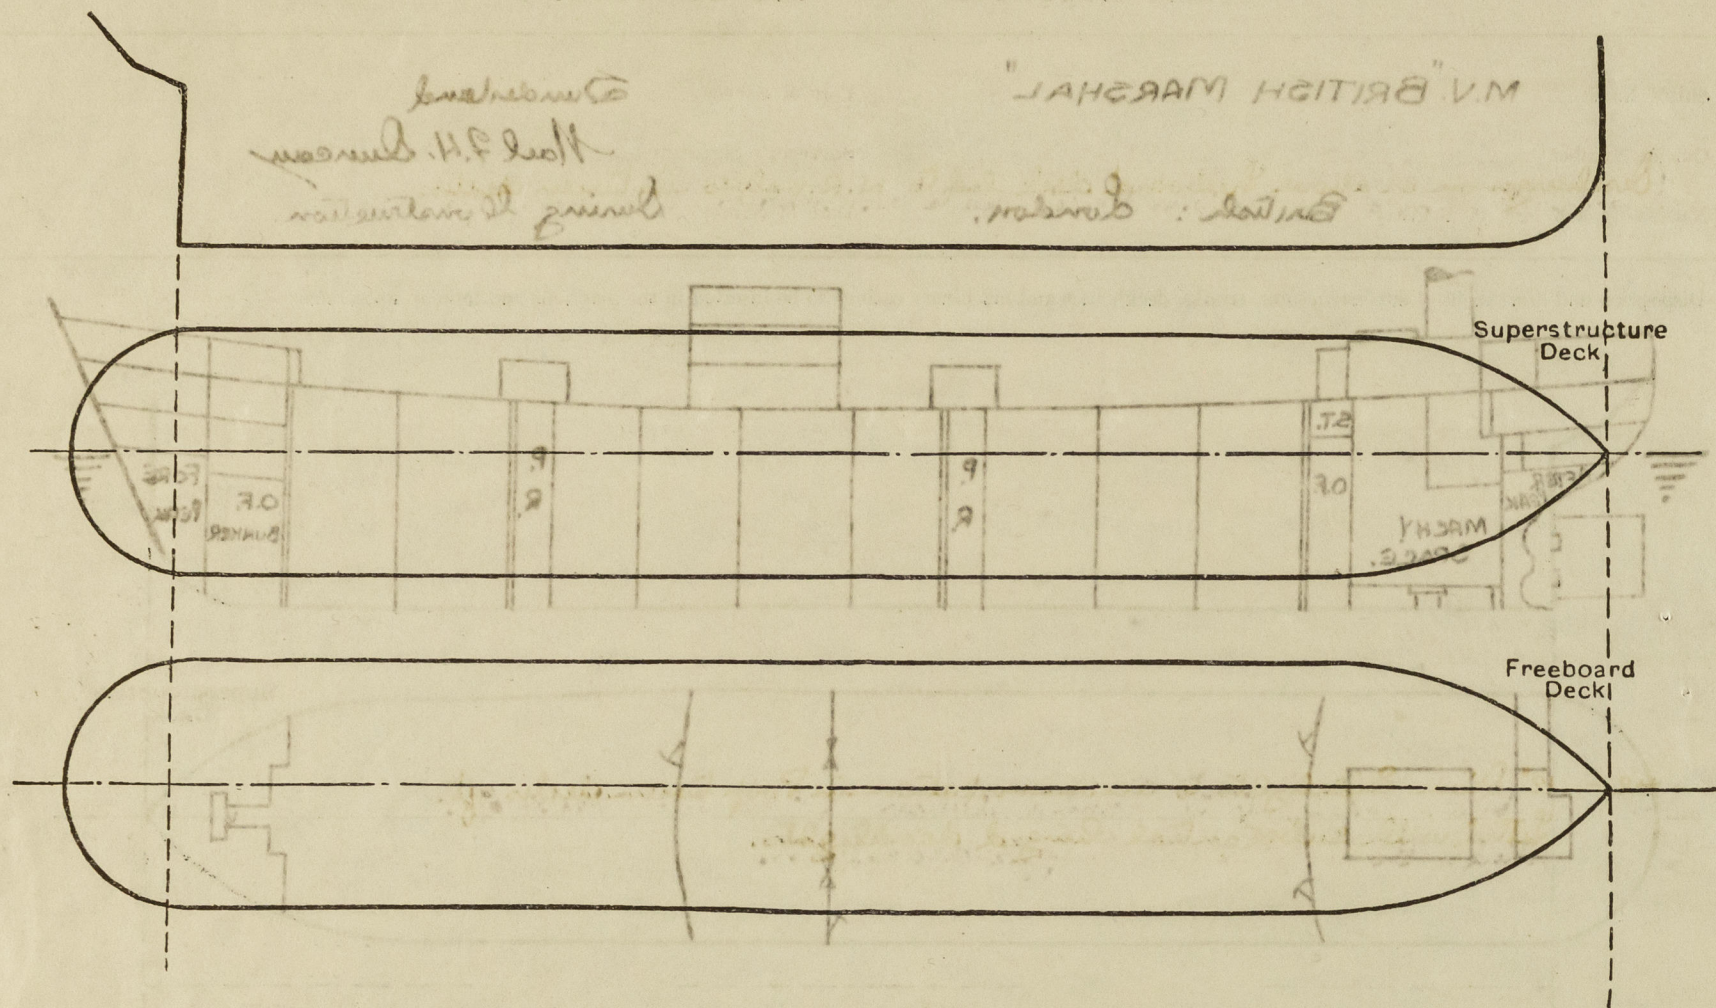

Particulars of fiddle, funnel and ventilator coamings, engine room skylight and other openings in machinery casing tops and their means of closing:—

Engine Room, Skylight, Fiddle, Funnel and Ventilator coamings of strong steel construction.  
Engine Room skylight fitted with hinged steel covers.

Particulars of Flush Bunker Scuttles:—

None.

Particulars of Companionways:—

Forward Pump Room entrance: Plating 30", Stiffeners 4"x3"x30" with 3"x3"x30" reverse bars fitted to fore bld., 4'-3"x2'-3" W.T. Door, coaming 18"x30", Stiffeners spaced 30" apart with ribs top and bottom.  
After Pump Room entrance: Plating 30", Stiffeners 4"x3"x30" with 3"x3"x30" reverse bars fitted to fore bld., 4'-3"x2'-3" W.T. Door, coaming 18"x30", Stiffeners spaced 30" apart with ribs top and bottom.

Particulars of Ventilators in exposed positions on freeboard and superstructure decks:—

1	Round Vent	8" Diam.	Coaming 36"x30" to fore Peak stow	Fore Deck
3	"	8"	" 36"x30" to fore Peak stow	
2	"	12"	" 36"x34" to fore Peak stow	
1	"	12"	" 36"x34" to fore Pump Room	Poop Deck
2	"	12"	" 36"x34" to fore Hold	
2	"	6"	" 30"x30" to Steering Gear	
2	"	6"	" 30"x30" to Store Room	
1	"	9"	" 30"x32" to Refrig. Machinery	

All Round Vents closed by means of wood plugs and canvas covers.

Particulars of Air Pipes in exposed positions on freeboard, raised quarter, or superstructure decks:—

All Air Pipes of a Patent type and in accordance with approved plan (3.1.46)  
Automatic Vent pipes for Oil Fuel and Waste Water Tanks.

Particulars of Gangway Cargo and Coaling Ports:—

None.

Particulars of Scuppers and Sanitary Discharge Pipes:—

Discharge on a above foreboard deck led to N.R. valves in tween decks.

Particulars of Side Scuttles:—

42 - 12" Diam Side Lights to accommodation in Poop tween decks aft.

Fitted with substantial hinged deadlights.


Vertical distance of Sill of lowest Side Scuttle above top of keel

41'-0"

Particulars of Guard Rails:—

Open rails fore and aft 3'-6" in height: Steel Bulwarks amidships fore of bridge 18'-0" with one freeing port 15'-0"x9": Aft of bridge 30'-0" with one freeing port 15'-0"x9"

Particulars of Gangways, Lifelines, etc.:—

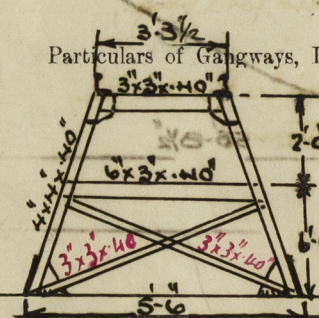

Fore and Aft Gangway 8'-0" in height from keel to bridge, and from bridge to Poop.  
5'3" Upright line fore and aft. Stringers Angle 6"x3"x40 B.A. Bracing 18' fore and 17' aft. Supported spaced 8' apart. Rails 3'-6" in height (two rails) with stanchions spaced 4'-0" apart.  
Gangway supports welded to deck line and aft bracing 2' fore and 2' aft.

Particulars of Freeing Arrangements.

	Length of Bulwark	Height of Bulwark	Size of Freeing Ports	Number each side	Area each side	Rule area each side
After Well ...						
Forward Well ...						

State position of each freeing port ... After Well:—  
(F. and A. position and height above deck edge) Forward Well:—

State whether the freeing ports are fitted with shutters, bars, or rails, and give particulars of such:—

Additional area where sheer is less than standard.

British Marshal.



# PARTICULARS OF PROTECTION TO OPENINGS, ETC.

HATCHWAYS ON FREEBOARD AND SUPERSTRUCTURE DECKS.			
Description of Hatchway ... ..		Freeboard Deck.	
Dimensions of Hatchway ... ..		Hatches to Main Cargo tanks 6'-0" x 4'-0" beamings 12"x 2" flat welded to deck. Watertight covers .64 16 Joggles.	
COAMINGS	Height above Deck ... ..	2 Hatches to After Cofferdam 2'-11" x 2'-11" beamings 30"x 44"	
	Thickness { Sides ... .. Ends ... ..	Watertight covers .50 7 Joggles.	
HATCH BEAMS	Stiffeners ... ..	2 Hatches to Forward Cofferdam 2'-11" x 2'-11" beamings 30"x 44"	
	Brackets, Stays ... ..	Watertight covers .50 7 Joggles.	
FORE AND AFTERS	Number ... ..	Hatch to Green diesel forward 10'-0" x 6'-9" beamings 30"x 44"	
	Spacing ... ..	Watertight covers .50 24 Joggles.	
HATCH COVERS	Unsupported Lengths ... ..	Hatch to Refrig Space 2'-9" x 2'-9" beamings 30"x 44"	
	Scantling and Sketch ... ..	3" Wood Covers with 2 tarpaulins, beamings spaced 18"	
HATCH BEAMS	Bearing Surface ... ..	Hatch to Steering Gear 2'-0" x 2'-0" beamings 30"x 44"	
	Material ... ..	Watertight covers .50	
HATCH COVERS	Thickness ... ..	Forecastle Deck	
	How fitted ... ..	Hatch to Life Space 2'-0" x 18" beamings 12"x 44" W.T. Covers .50	
HATCH COVERS	Bearing Surface ... ..		
Spacing of Cleats ... ..			
Number of Tarpaulins ... ..			
<p>*Are wood fore and afters steel shod at all bearing surfaces? <input checked="" type="checkbox"/></p> <p>Are battens and wedges efficient and in good condition? <input checked="" type="checkbox"/> Yes.</p> <p>Are tarpaulins in good condition and in accordance with rule requirements? <input checked="" type="checkbox"/> Yes.</p> <p>Are lashings provided in accordance with rule requirements? <input checked="" type="checkbox"/></p>			

