

RUDDER.



-S.S. N° 241.

SCALE 1" = ONE FOOT.

HOLES IN RUDDER ARMS BORED $1\frac{3}{16}$ " FOR $1\frac{1}{8}$ " RIVETS. SPACED $4\frac{1}{2}$ " DIA. APART C^R TO C^R.

" " " " To Be COUNTERSUNK.

SPEED OF VESSEL UNDER 12 KNOTS.

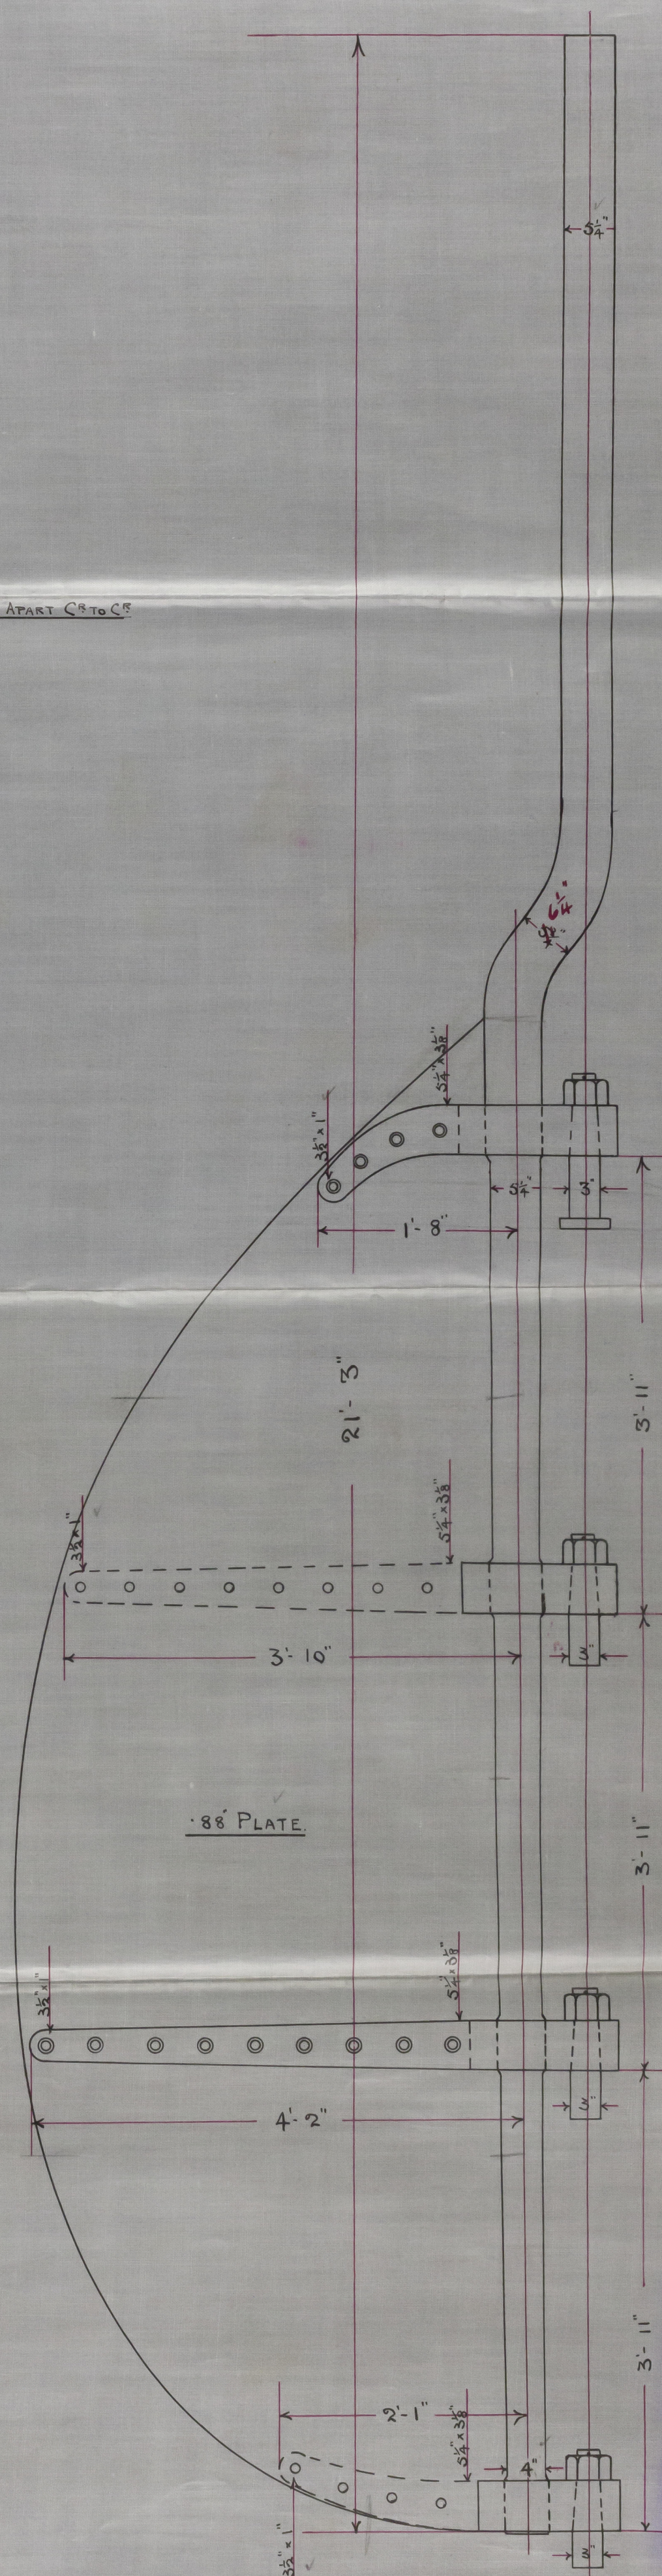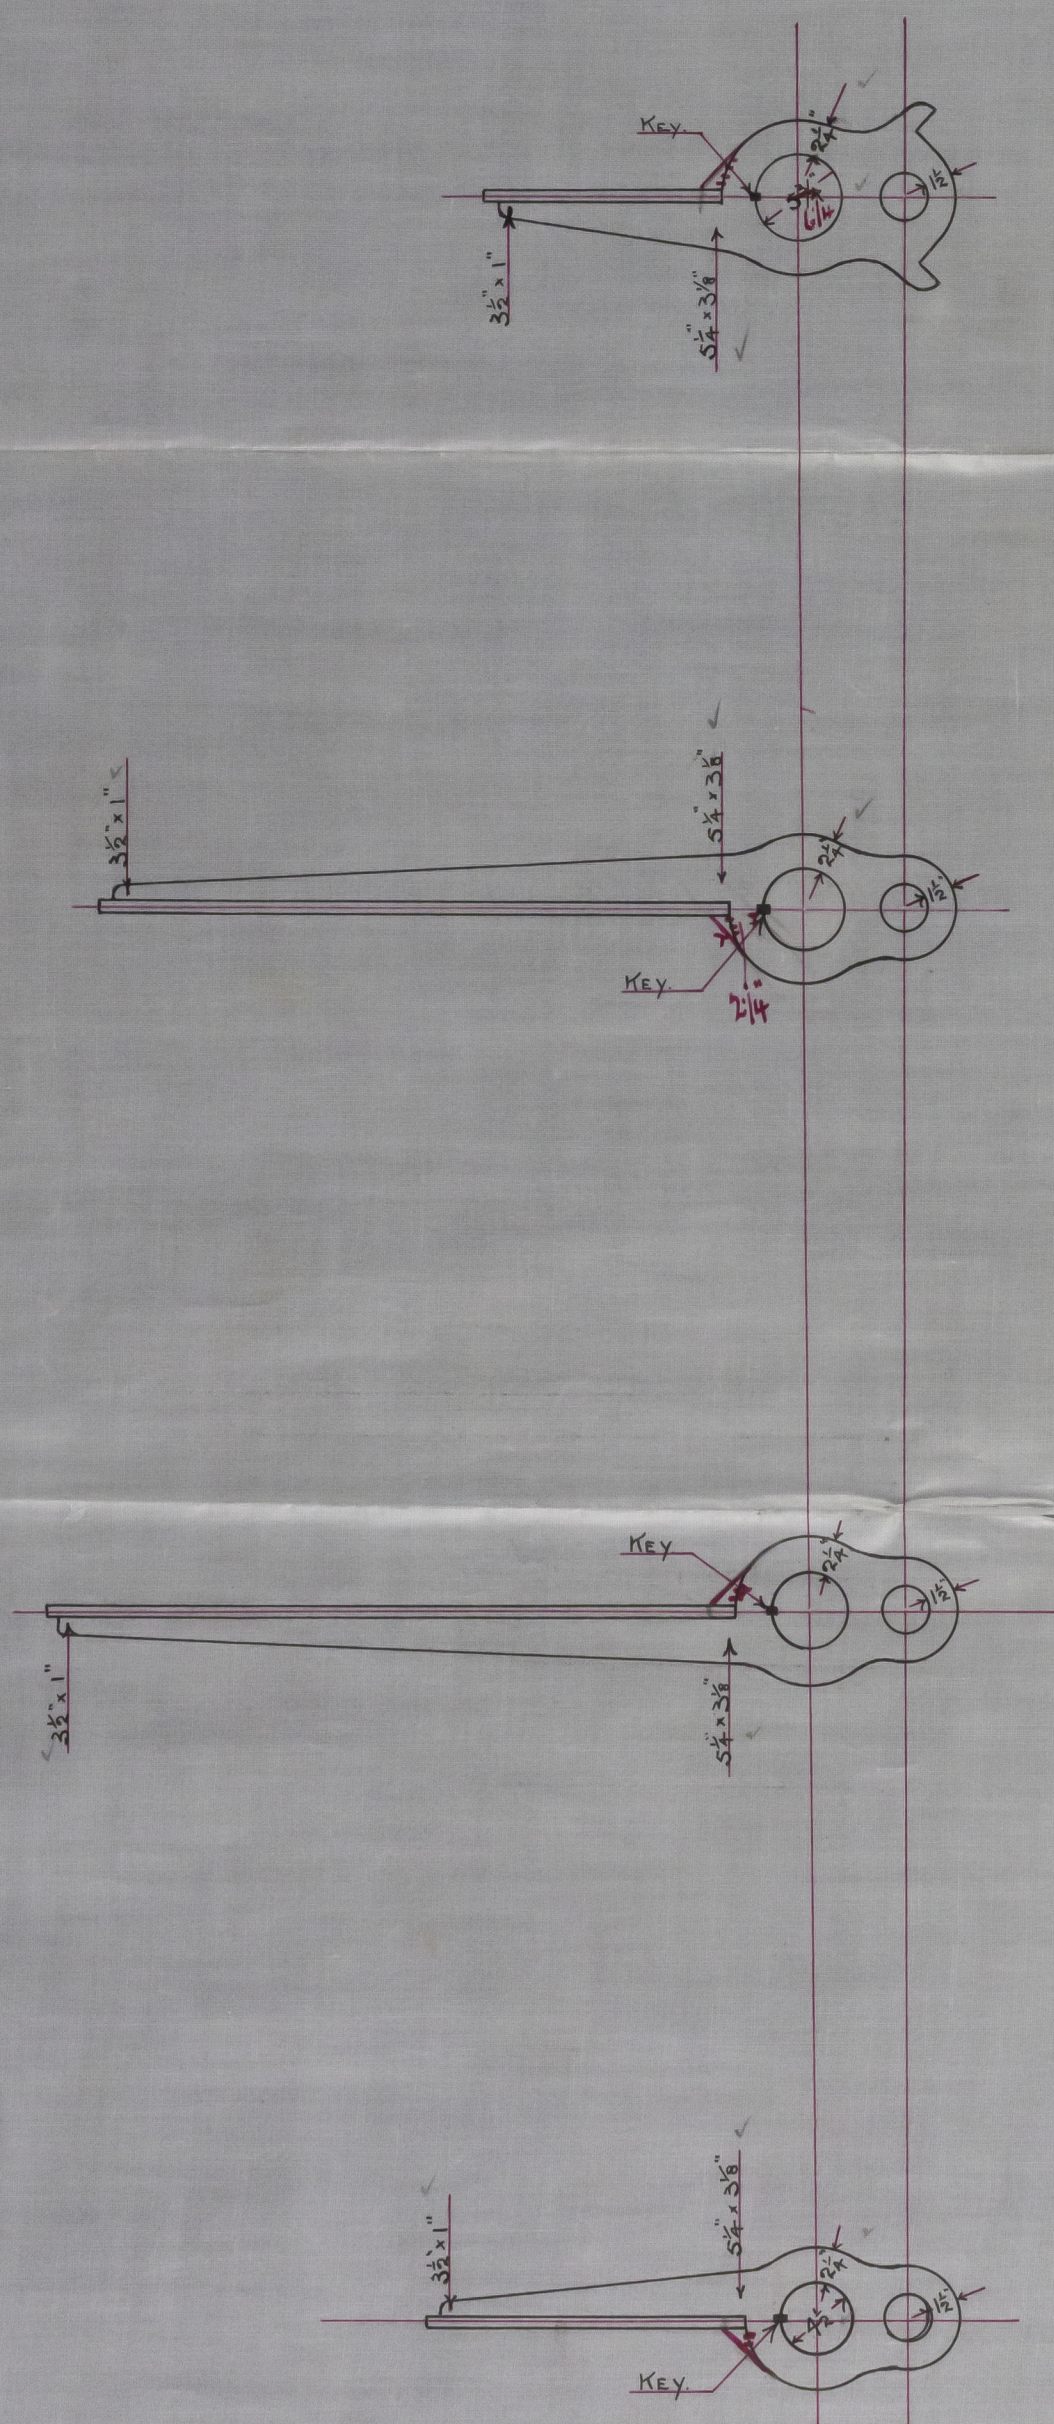

C.B.
7.5.12

Rudder

"*barnalea*"

© 2020

Lloyd's Register
Foundation

002506-002514-0028