

# MIDSHIP SECTION

YARD N° 75-6 + 77

Steel Trees & Plate bearing  
pieces as per list 32 given

W. I. FLAT  
made. w. l. to  
satisfaction wet floor

Sect 22 para. 12

Strength train times to  
20 minutes sat in pack

6" D.A. in way of  
large lake

LLOYD'S REGISTER  
12.3.24  
ABERDEEN OFFICE  
JR  
OF SHIPPING


APPROVED  
LLOYDS REGISTER OF SHIPPING

A circular purple ink stamp. The outer ring contains the text "JOHN LEWIS &amp; SONS LTD." at the top and "ABERDEEN" at the bottom, separated by two small stars. The center of the stamp contains the text "SHIPBUILDING DEPT." at the top, the date "12 MAR. 1924" in the middle, and the number "4985" at the bottom. There is some faint, illegible handwriting in the top left corner of the stamp.

APPROVED  
S REGISTER OF SHIPPI  
nt given for G. Webster  
DATE 8/4/24  
for Yaw No 77.

© 2020  
007506-00511601491's Register  
Foundation



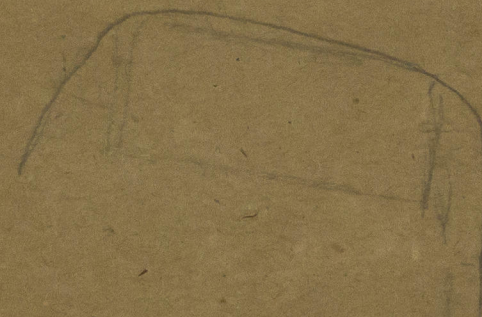

© 2020

Lloyd's Register  
Foundation



AMENDED PROFILE & SECTION. Nos. 75-6-7

JOHN LEWIS & SONS LTD.

\* S.S. ANNAGHMORE = No. 75 *NN Ballydub*  
ABN. RPT. NO. I3696.

S.S. DONAGHMORE = No. 76 *NN BALLYDONNELL*  
ABN. RPT. NO. I3770.

S.S. CARRICKMORE = No. 77 *NN CARR*  
ABN. RPT. NO. I3882. *BALLYDENE*

*BALLYDONNELL*



© 2020

Lloyd's Register  
Foundation

002506-002514-0149