

24/10/17

EQUIPMENT

LONGITUDINAL NO	8105-4
QUARTER DK. 104.5 x 3.15	391.8
BRIDGE 9.25 x 7.25 x 3/4	50.3
FORECASTLE 31 x 6.5 x 3/4	151.8
ENB CASING 54.5 x 6.6 x 1/2	179.9

EQUIPMENT NO - 8879.2

LETTER - j

2 BOWER ANCHORS (STOCKLESS) 16 3/4 CWT	COLLECTIVE WEIGHT
1 " " " 14 1/2 " "	48 CWT
1 COMMON STREAM ANCHOR 4 3/4 CWT EX STOCK	
1 " KEDGE " 2 1/4 " " "	

210 FATHOMS 1 1/4 x 1 1/2 x 1 1/2 STUD CHAIN CABLE MIN. WT. 168-0-0

60 " 3" STEEL WIRE	
75 " 2 3/4 " " "	TOWLINE
90 " EACH OF 6" AND 4" MANILLA HANGER	

R.Q.D. HATCHWAY

SIDE PLATING	44" THICK
END	44" "
WEB PLATE BEAMS	22" x 38" AS PER PROFILE
" " ANGLES	3 1/2" x 3" x 42" DOUBLE TOP & BOTTOM

SS N<sup>OS</sup> 28829 MIDSHIP SECTION

DIMENSIONS 190 Ft x 29 Ft x 13'8" M.D.

CLASS 100 A1 LLOYDS

SCALE - 1/2" = 1 FOOT

NUMERALS



TO MAIN DECK		TO QUARTER DECK	
BREADTH	29 Ft.	BREADTH	29 Ft.
DEPTH	13.66 Ft.	DEPTH	17.41 Ft.
42.66 TRANSVERSE NO			
LENGTH	190 Ft.	LENGTH	190 Ft.

8105 - LONGITUDINAL NO

L/D	13.9	L/D	10.9
d	13.66 - 2.75 = 10.9	d	17.41 - 2.75 = 14.66
		AND 15.91 IN BOILER SPACE	

RIVETING

- BUTTS OF SHELL PLATING TREBLE RIVETED FOR 1/2 L. DOUBLE AT ENDS. *See end stroke* <sup>1/2</sup> RIVETS ENDS <sup>3/4</sup> RIVETS
- " " FORECASTLE BRIDGE SIDE PLATING ALL DOUBLE RIVETED. <sup>3/4</sup> RIVETS. SHEERSTAKE BUTTS <sup>7/8</sup> TO <sup>3/4</sup> RIVETS
- " " BULKWARK PLATING. SINGLE RIVETED. <sup>3/4</sup> RIVETS
- " " MAIN DECK STRINGER PLATE TREBLE IN WAY OF HATCH, DOUBLE AT FORE END <sup>3/4</sup> RIVETS
- " " QR. DK. " " *for 1/2 length* " " AFTER END <sup>3/4</sup> RIVETS
- " " MAIN & QR. DK. PLATING ALL DOUBLE RIVETED <sup>3/4</sup> RIVETS
- " " TIE PLATES DOUBLE RIVETED <sup>3/4</sup> RIVETS
- " " CENTRE GIRDER TREBLE RIVETED FOR 3/4 L. DOUBLE AT ENDS <sup>3/4</sup> RIVETS
- " " MARGIN PLATE DOUBLE RIVETED <sup>3/4</sup> RIVETS
- " " TANK TOP MID STRAKE. DOUBLE RIVETED <sup>3/4</sup> RIVETS
- " " REMAINDER " " DOUBLE RIVETED FOR 1/2 L. SINGLE AT ENDS <sup>3/4</sup> RIVETS
- EDGES OF KEEL & SHELL PLATING ALL DOUBLE RIVETED <sup>3/4</sup> RIVETS. EDGE OF SHEERSTAKE <sup>7/8</sup> RIVETS
- " " INNER BOTTOM PLATING ALL SINGLE RIVETED <sup>3/4</sup> RIVETS
- " " DECK PLATING " " " <sup>3/4</sup> " "
- FRAMES, FLOORS, REVERSE BARS, BEAMS, KEELSONS, STRINGERS, ETC. ALL <sup>3/4</sup> RIVETS
- STEM AND STERNPOST - 1" RIVETS

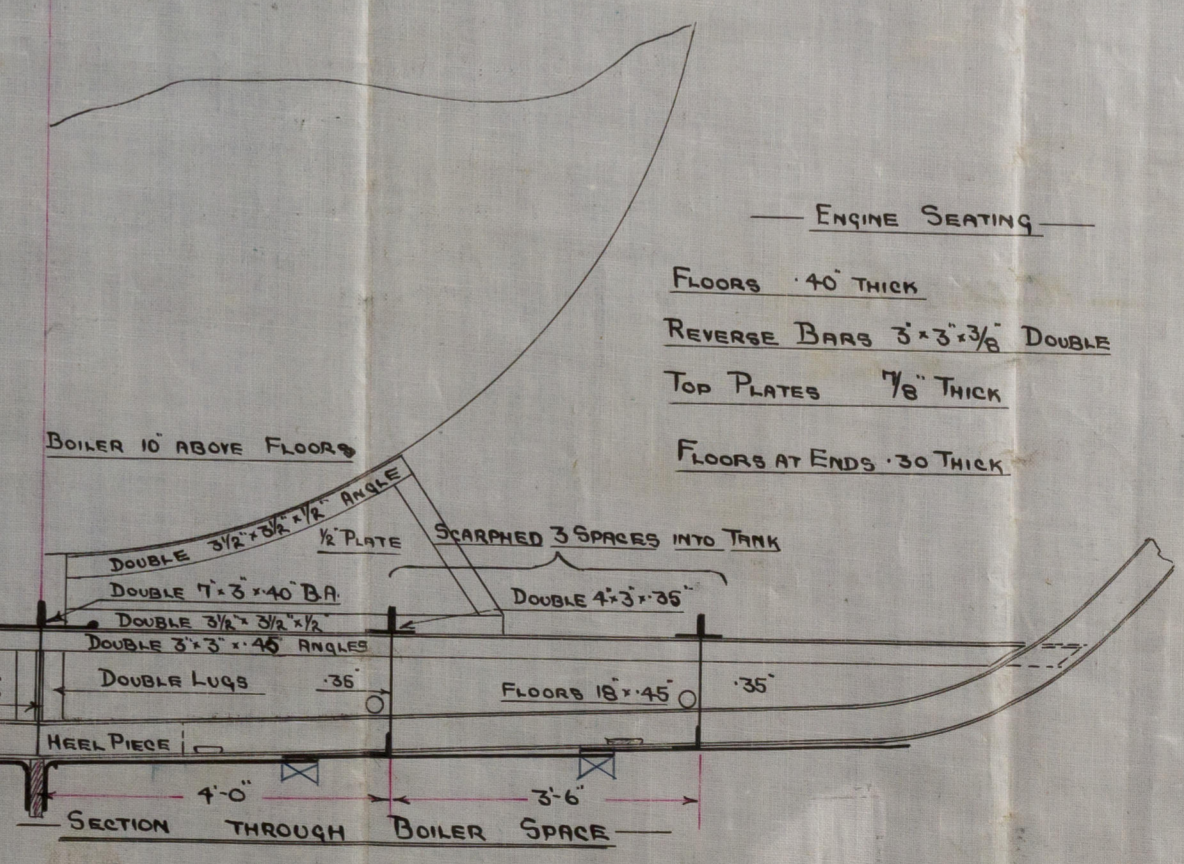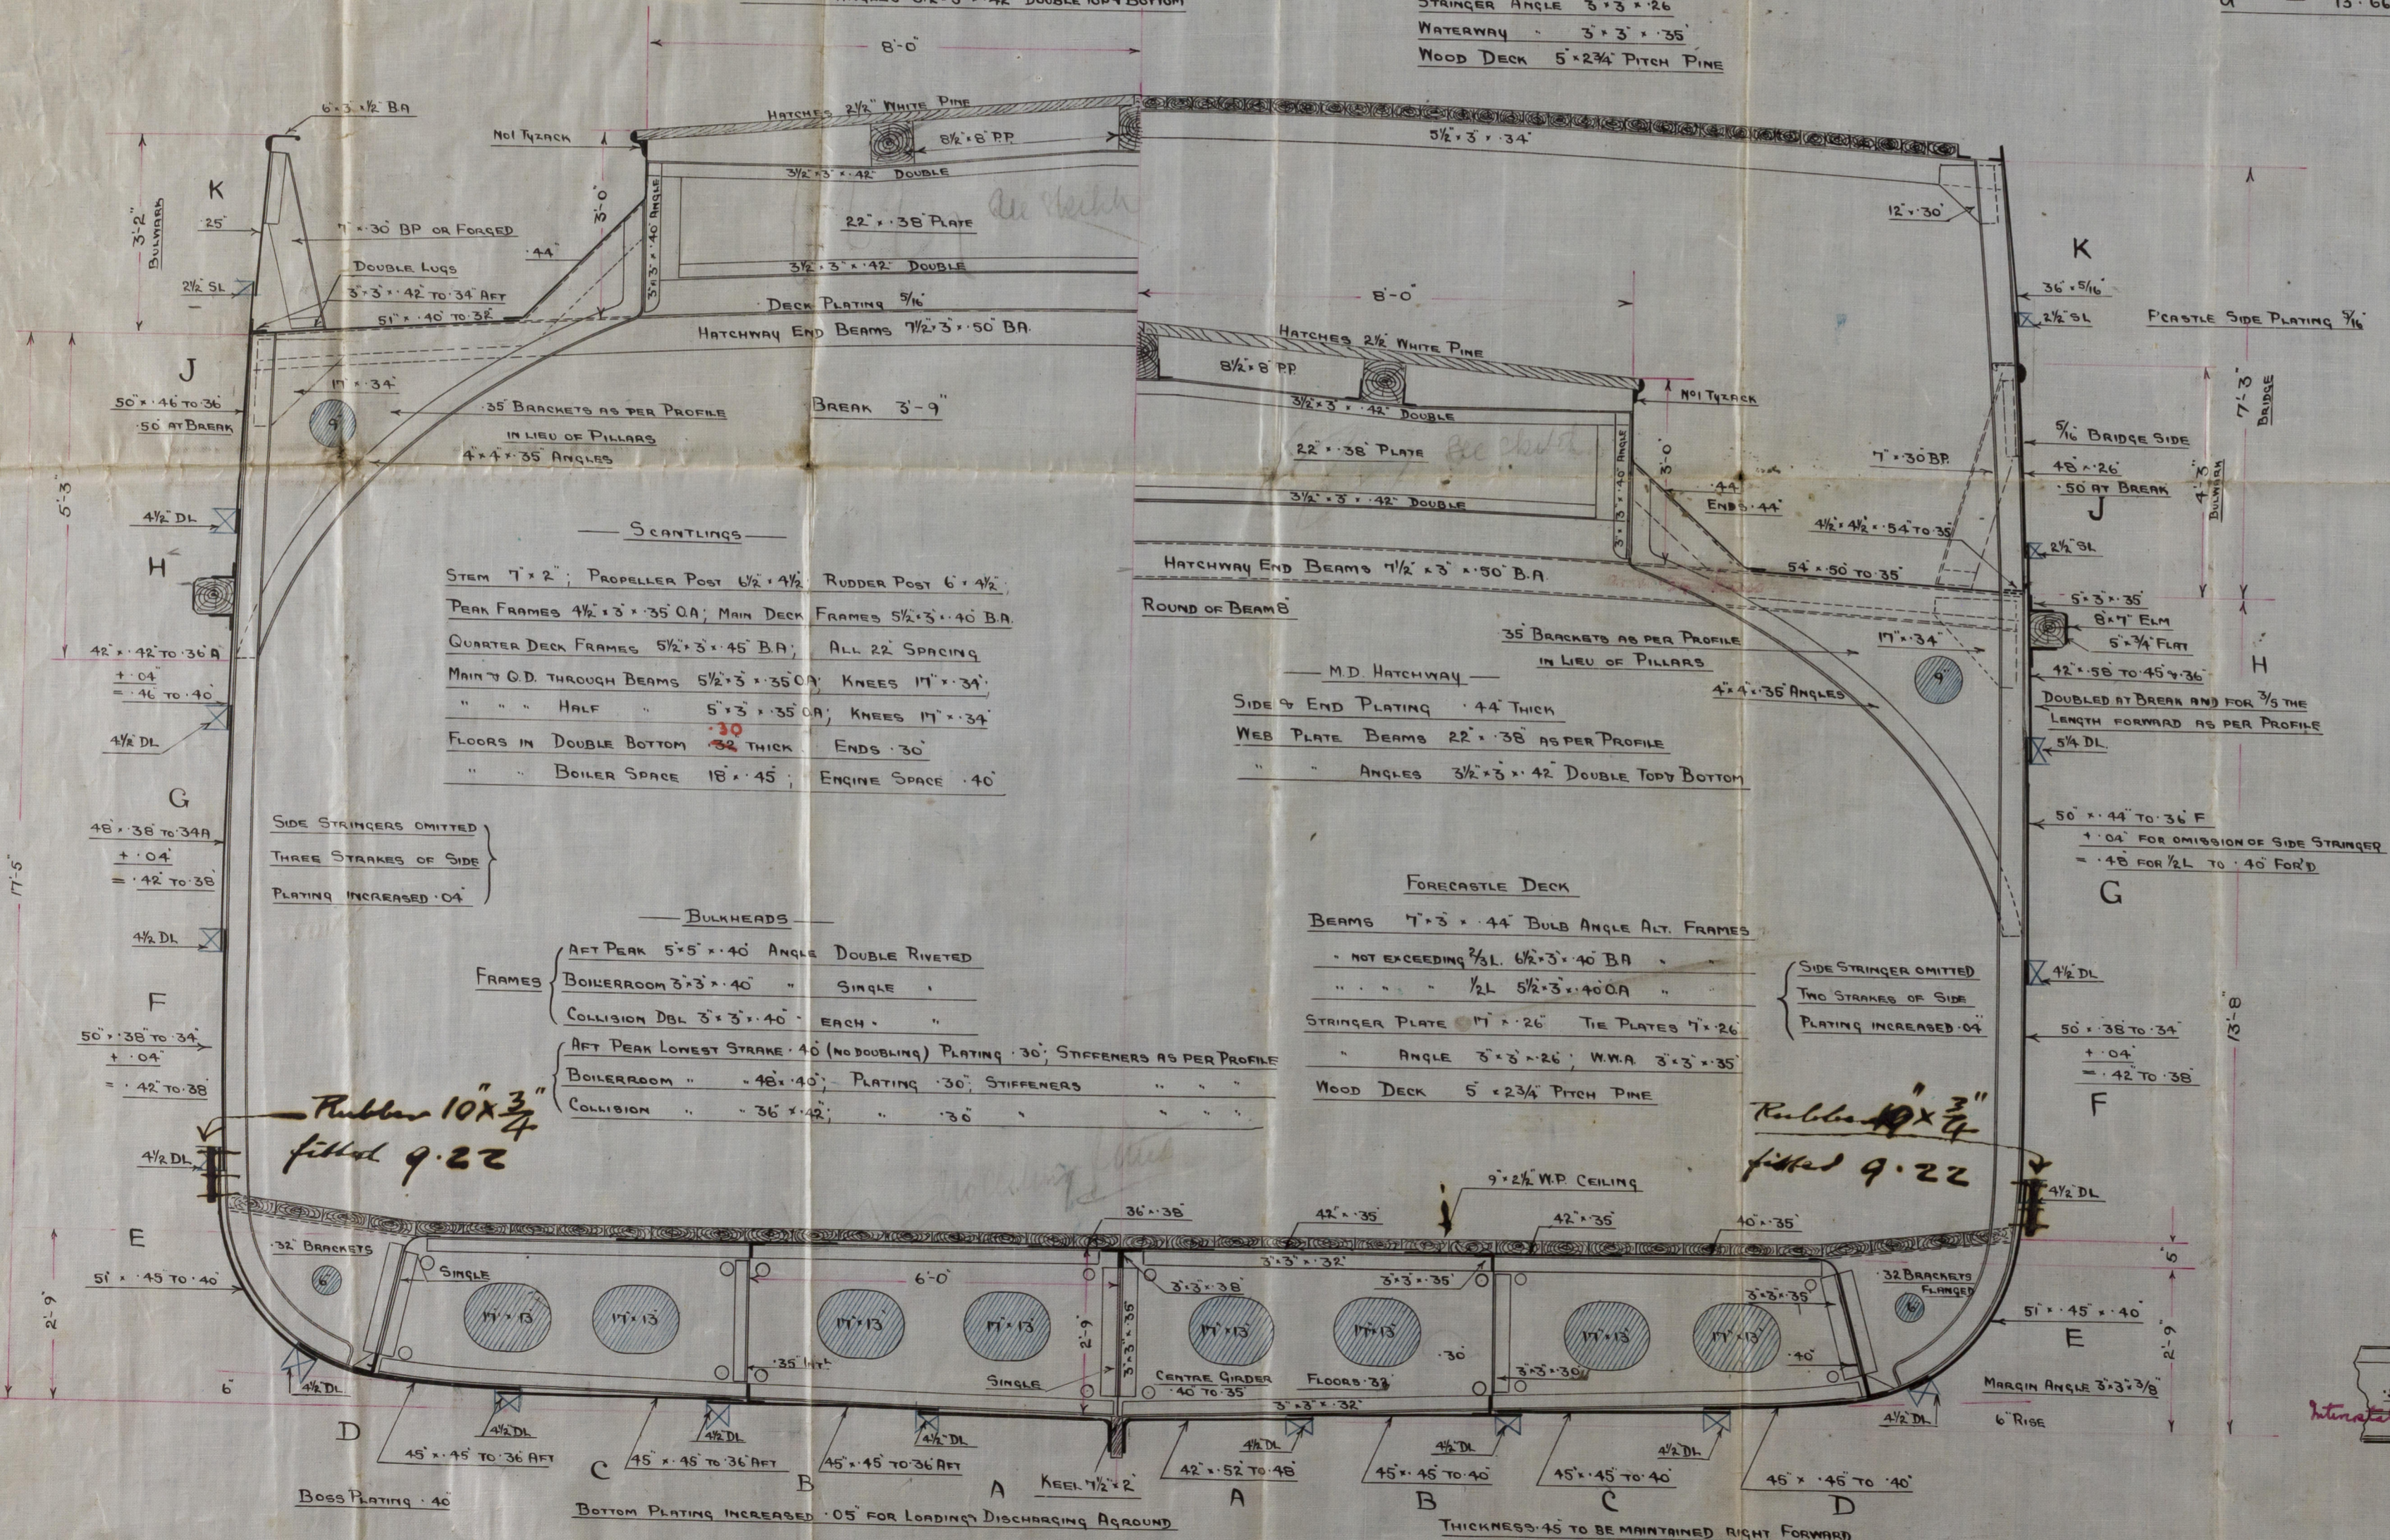

BUILDERS Forth S/B & Eng Co Ltd

Jeffrey's Yard

YARD NO. 29

PLAN Mid Section & Hatch

Profile & decks, Stern frame  
Strengthening forward, Pumping

SHIP'S NAME, SS "Catherine"

GLASGOW REPORT NO. 3854


A.S. 28.29  
Ship Section  
Messrs A. Jeffrey & Co

Alva

"Catherine Anna"  
or "Was Cam"  
Stk 15523

Catherine Annie No 29  
how-Barnickmaer

SALLY HENRY

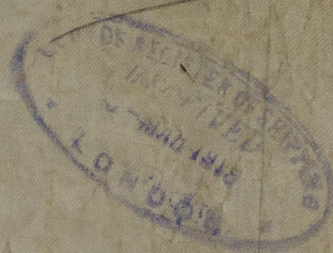

© 2020

Lloyd's Register  
Foundation

002515-002521-0002