

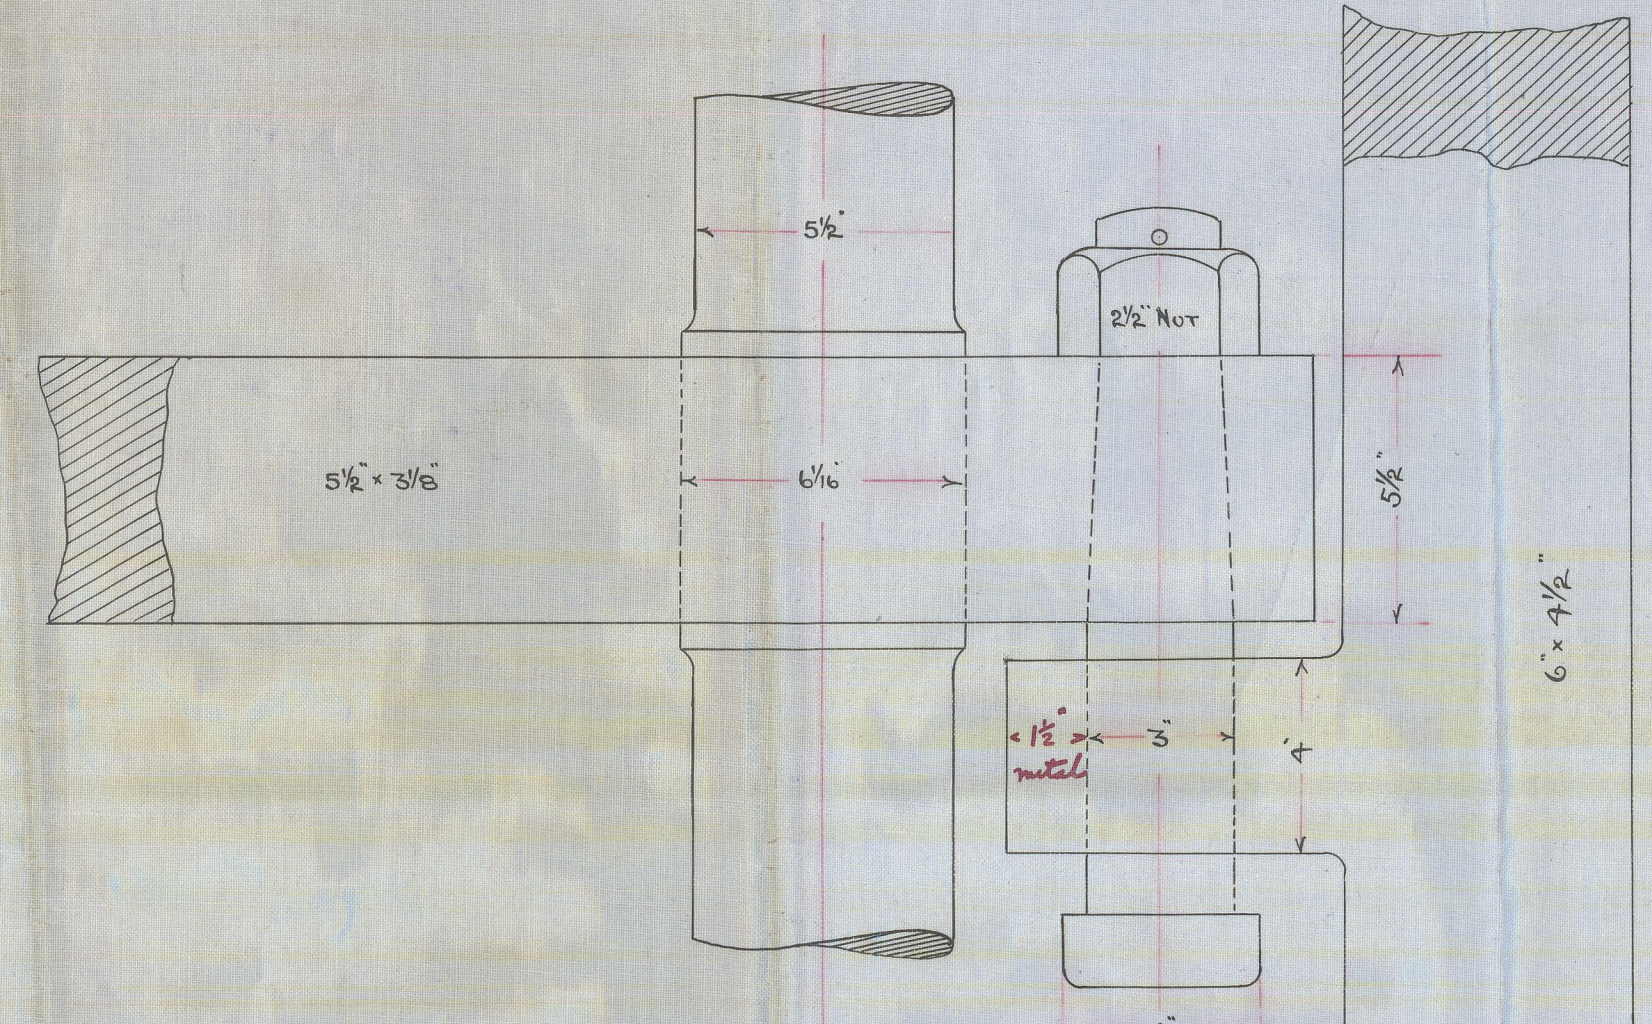


24/10/17

SS Nos 28 & 29
 Sternframe & Rudder
 A. Jeffrey & Co. Ltd.

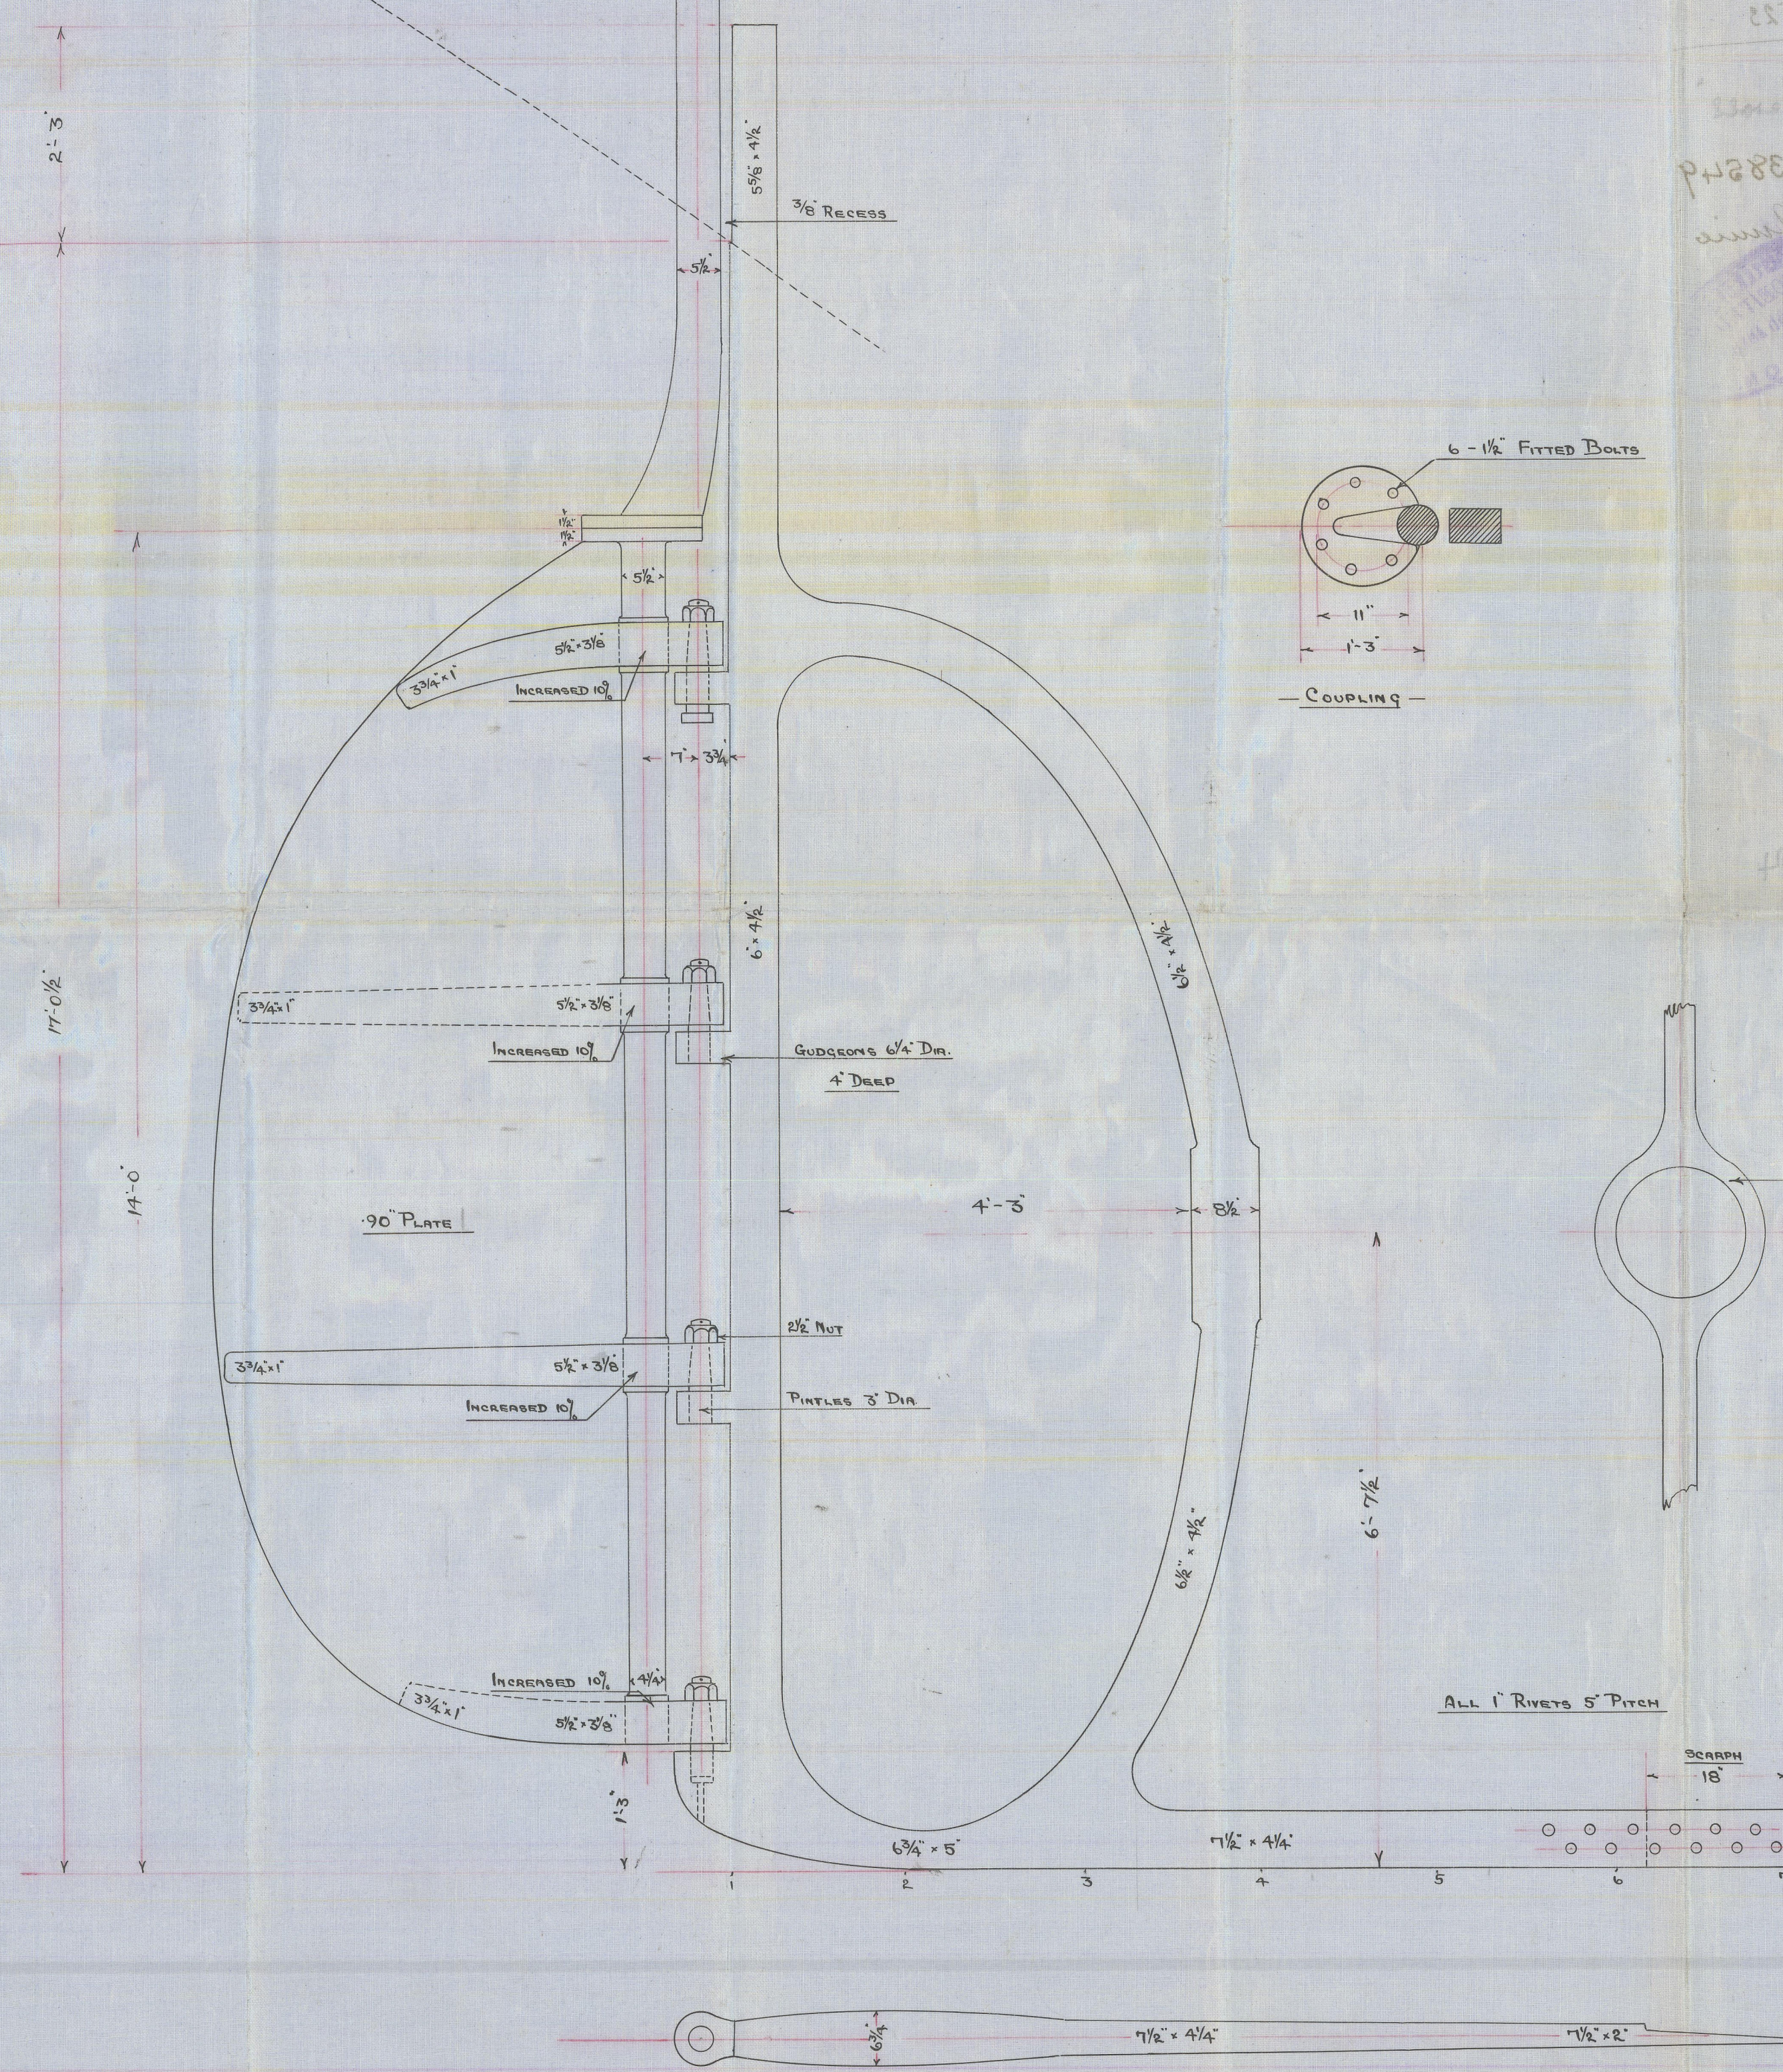

DETAIL OF UPPER ARM, PINTLE & STOPPER
 ALSO STOPPERS ON DECK

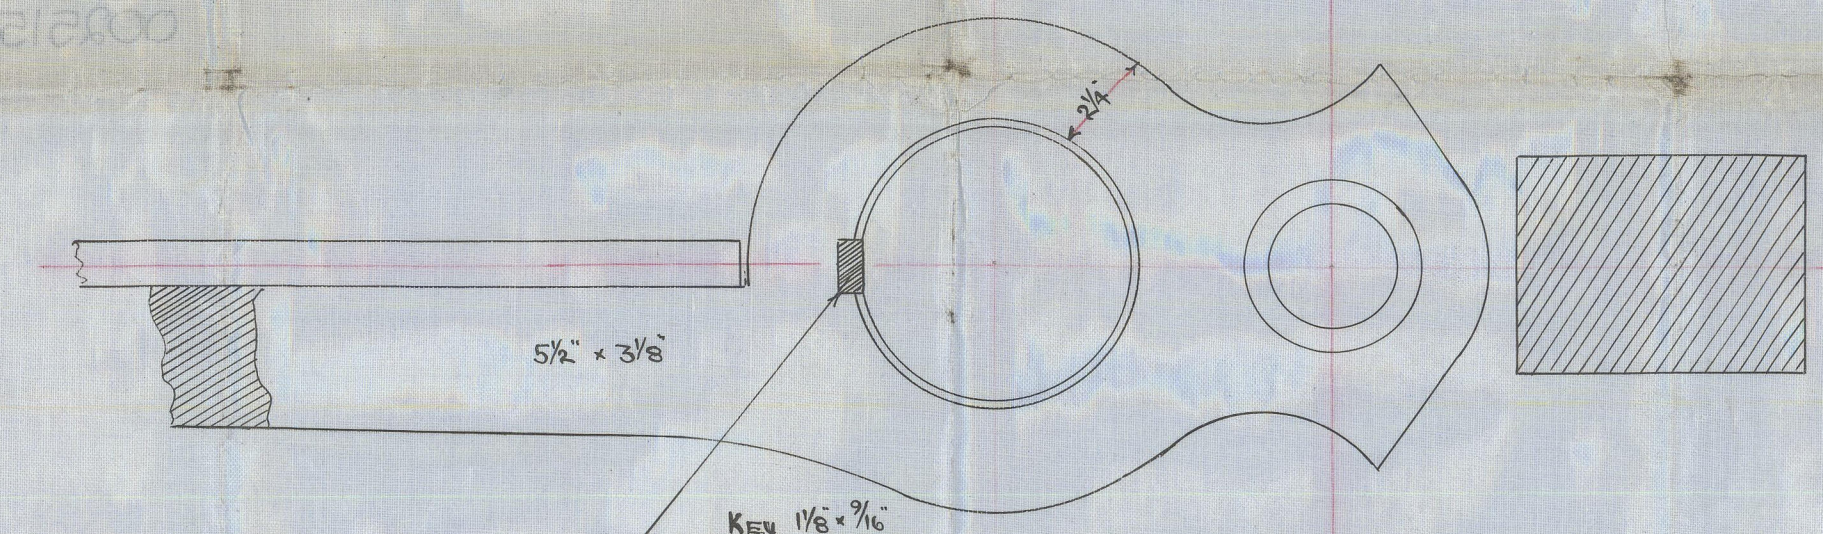

A	ACTUAL AREA OF RUDDER ABOUT CENTRE LINE OF PINTLES	4'1.2 SQ FT
D	CENTRE OF GRAVITY " " " "	2.44 FT.
A x D	115.0	DIAMETER OF RUDDER HEAD 5 1/2" SCANTLING'S ABOVE RULE SIZE
SPEED NOT EXCEEDING 10 KNOTS		

SS Nos 28 & 29
 STERNFRAME & RUDDER
 SCALES 3/4" & 3" 1 FT.

24.10.17

A.S. N^o 28.29

Merri Frame Rudder

Mem A. Jeffray & Co
Glasgow


By ~~BANKRUPT~~
Catherine Aida
ex "Was Cam"

Lib 15523

now
Barwick & Co

GLASGOW REPORT No 38549

3/5 Catherine Annie

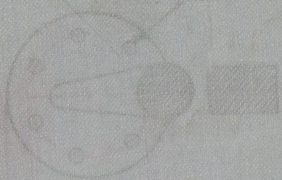

© 2020

Lloyd's Register

002515-002521-0004