

## Lloyd's Register of Shipping.

Ship's Name

S.S. "Bolbec".

Official No.

/42265.

Memorandum of alterations reported since ship was surveyed for assignment of Load Lines in Port Talbot. 11<sup>th</sup> August 1932.

No 1 Hatch. Increased in length 12" forward and covering plate sloped as per sketch. Dimensions of hatchway 26'-2" x (23'-7" x 16'-2" x 17'-5" breadth.) The forward hatch beam is now fitted with double 6" x 3 1/2" x 50" B.A.s as bottom bars.

4" x 3" x 36"  
15 1/2" x 36"  
6" x 3 1/2" x 50" B.A.s ✓

3" wood hatch covers, cleats, bolting bars etc fitted as per rule requirements for forward bay of hatchway. Covering plates 45".

F'dle Front.

Steel plating suitably stiffened by 3" x 3" x 36" angles 2'-6" apart. Hinged wood door fitted opening from both sides. Size 5'-0" x 24" x 2" thick - 19" ribs.

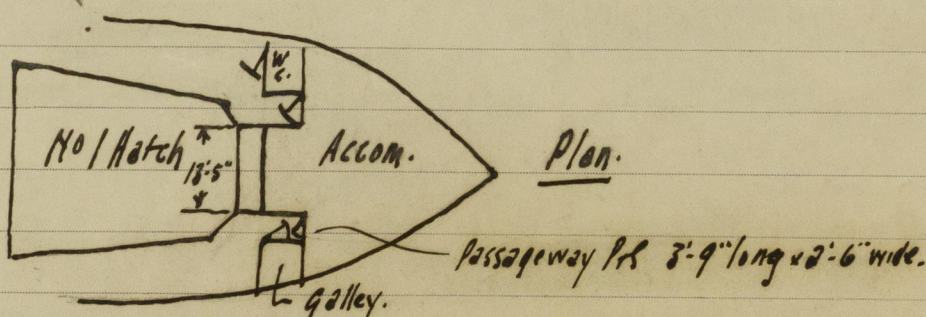
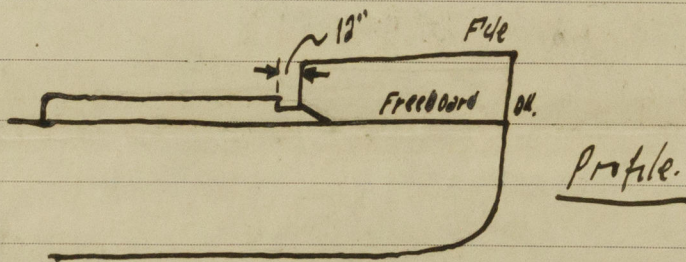


Image figures are being revised by S.O.T and will be forwarded in due course.

To await particulars

of new figures for cargo

2/12/37

J.H. Roberts.



© 2020

Lloyd's Register  
Foundation