


Lloyd's Register of Shipping.

Ship's Name "BOLBEC"Official No. 142265

Memorandum of alterations reported since ship was surveyed for assignment of Load Lines in _____

The freeing ports on this vessel have been found altered as below, port & starboard.

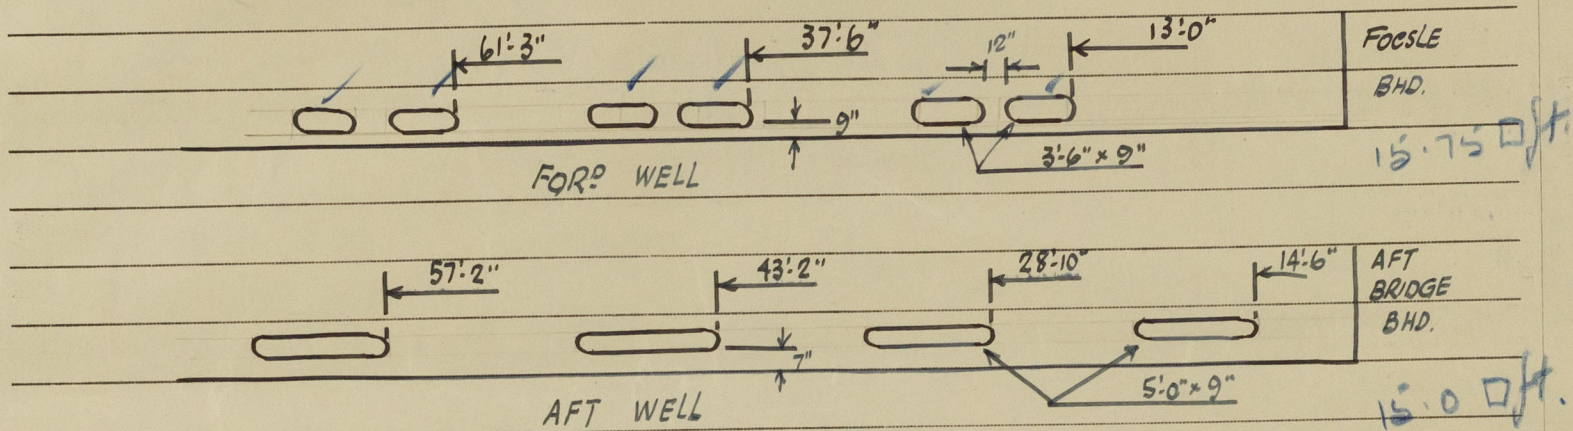

MacLeod

GRIMSBY. 27th July, 1949.

27 JUL 1949

3/6



© 2020

Lloyd's Register
Foundation