


Lloyd's Register of Shipping.

15 JAN 1945

Ship's Name "EMPIRE WORDSWORTH" Official No. 169027

Memorandum of alterations reported since ship was surveyed for assignment of Load Lines in September 1942

Now done, chain locker enlarged by extending bulkheads to forecastle deck.

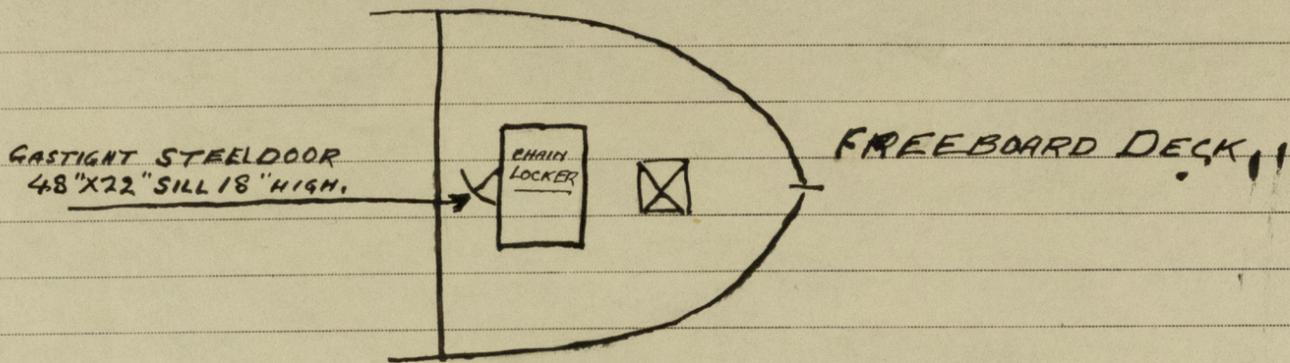

Alex Ewing.

Noted
15 JAN 1945
J.P.S.