


LONGITUDINAL SECTION AND DECK PLANS

SCA | $e \frac{1}{8} = \text{ONE FOOT}$

Class 100A-1. With foreboard (Corresponding to a Modified Draft of 20'3")
"Lower Decks for Fruit Cargo"

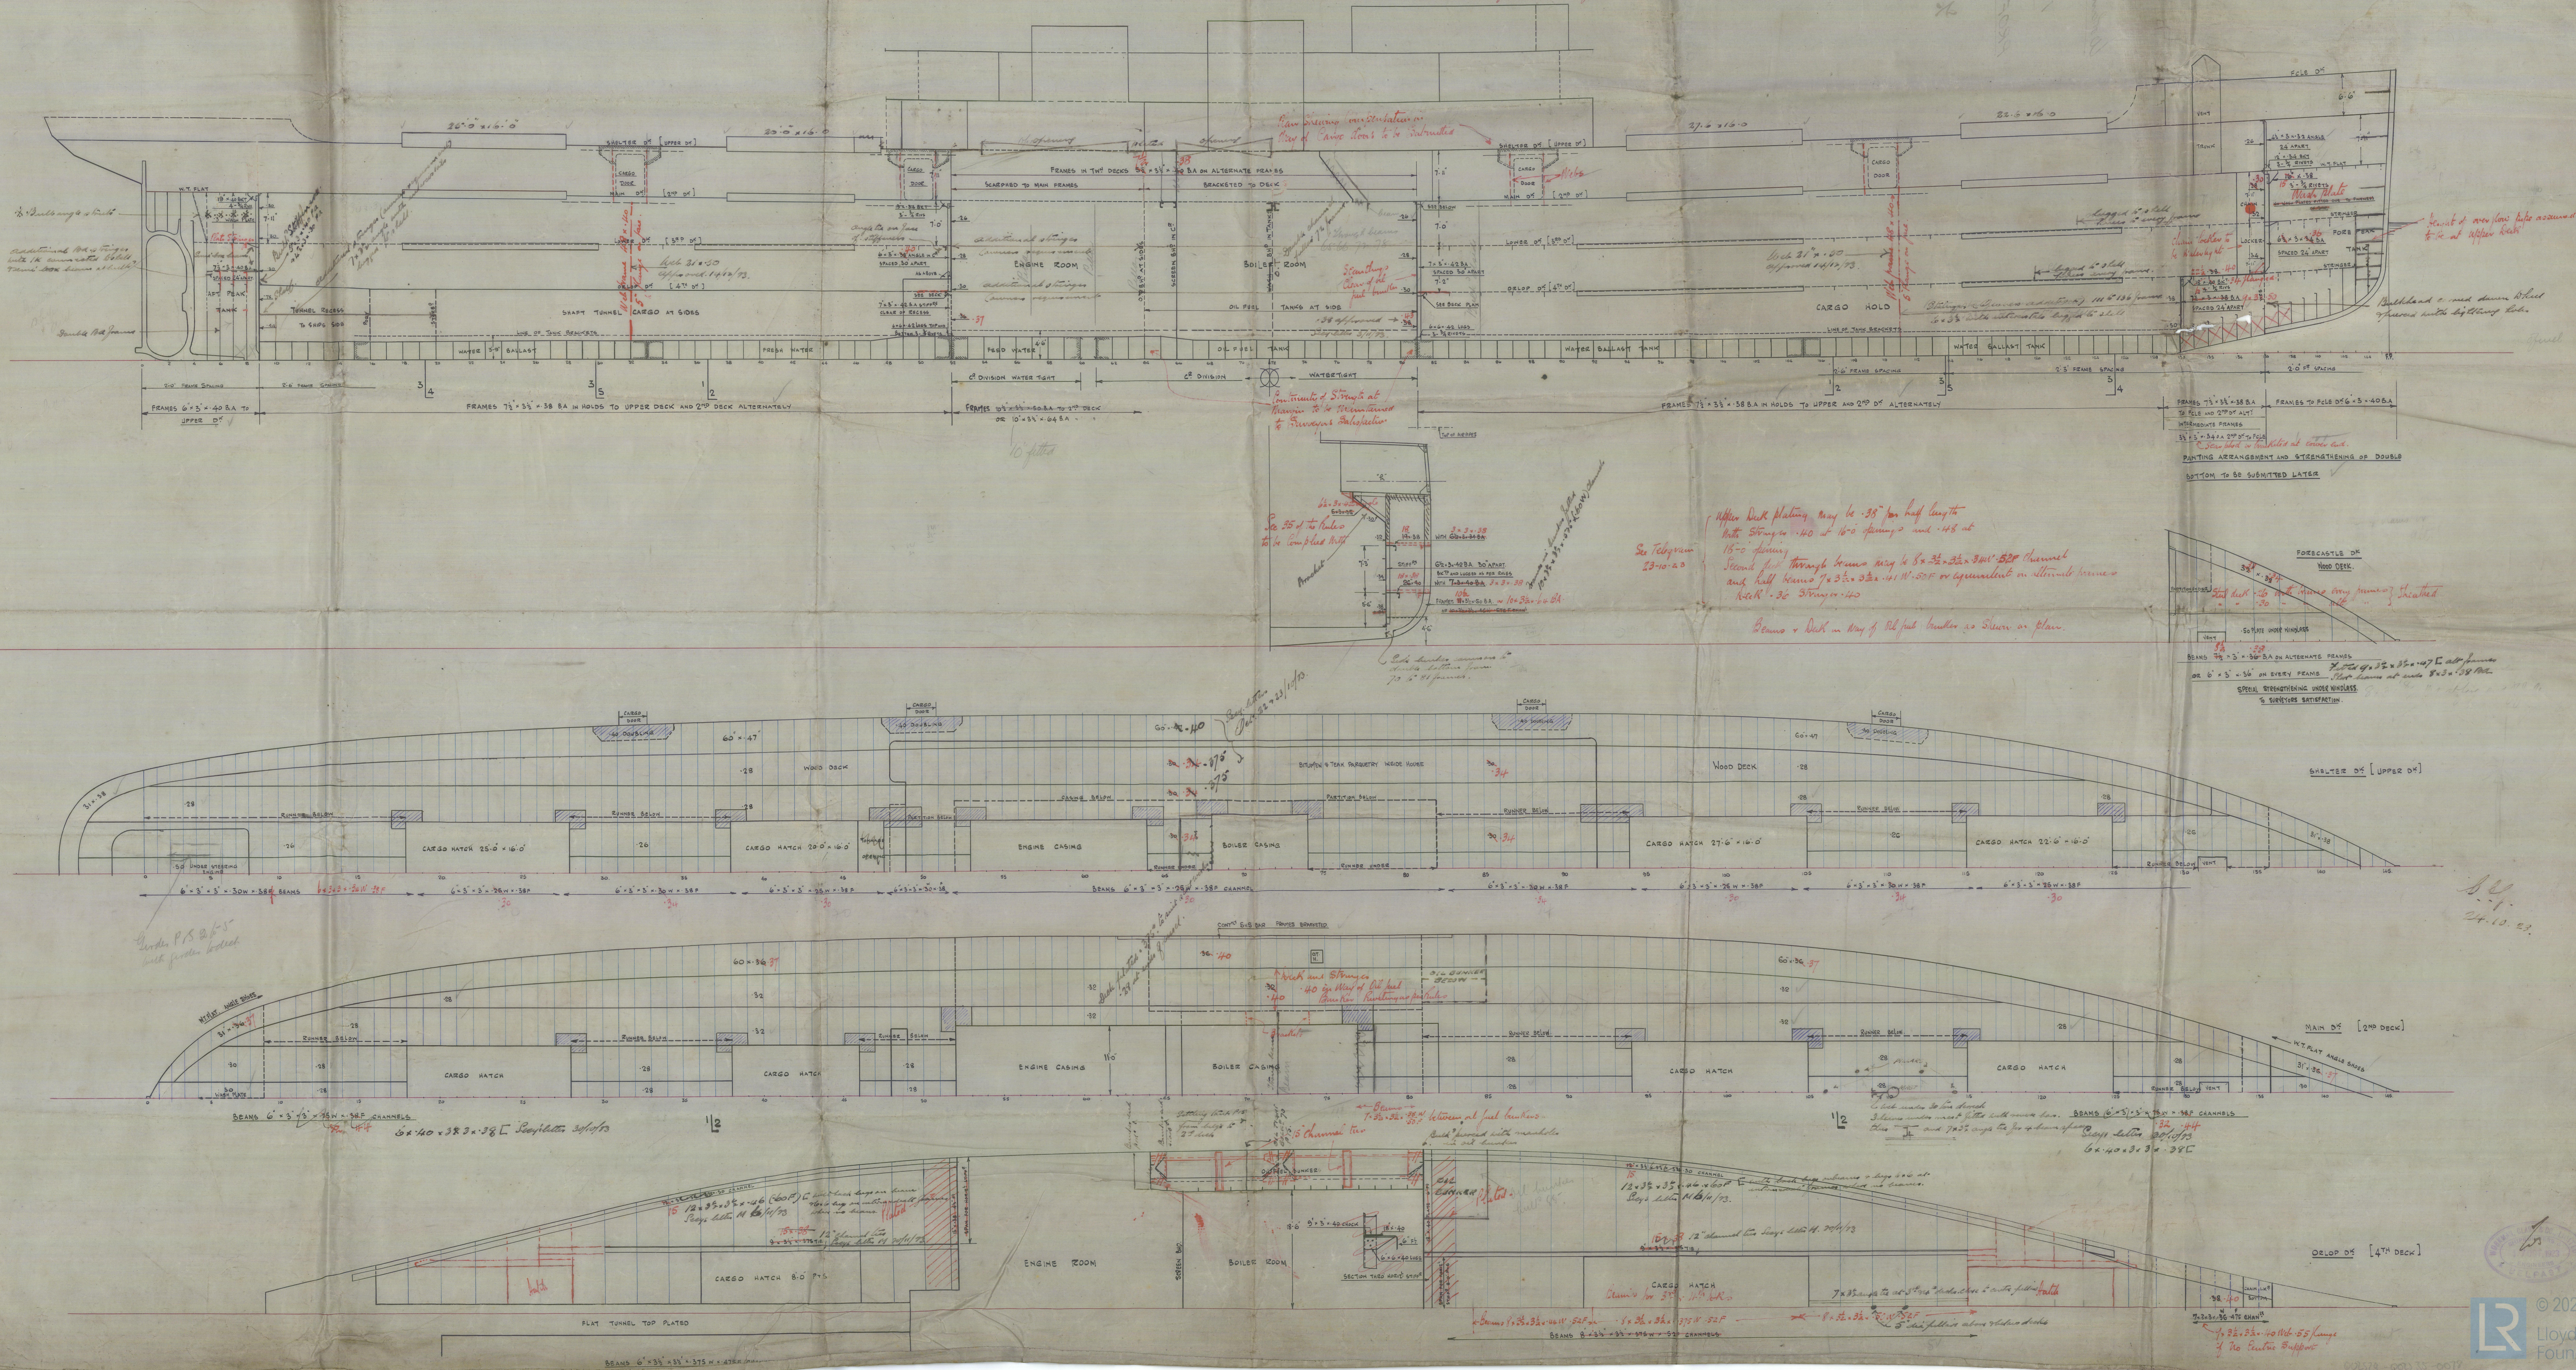

Workman Clark & Co. Ld.
Belfast

No 472

PROFILE
&

DECKS

Y. Atlantic
Bel 9122



© 2021

Lloyd's Register
Foundation

001529-001535-001540