

DIMENSIONS:- 199'-10" x 31'-0" x 15'-6" M^{LD}

CLASS:- 100 A.I LLOYDS.

SCALE $\frac{1}{2}" = 1 \text{ FOOT.}$

Pl. 271 Owing to the impossibility of securing certain
of the material sections shown on this plate
the size next above has often to be taken
in lieu thereof.

See Section of vessel as built.

~~D~~ = m. C. h.

28. 12. 18

LYOIDS NUMERALS.


BREADTH	M ^{LD}	31'0	✓
Depth	"	15'5	
<u>TRANSVERSE NUMBER</u>			
LENGTH	SP	199'83	
<u>LONGITUDINAL NUMBER</u>			
D TO MAIN DECK			12'96
D - QUARTER			16'96
% - MAIN			12'89
% - QUARTER			10'24

EQUIPMENT NUMBER.


LONGITUDINAL NUMBER		9292-09
QUARTER DECK	139'33 x 4	557'32
FORECASTLE	20'38 x 65'x 75	113'50'56
BRIDGE & B. CASINGS	54'75 x 7'x 5	269'12
<u>EQUIPMENT N^o</u>		10159-06
		1024-04

EQUIPMENT (LETTER C)

R BOWER ANCHORS	2 1/4 CWTs (STOCKLESS))	COLLECTIVE WEIGHT
J "	10 "	60 1/2 CWTs
1 STREAM	5 1/4 "	(EX STOCK)
1 KEDGE	2 3/4 "	(" ")
210 FATHOMS	5/8" STEEL CHAIN CABLE (MIN WEIGHT)	(CWTs OR LBS)
60 "	3/4" STEEL WIRE	1203 " 0" 10
90 "	3 "	TOWLINE
90 "	6" HAWSER	
90 "	5" WARP.	

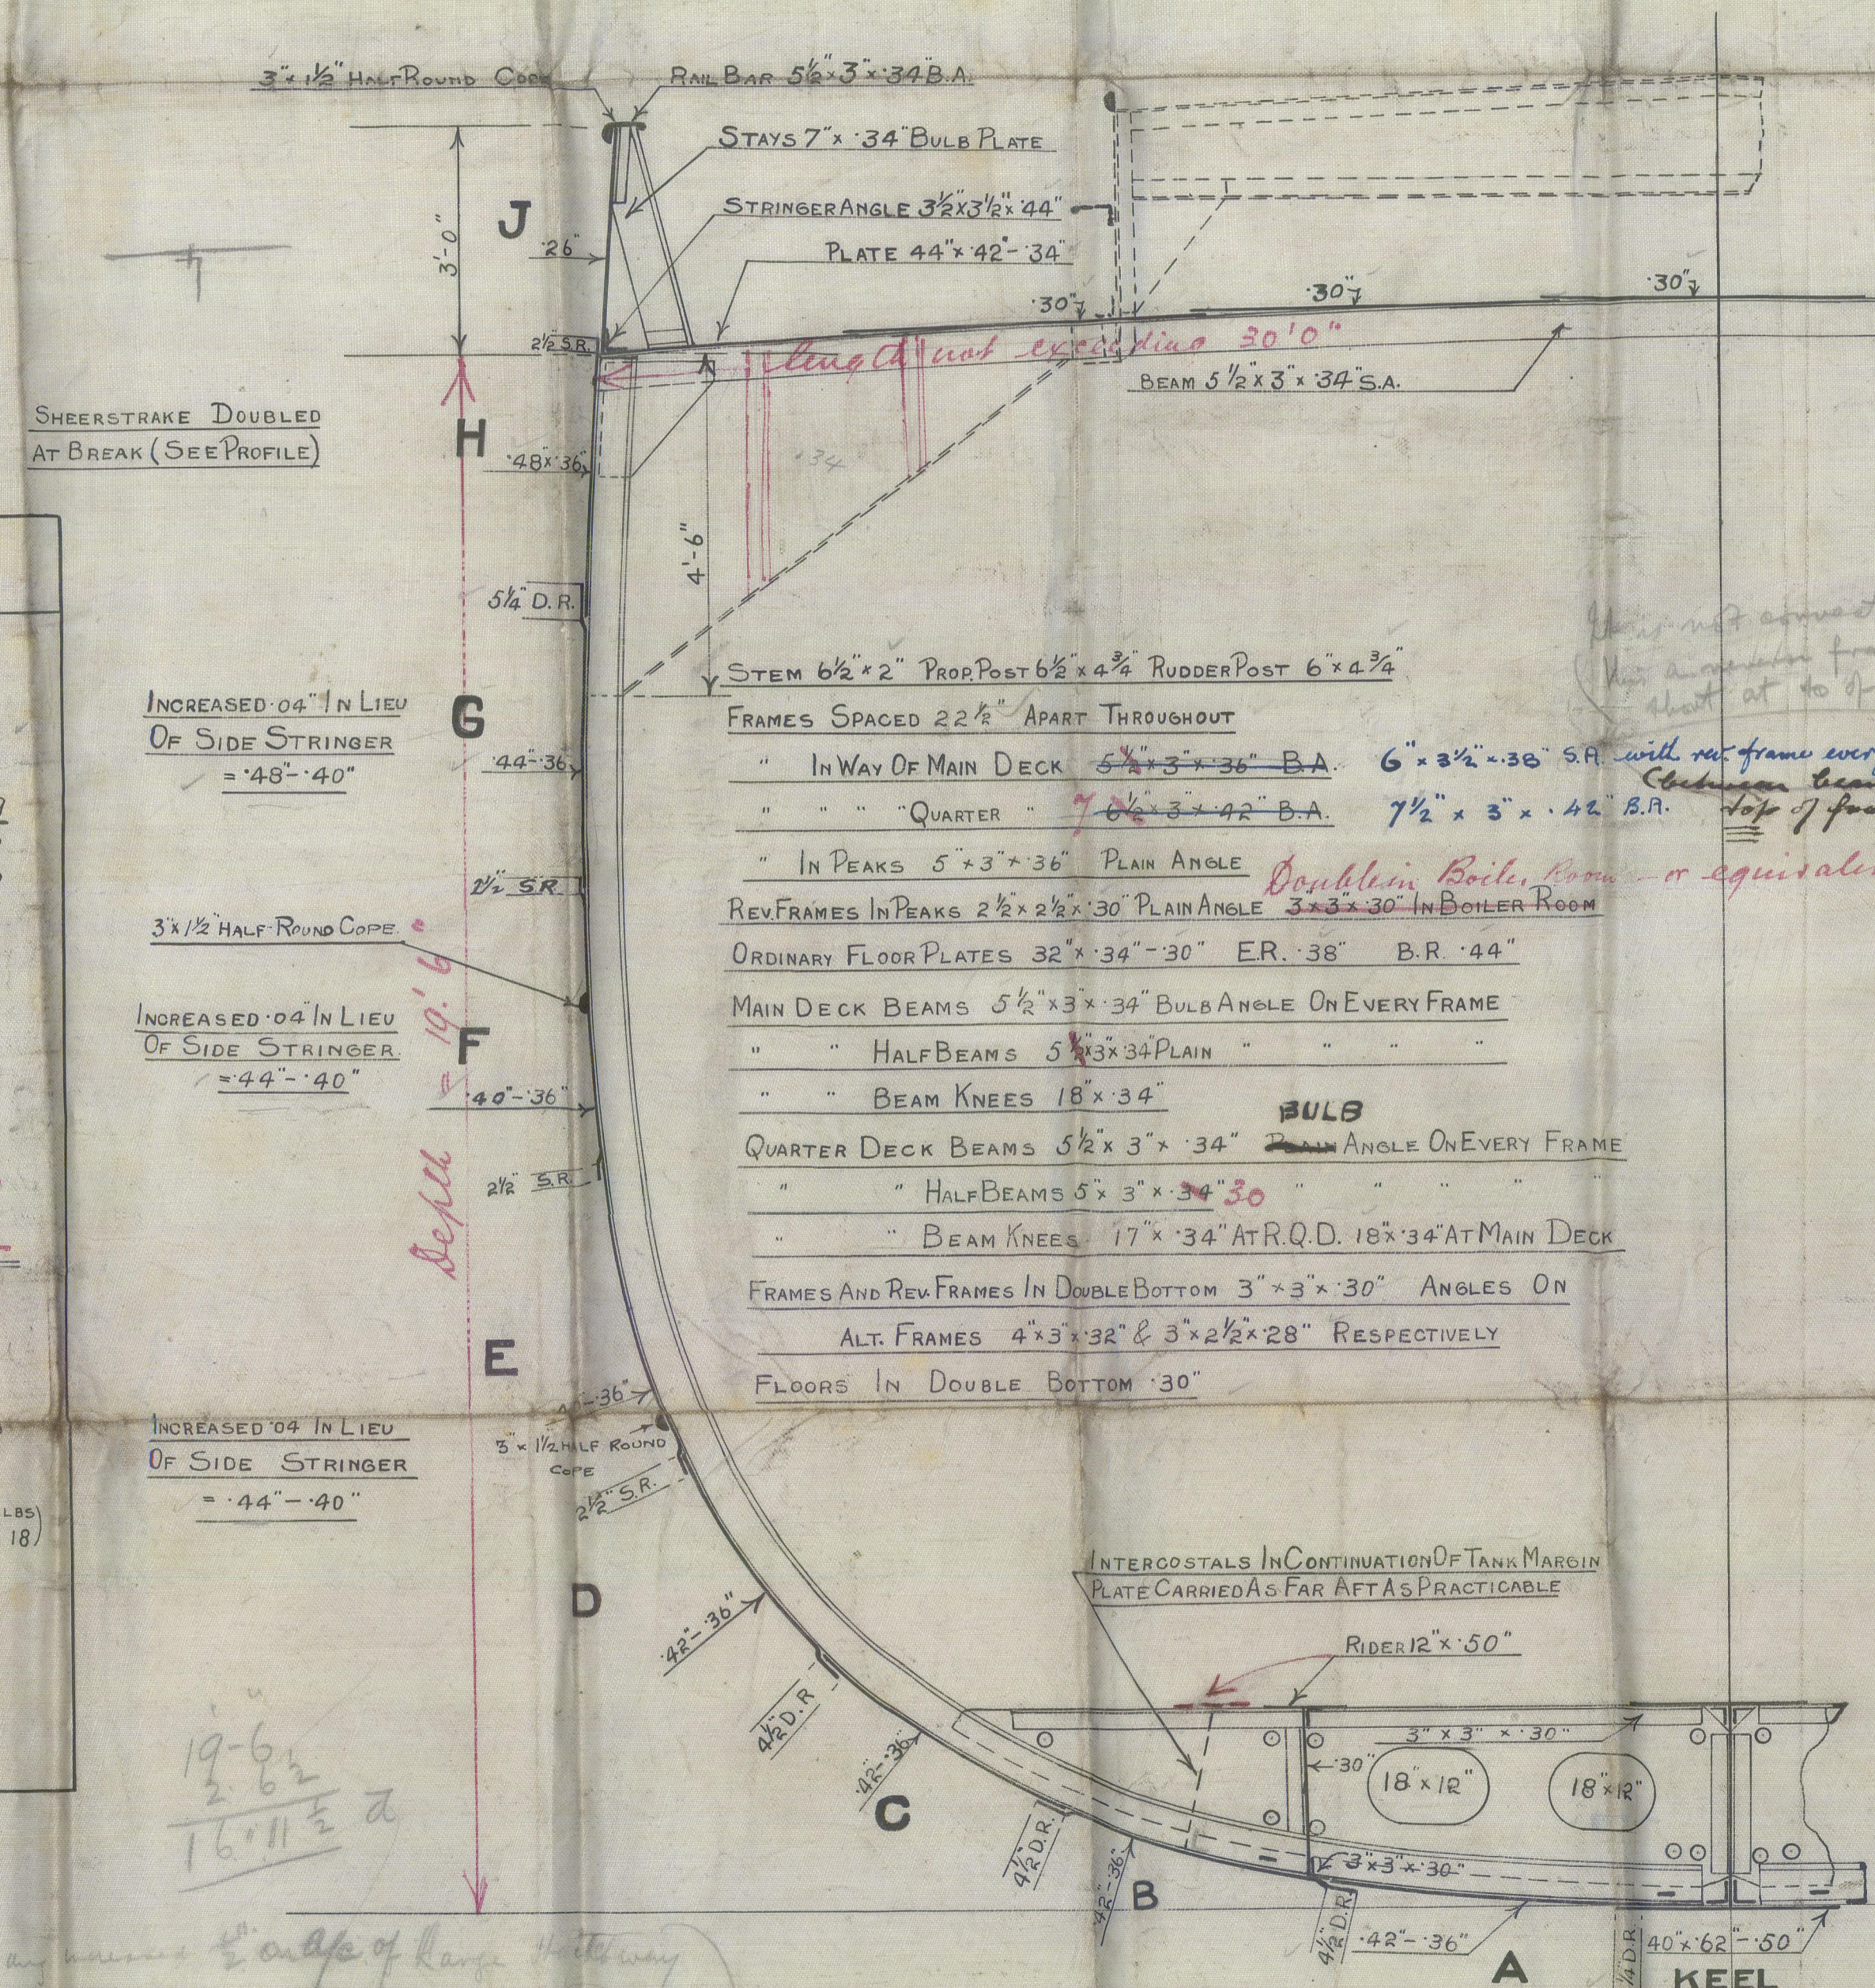

SECTION IN WAY OF ORDINARY FLOORS

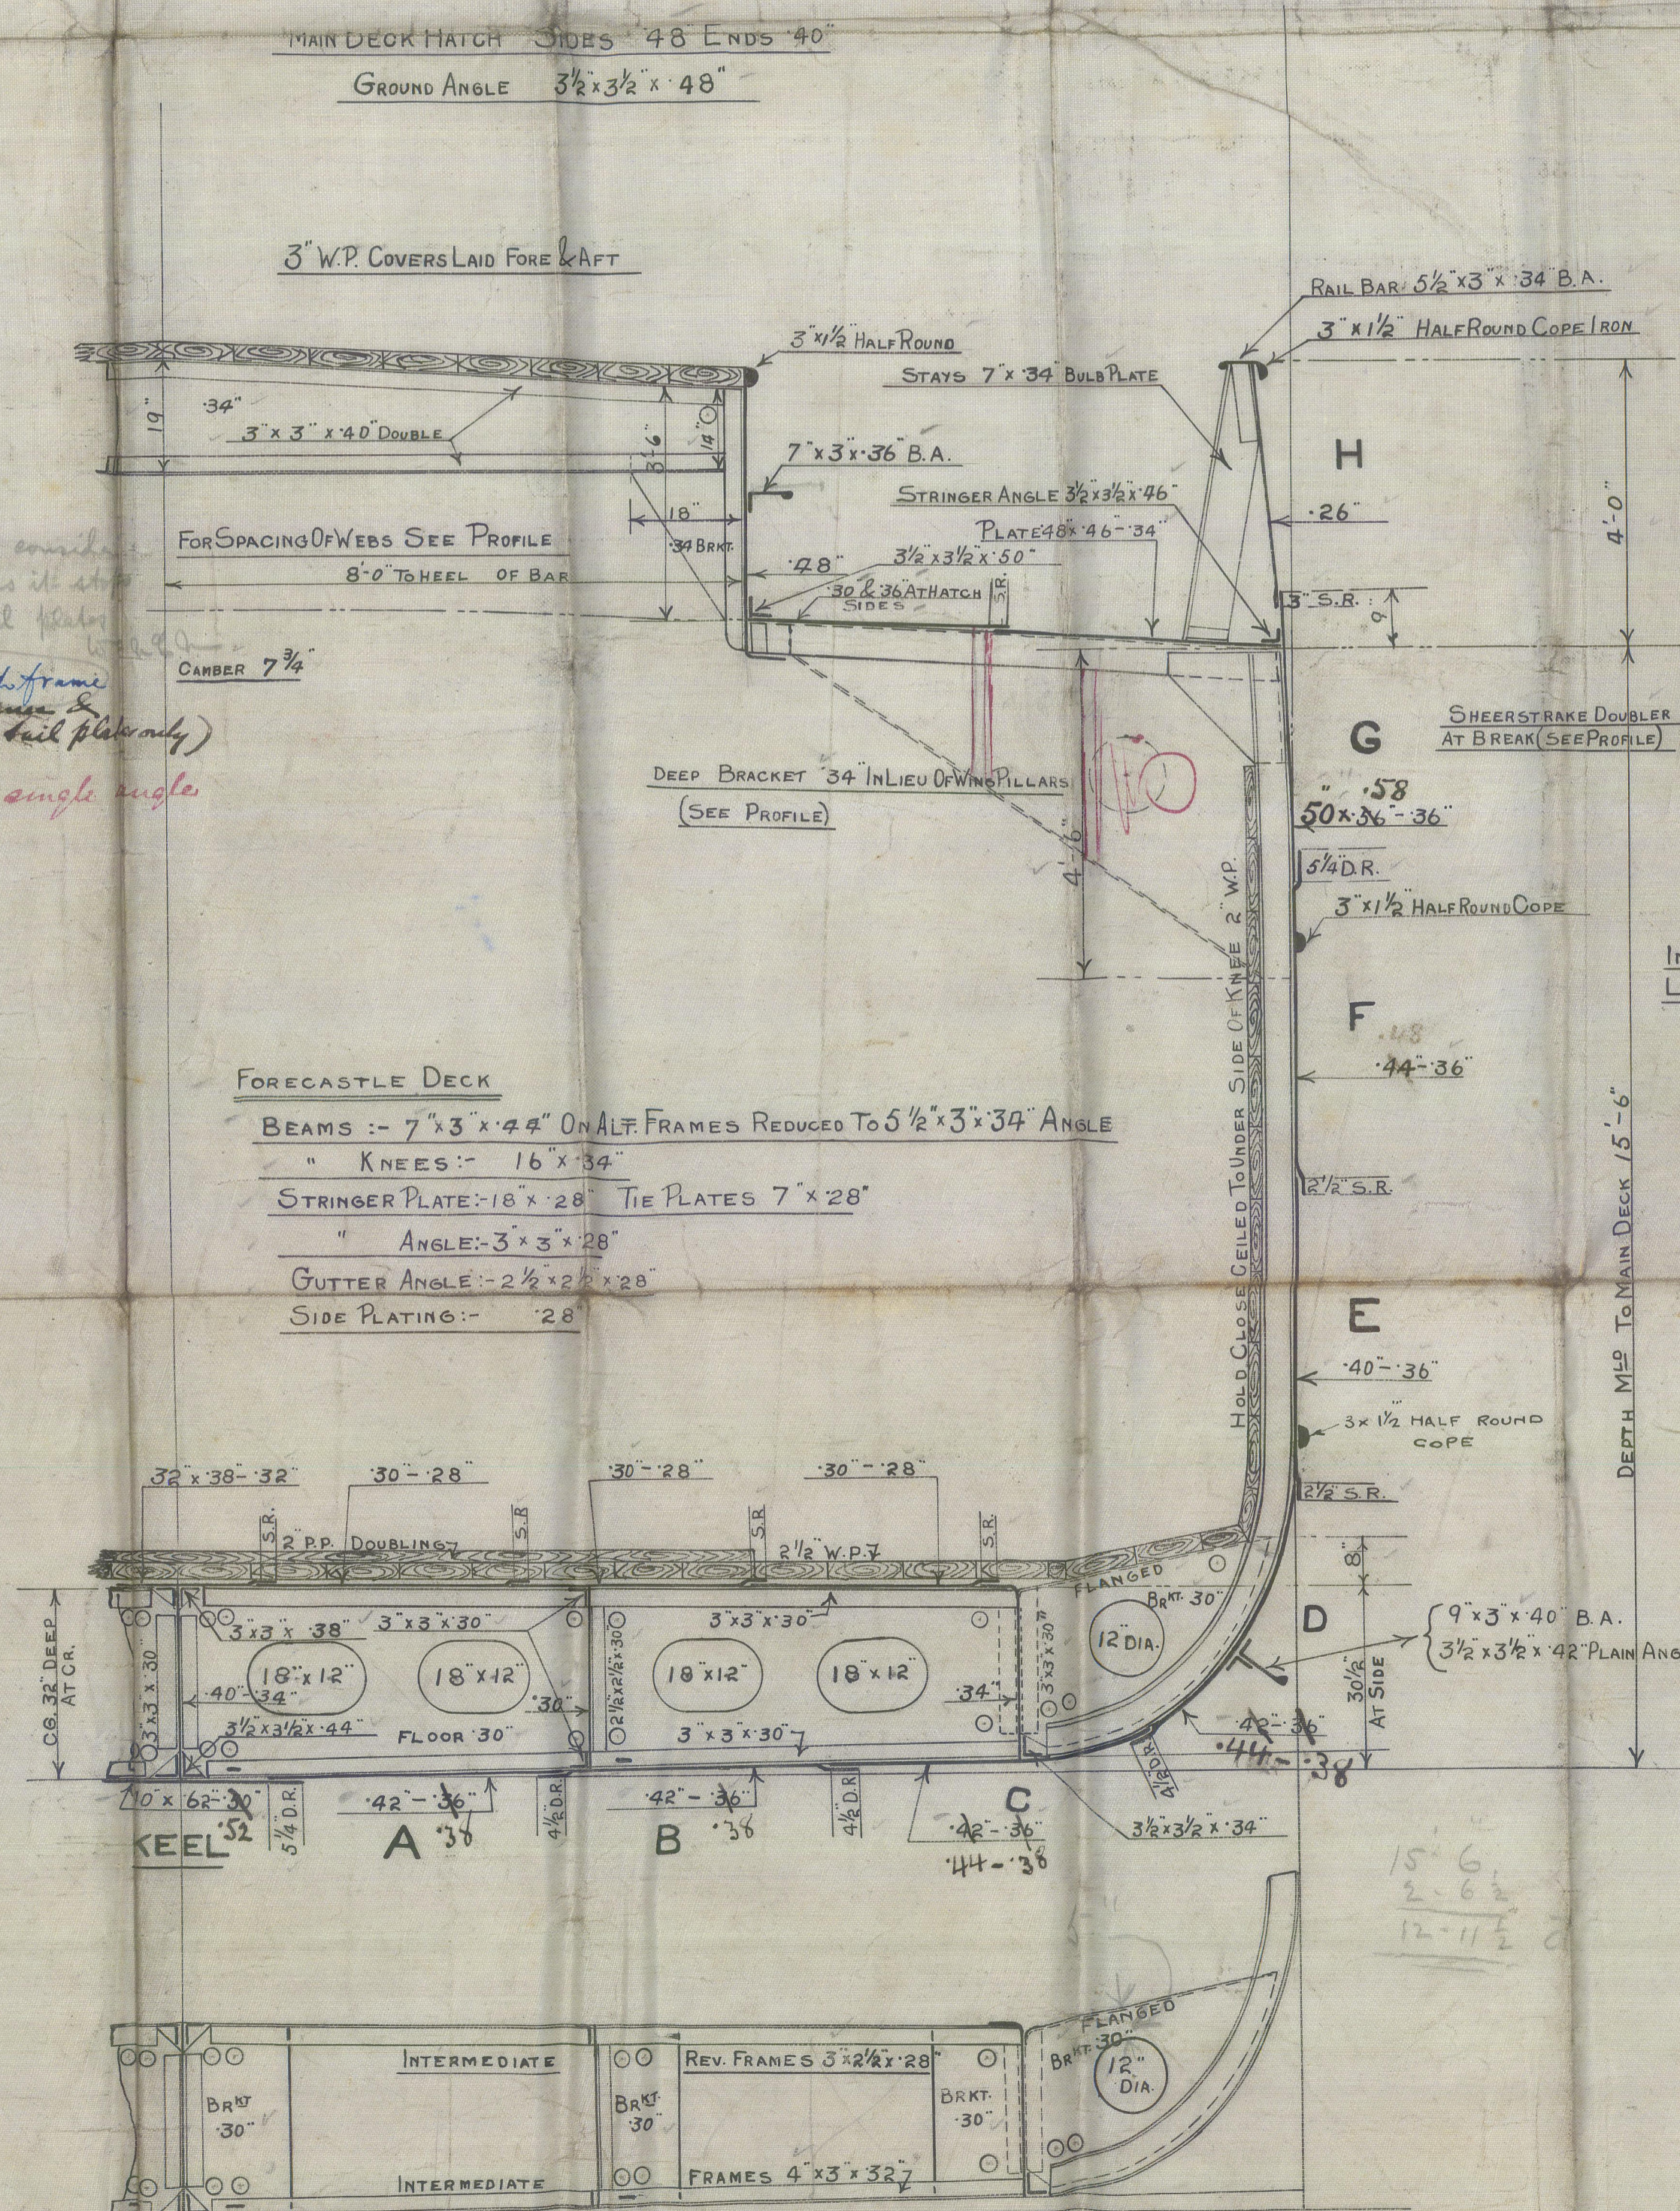

FLOOR ON ALTERNATE FRAME -

<u>RIVETING TABLE</u>	
BUTTS OF SHEERSTRAKE, STRAKE BELOW & STRINGER PLATES FOR $\frac{1}{8}$ " L.A.M. ^d .	T.R.
" " FLAT KEEL PLATES THROUGHOUT	T.R.
" " CENTRE GIRDER IN DOUBLE BOTTOM	T.R.
" " OUTSIDE PLATING FROM UPPER TURN OF BILGE TO STRAKE BELOW SHEER	D.R.
" " " " KEEL TO UPPER TURN OF BILGE	T.R.
" " STRENGTHING STRAKE BELOW & STRINGER PLATES AT ENDS	D.R.
" " TIE PLATES	D.R.
" " MARGIN PLATES (MIDDLE LINE) STRAKE D.B. FOR $\frac{1}{8}$ " L.A.M. ^e	D.R.
" " DECK PLATES FOR $\frac{1}{8}$ " L.A.M. ^f	D.R.
" " INNER BOTTOM PLATING FOR $\frac{1}{8}$ " L.A.M. ^g	D.R.
" " MARGIN PLATES (MIDDLE LINE) STRAKE IN D.B. AT ENDS	D.R.
" " DECK PLATES AT ENDS	S.R.
" " INNER BOTTOM PLATING AT ENDS	S.R.
<hr/>	
EDGES OF OUTSIDE PLATING FROM KEEL TO UPPER TURN OF BILGE	D.R.
" " " " FROM UPPER TURN OF BILGE TO STRAKE BELOW SHEER	S.R.
" " " SHEERSTRAKE	D.R.
" " DECK PLATING	S.R.
" " INNER BOTTOM PLATING	S.R.

where not
exceeding
42.

Ardrossan D. Sk + S.B. 6^e

S. S Nos 240-1

Midskip Section
(amended)

"Ardgryffe"

EX 34572

St. Dunstan's Hill.

38414

2/3 Portland House

© 2021

Lloyd's Register
Foundation

002529-002532-0191