

Glasgow Rpt. 71118

Rpt. C. 11 (Contd.)

Index No.



Lloyd's Register of Shipping.

116 OCT 1946

Ship's Name ARGORYFE Official No. 142318

Memorandum of alterations reported since ship was surveyed for assignment of Load Lines in

No 2. HATCH ON R. QUARTER DECK.

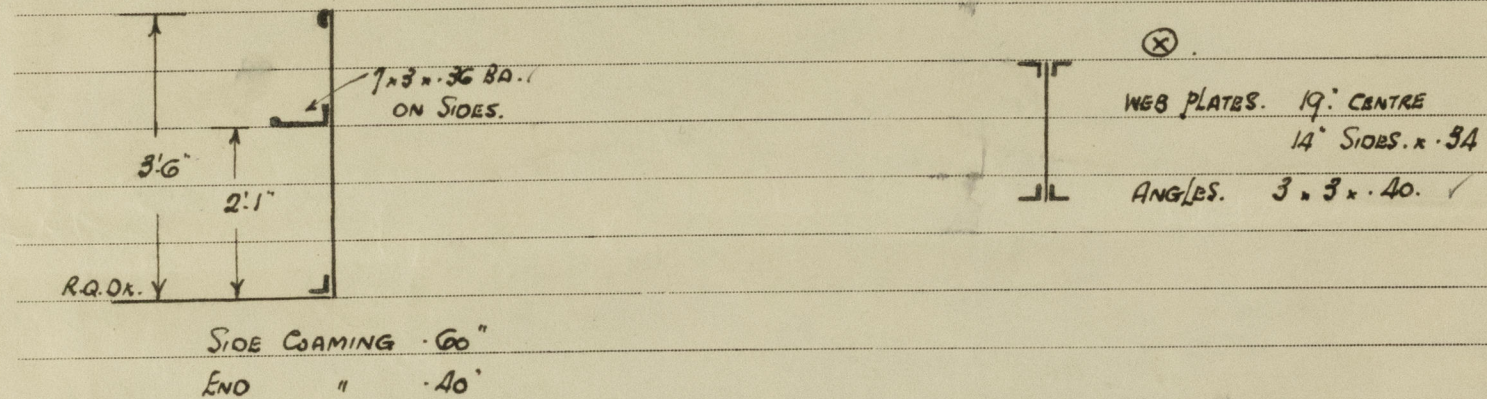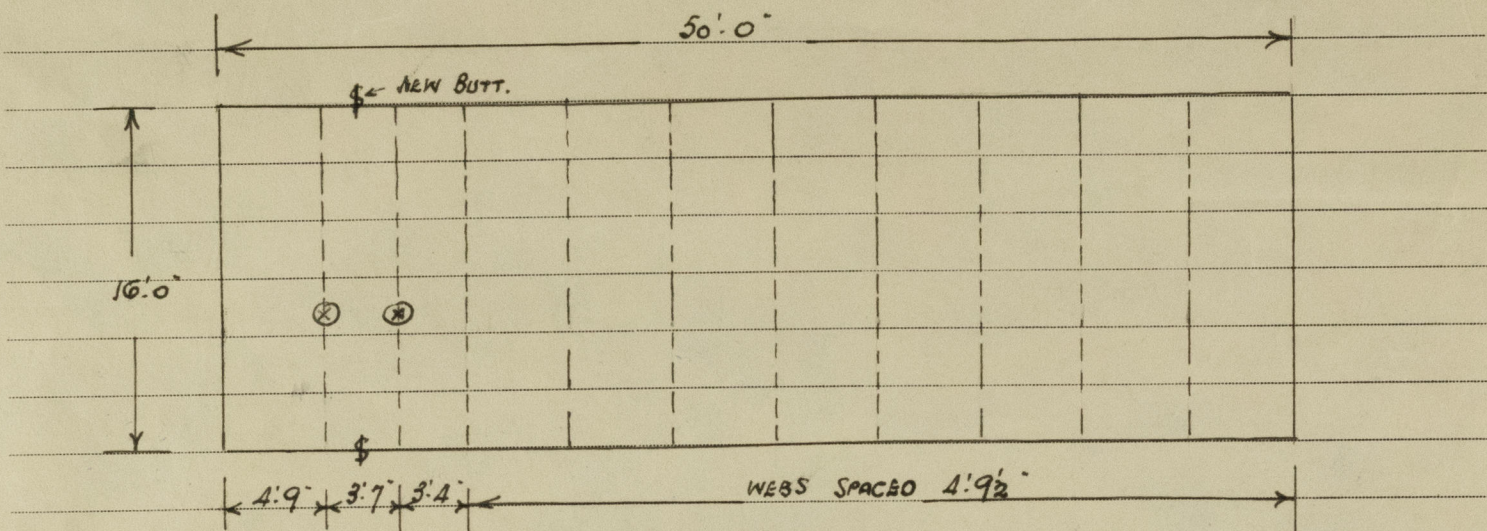

3" W.W. COVERS. FORK & AFT.

CLEATS SPACED 24" APART.

2. TARPULINS. (TO FIT INCREASED LENGTH)

BATTENS & WEDGES SUPPLIED.

H. Berry

W. H. Berry

17 OCT 1946