


6 HOLES 35 DIA.
REAMERED. 240 P.C.D.
DRILL TO JIG.

COPY OF PLAN APPROVED.
in Secretary's letter of 2nd July 1948.
N. F. Q.

7-7-48.

THE NEWBURY DIESEL CO. LTD.
NEWBURY — ENGLAND.

6" F TYPE SIRON. ENG^s 822 & 3.
FLY & THRUST
THRUST SHAFT.
S F
1/2.

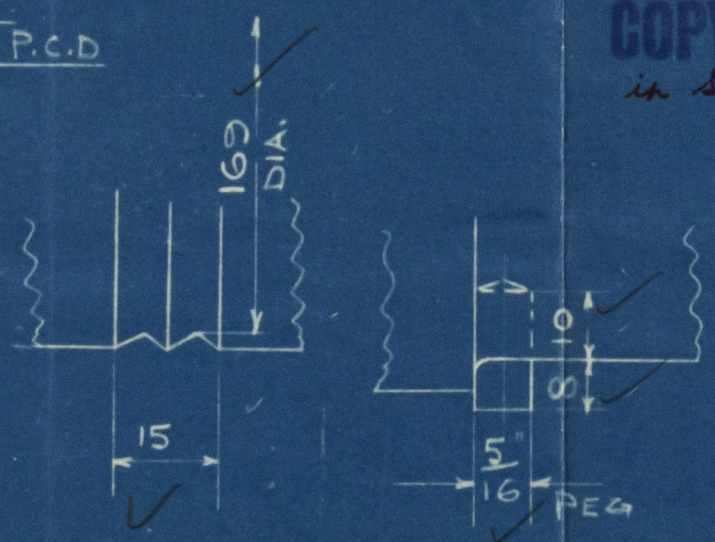

THE NEWBURY DIESEL CO. LTD.	
DATE	12-1-48.
DRAWN BY	F.G.P.
APPROVED BY	
TESTED BY	
CHECKED BY	
DRG. NO.	13521



Newbury Linsell Eng Co. Eng No 122
for M.O. Assiduity
Lon Dpt. No. 116897



© 2020

Lloyd's Register
Foundation

002536-002542-0053