


LIMITS ON ALL DIAMS $\pm .001$

6 HOLES 26 M/M DIA REAMERED
318 M/M P.C.D. TO FIG.
ALL COUPLINGS.

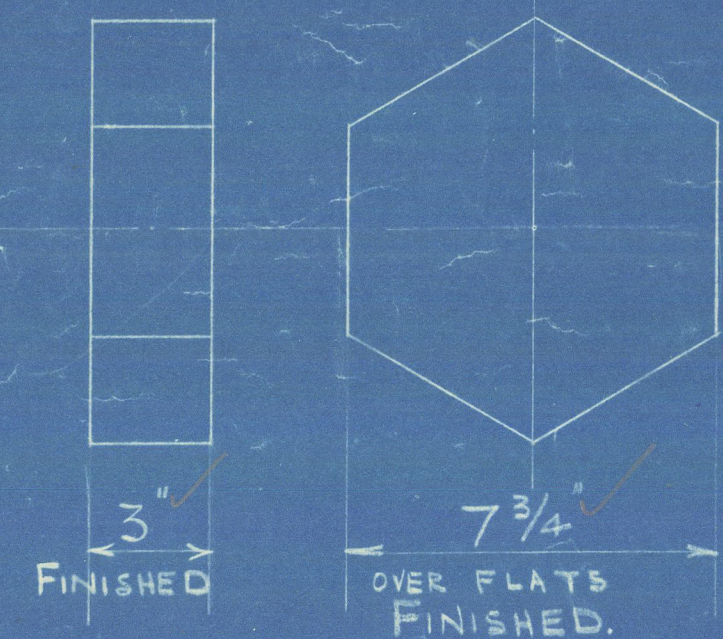

PROPELLER NUT.

M.V. ASSIDUITY (RE-ENGINE)
TAIL 6 INTER SHAFTS

FORGED STEEL TO LLOYDS TESTS & REQUIREMENTS.

SCALE 3" = 1 FOOT.

FINISHED SIZES

COPY OF PLAN APPROVED on 29/6/48
in Secretary's letter of 2nd July 1948.
H. F. A.

7-7-48.

THE NEWBURY DIESEL CO. LTD.
NEWBURY ENGLAND

THE NEWBURY DIESEL CO. LTD.
11-3-48
FGP

© 2020
5945.E
Register
Foundation

002536-002542-0056

Newbury Diesel Eng Co Eng No 822
for new Assembly
Lm Dpt No. 116897



© 2020

Lloyd's Register
Foundation

002536-002542-0056