


51 PROFILE , DECKS.

SCALE :- 1/8 INCH = 1 FOOT

DIMENSIONS: 407'-6" B.P. x 56'-0" B.M^{LD}. x 31'-3" D.M^{LD}. TO UPPER DECK.

AMENDMENTS IN GREEN INDICATE
VESSEL "AS BUILT"
A. Hunter
October 1953

 


Ad
17.5.51

Exord. No. 1244.
(2. 5. 51)

1244

SWAN HUNTER & WIGHAM
RICHARDSON LTD.


1821 "BURMAH SAPPHIRE" ★
PROFILE & DECKS (SHWR Plan)

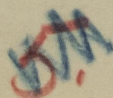

FREEBOARD
NEWCASTLE-ON-TYNE, No. 11015D

➔ BURMAH SAPPHIRE ➔
Newcastle upon Tyne
Report No. 110702
Ship No 1821

RECORDS DEPT..
LONDON

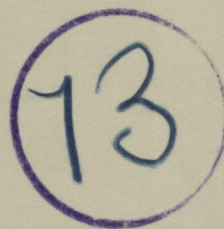

002536-002542-0141



© 2020

Lloyd's Register
Foundation